

W/10/23.

N^o 36

STERNFRAME AND RUDDER.

SCALE - $\frac{3}{4}$ " = 1 FOOT.

FORGED SCRAP IRON To PASS LLOYD'S SURVEY

HOLES IN STERN FRAME $\frac{1}{16}$ " FOR 1 RIVETS, 5" APART C TO C.

HOLES IN RUDDER FRAME $\frac{1}{16}$ " FOR 1 RIVETS, 5" APART C TO C.


AREA = 453 $\frac{1}{2}$ D = 23'

A-D = 104 G

RUDDER HEAD TO RULE = 5'




DIAMETER TO RULE 5" ✓
OWNERS ADDITION 1" ✓
6" DIA

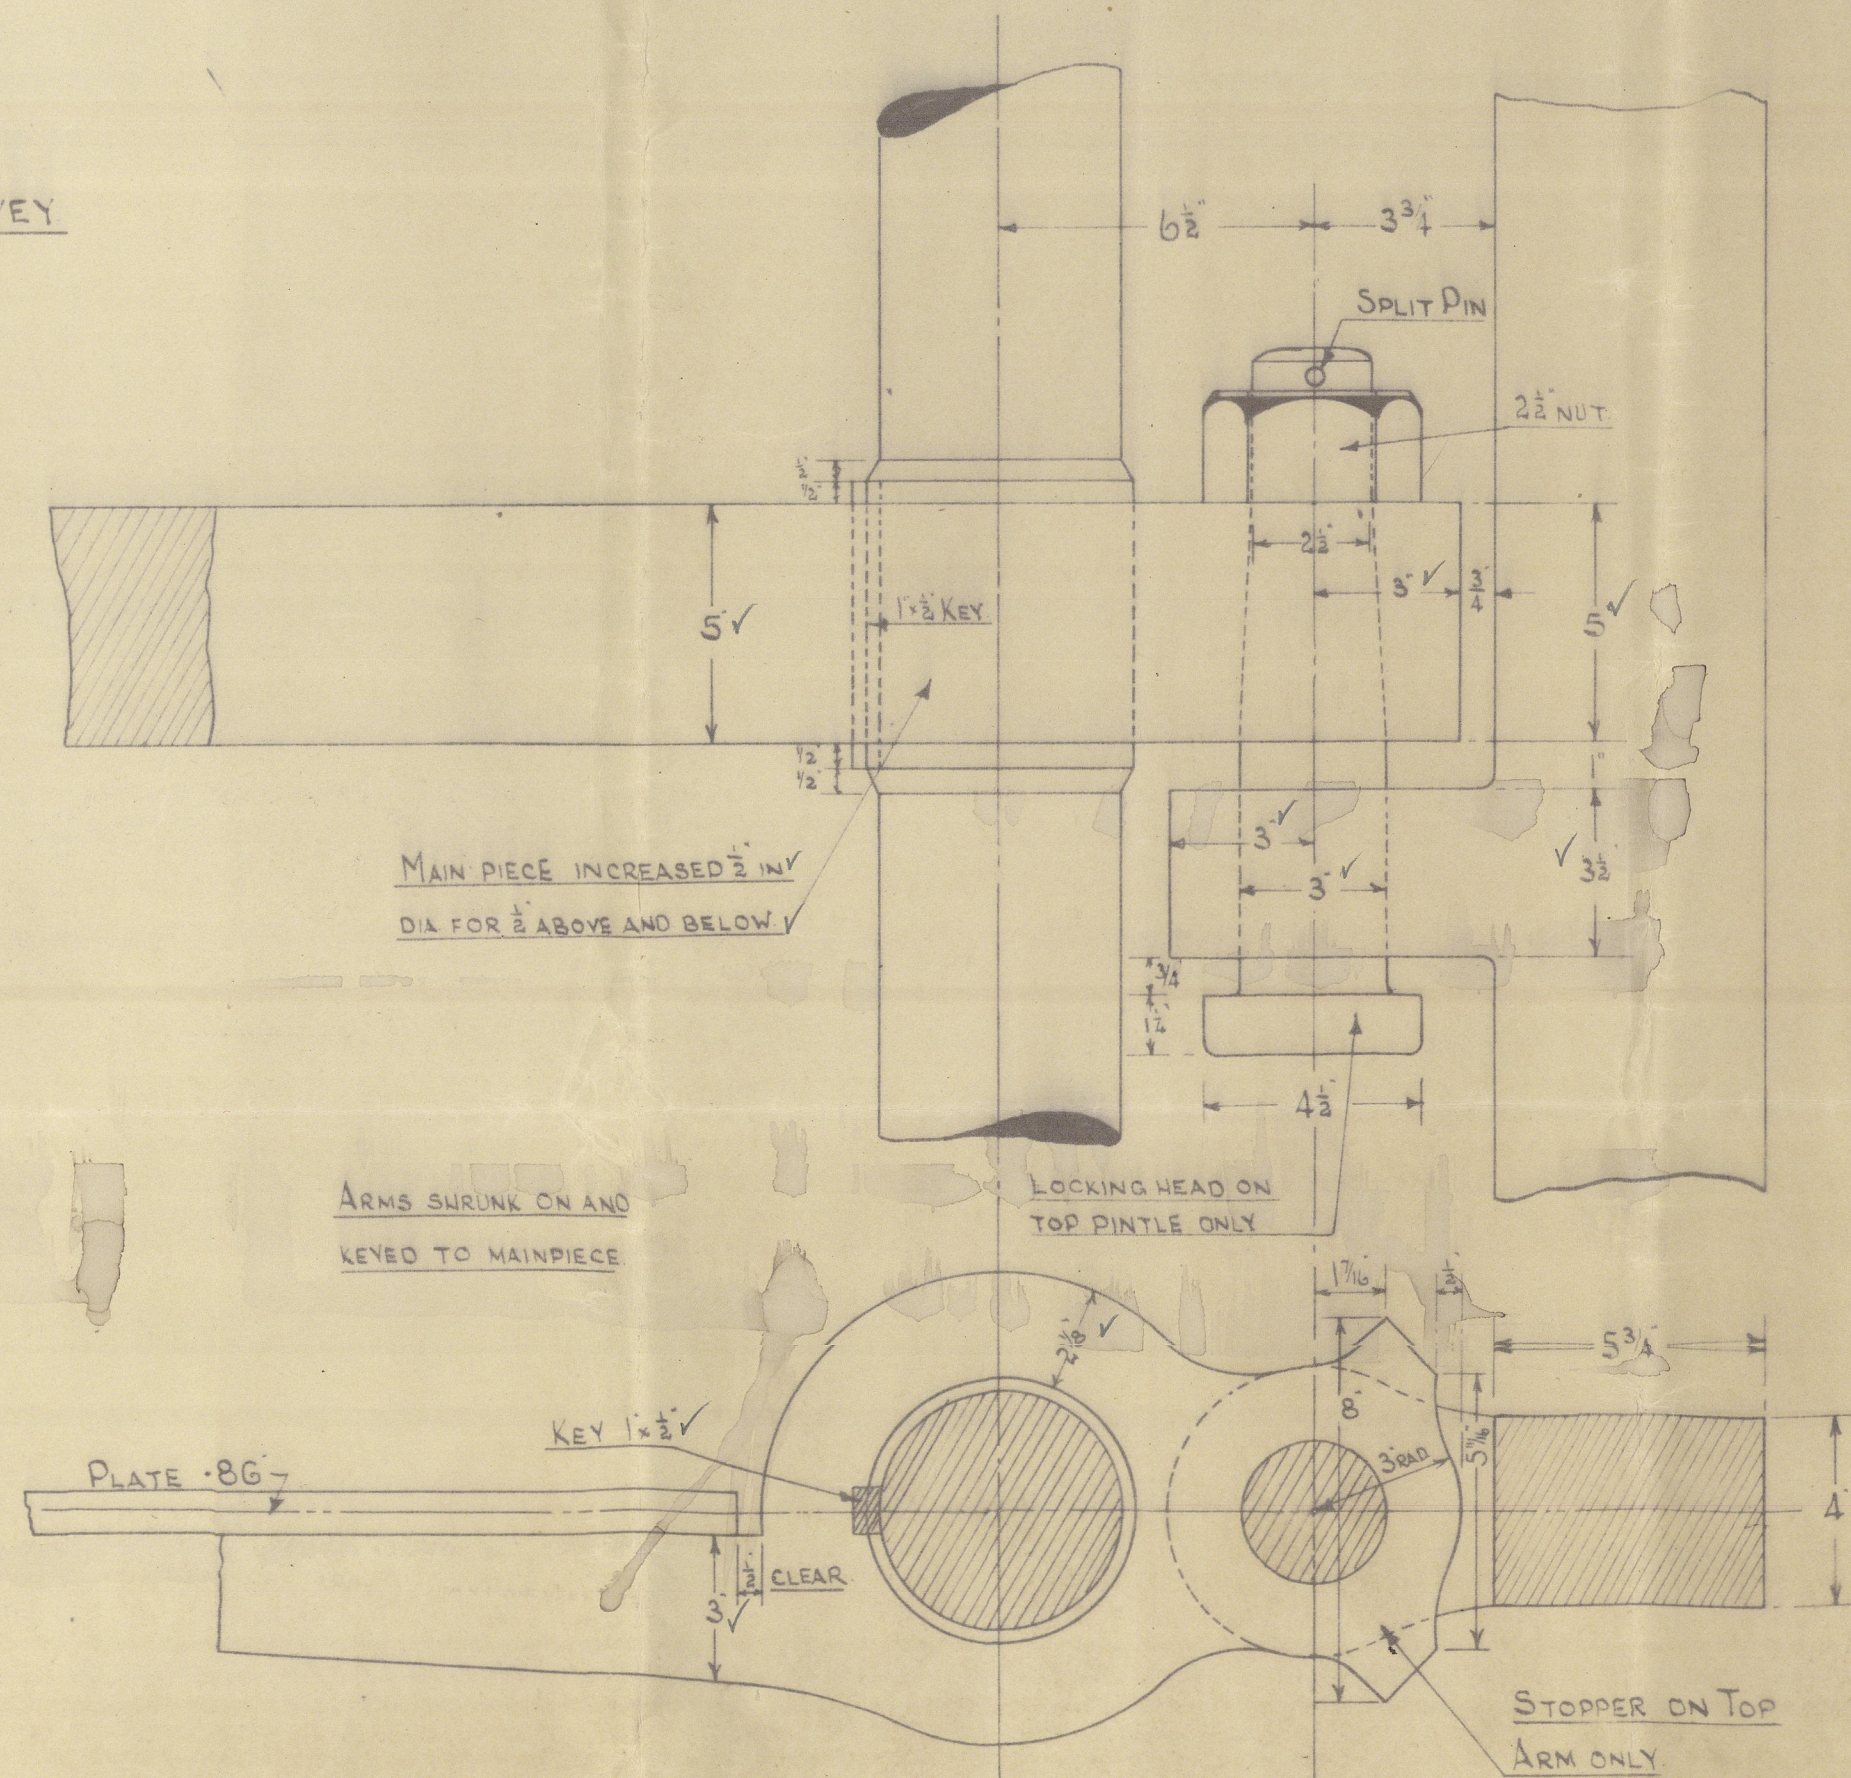


DETAIL OF GUDGEONS ETC

SCALE 3" = 1 FOOT.

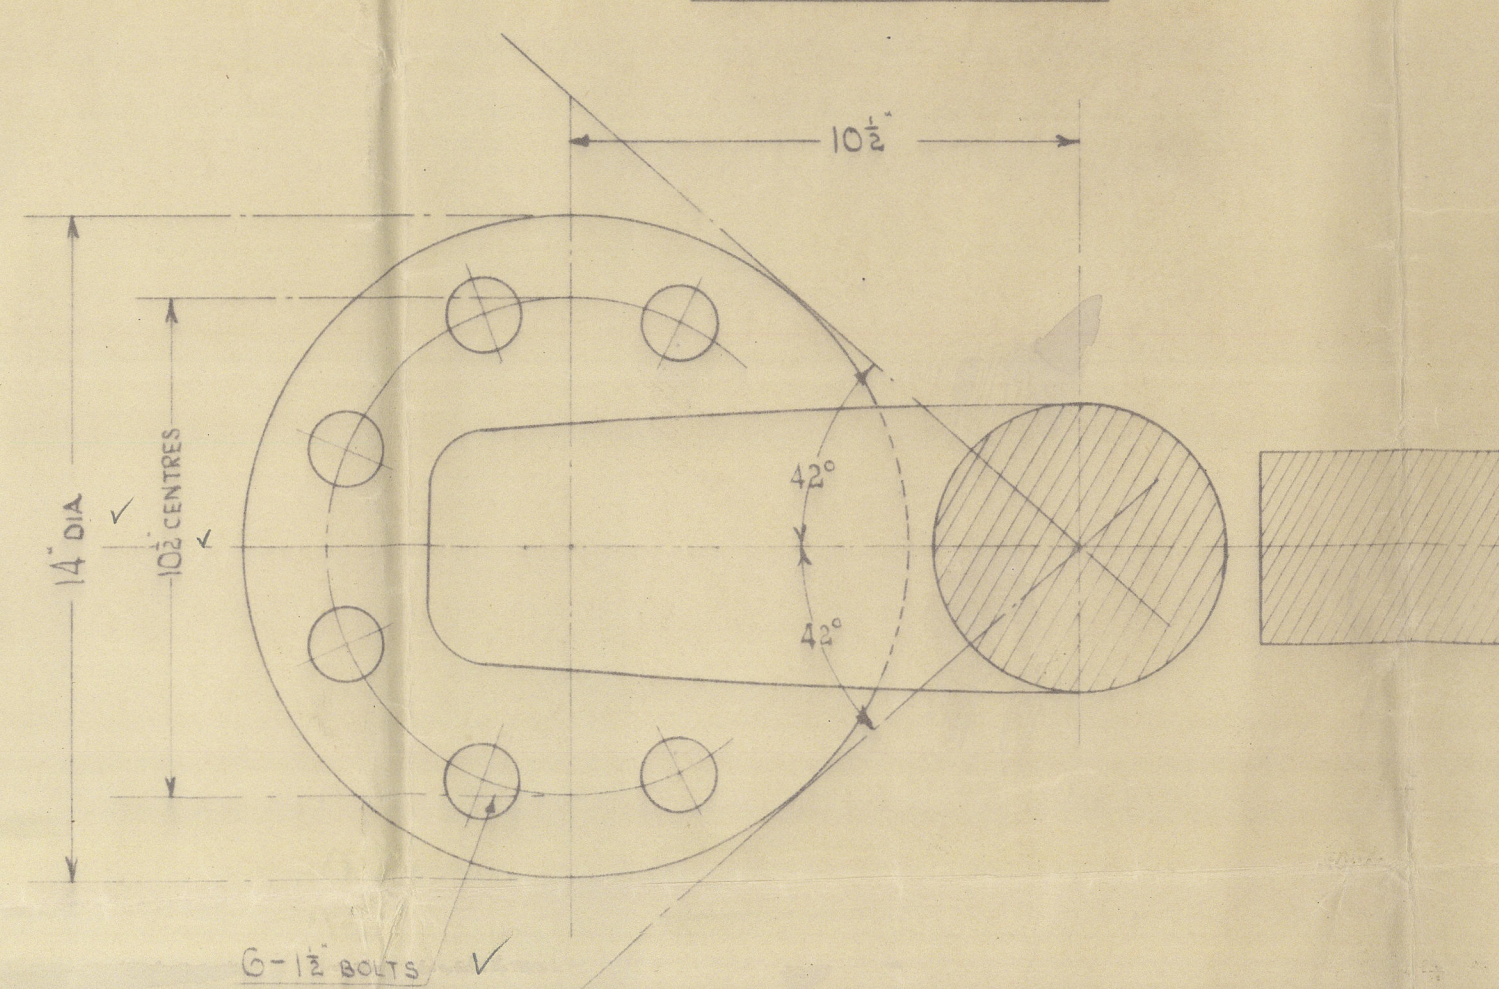

PLAN OF COUPLING

SCALE - 3" = 1 FOOT

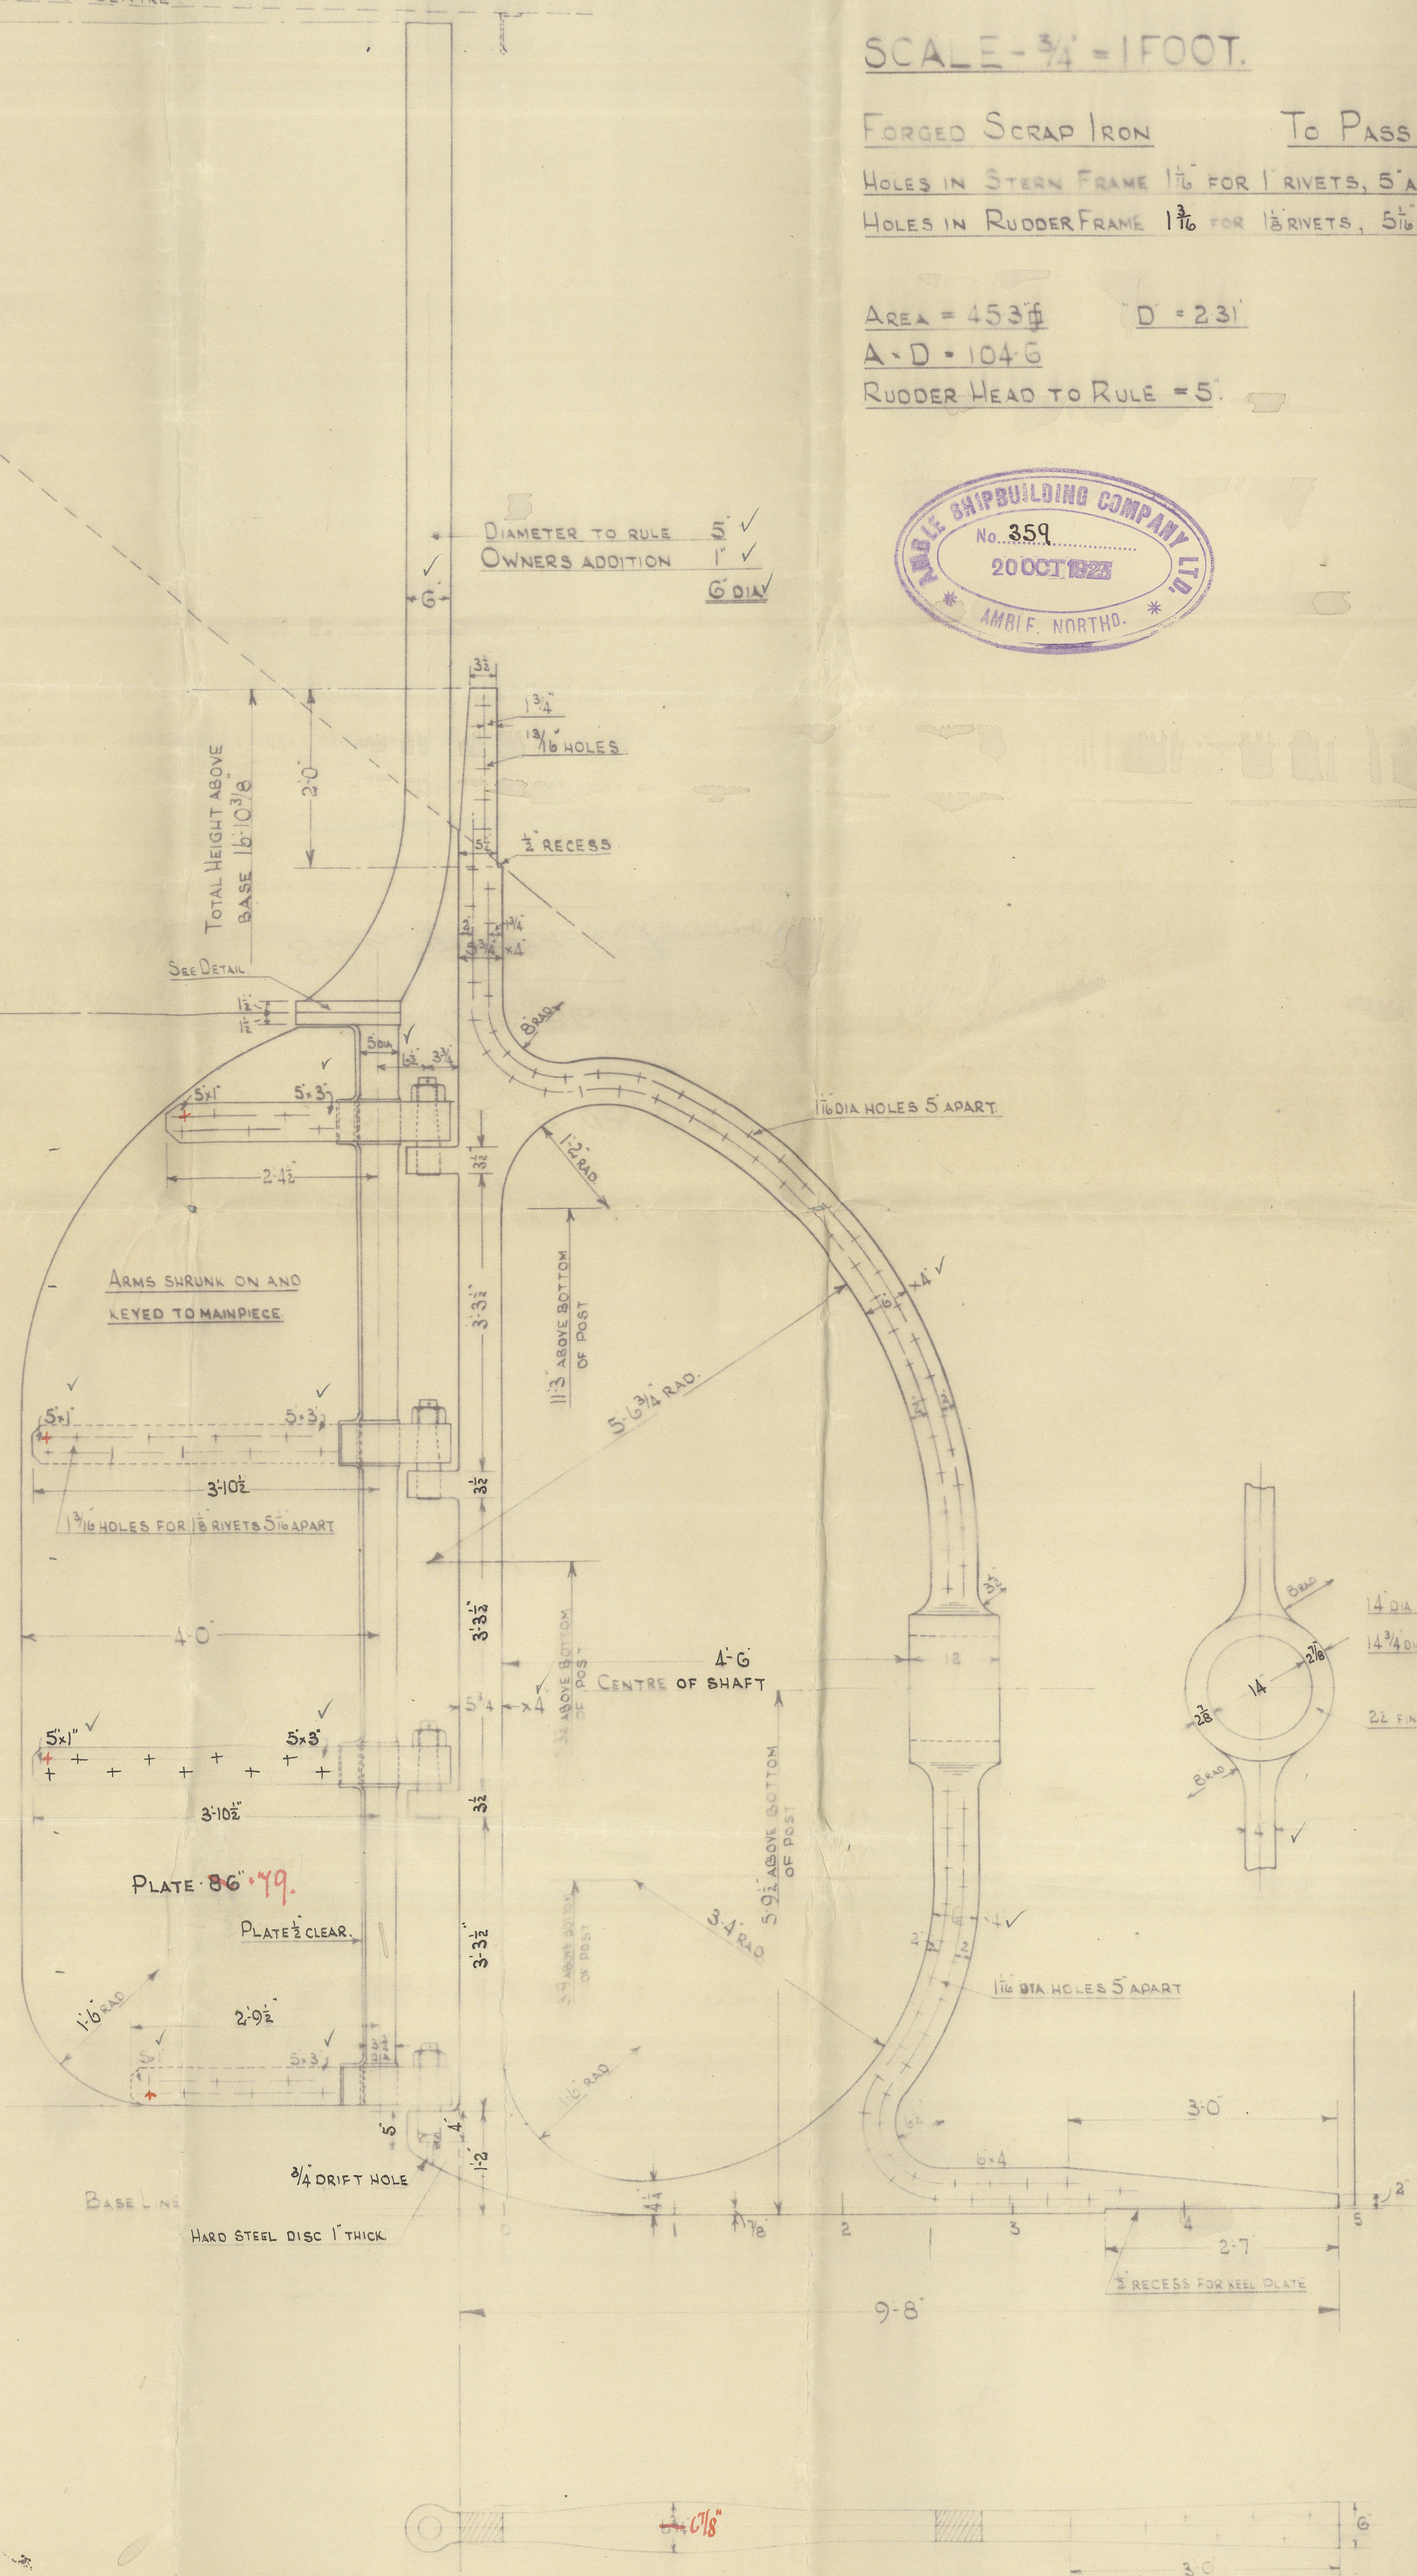

W/10/23.

(3)

Amble S.B.C^o

No. 36.

Stern & Rudder Frames.

S.S. KHUZISTAN.

NEWCASTLE ON TYNE.

Report No. 78021.



© 2021

Lloyd's Register
Foundation

002853-002857-0131