
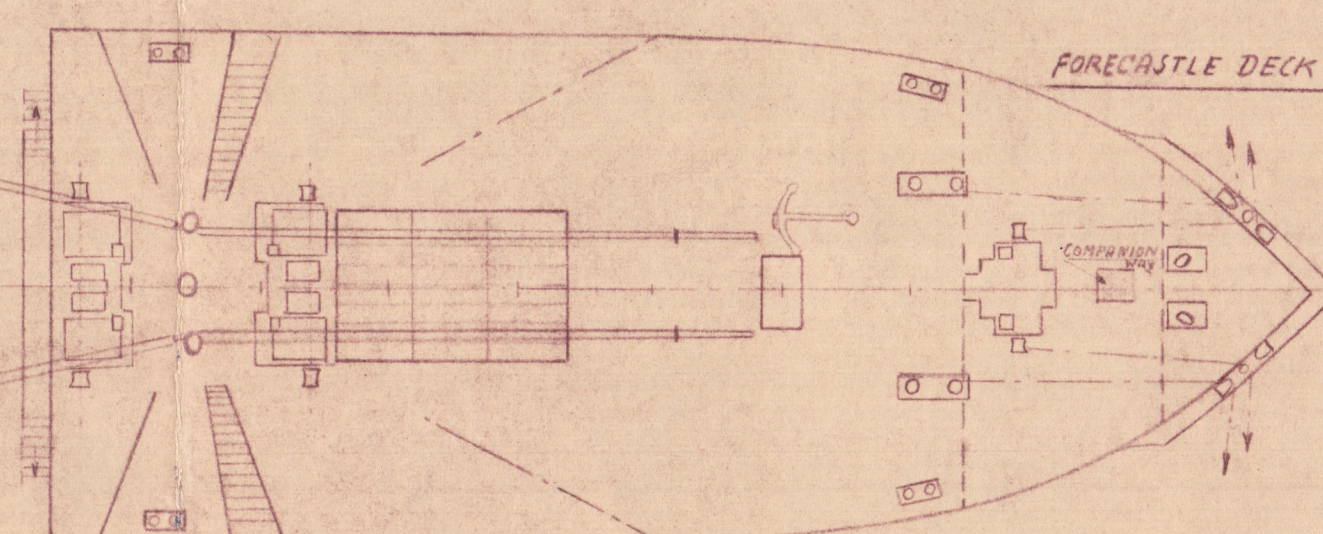
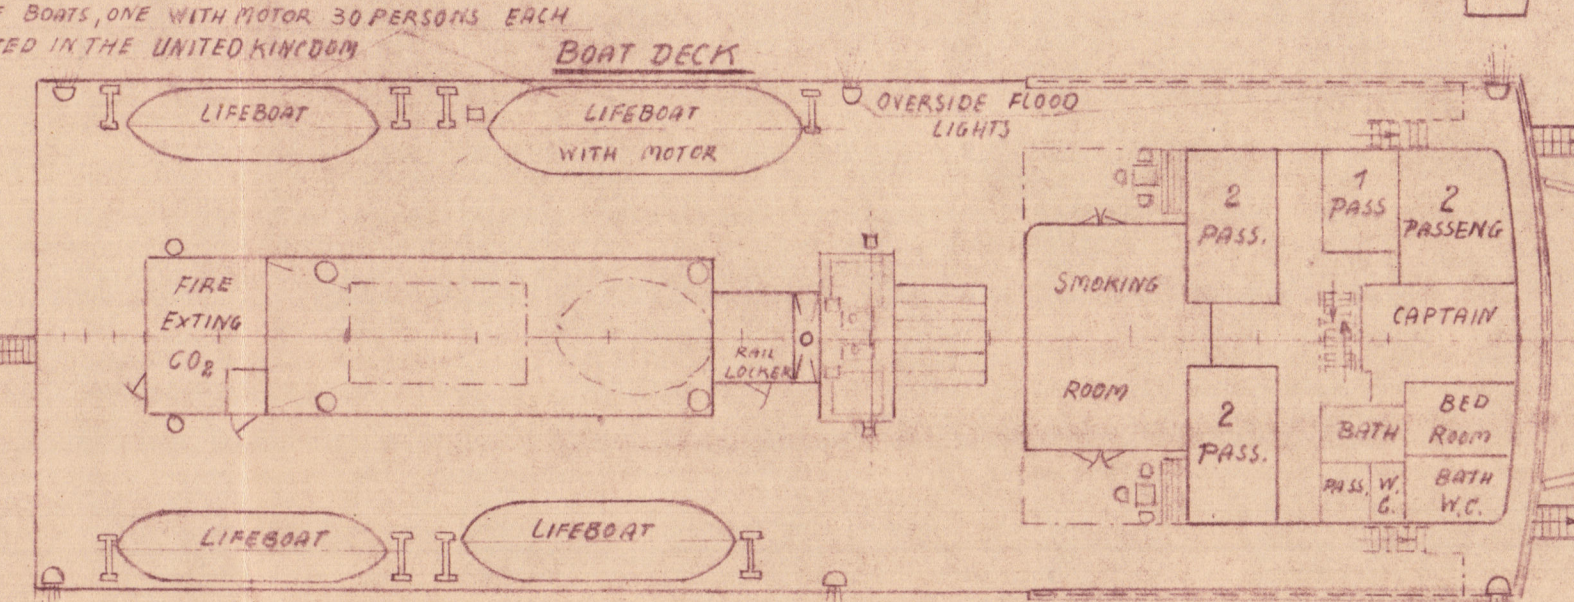
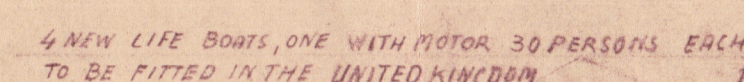
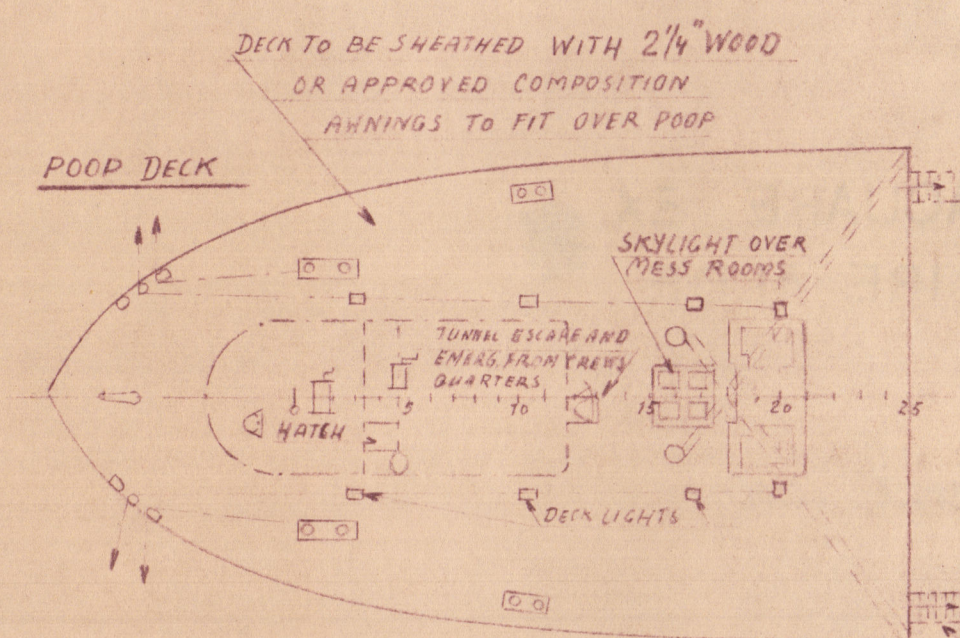
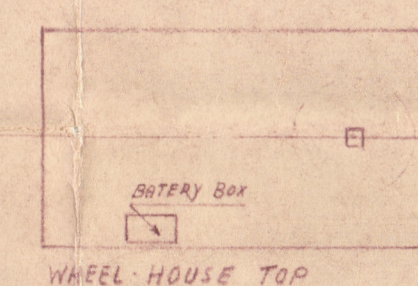


M.S. PELIKAN

ALSO GENERAL GUIDANCE TO NEW ARRANGEMENT OF M.S. "PONTOS"

SCALE: 1/200
1 CM. = 2 METRES

DIMENSIONS: L.O.P. = 114.9m (376'-11 1/16") L.B.P. = 106.5m (349'-5") B.M.D. = 13.6m (44'-7 7/16") D.U.P.P.D.K. = 8.75m (28'-8 1/2")

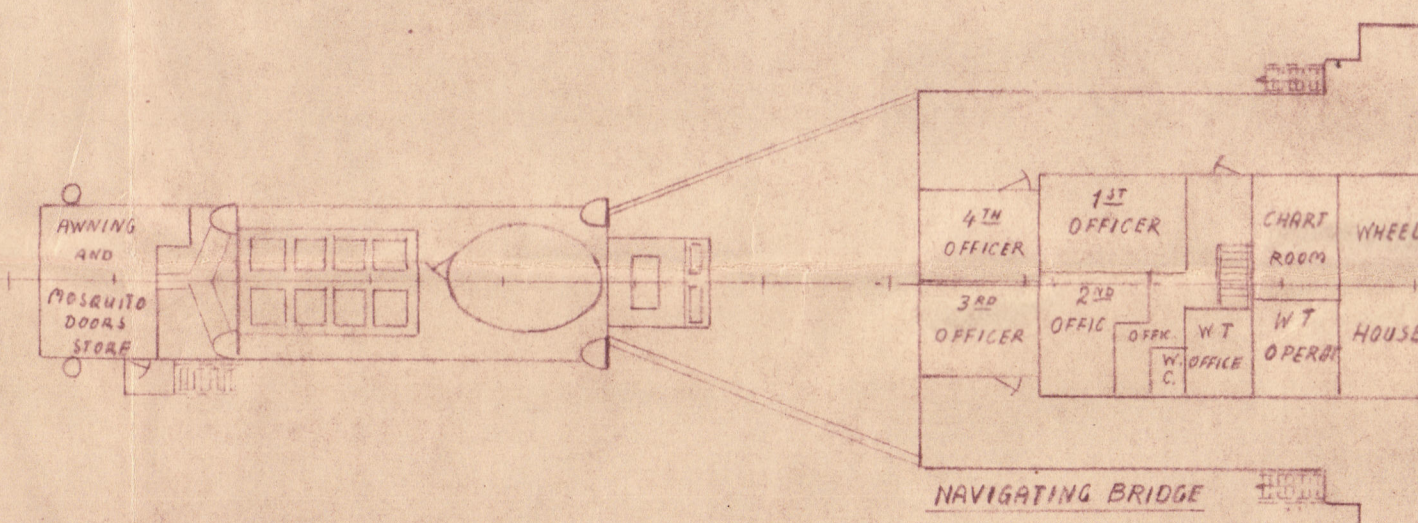

ACCOMMODATION TO BE MECHANICALLY
VENTILATED AND HEATED WITH HOT
WATER BOILER

FAN CAPACITY 40000 FT³/MIN.

SIDES PLATED OVER TO
PROTECT OUTSIDE DOORS

OUTLINE OF AIR COOLER
ROOM ON "M/S" PONTON"

FAN CAPACITY TO FORECASTLE
15 000 FT³/MIN

TOTAL FAN CAPACITY OF NO2 HOLD AND TWEEN DECKS 80000 FT³/MIN (2 FANS, EACH OF 40000 FT³/MIN (CAPAC))


FAN CAP. FOR NO.1 HOLD AND TWEEN
DECKS 40,000 FT³/min.

NEW TRIMMING HATCHES
ALL TRIMMING HATCHES AND
LIGHTS IN HOLDS TO FIT AS
ORIGINALLY

NEW ESTIMATED FRUIT CAPACITIES IN FT ³			
COMPARTMENT	M.S. "BELUKAN"	M.S. "PONTOS"	
N#1 HOLD	990 ^x	6000	
N#1 LOWER TWEEN DECK	14 169 ^x	13 038	
N#1 UPPER " "	12 780 ^x	15 857 ^x	
FORECASTLE	15 200 ^x	16800	
N#2 HOLD	24 922	30937 ^x	
N#2 LOWER TWEEN DECK	25 098	26670	
N#2 UPPER " "	25 375 ^x	23778	
N#3 LOWER " "	12 885	13738	
N#3 UPPER " "	18 422	19742	
TOTAL CAPACITIES	158756	169152	
*ORIGINAL "	128384	146352	
* DIFFERENCE (+ADDIT. GRP.)	30369	22800	
* NEW ESTIMATED FIGURES			

[illegible]

Fsb
14/3.46

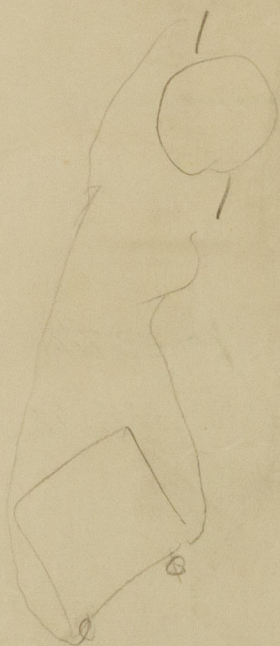


© 2020

Lloyd's Register
Foundation

PACUARE EX *
EMPIRE ALDE

general art.

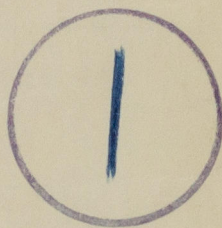

002870-002875-0235



© 2020

Lloyd's Register
Foundation