
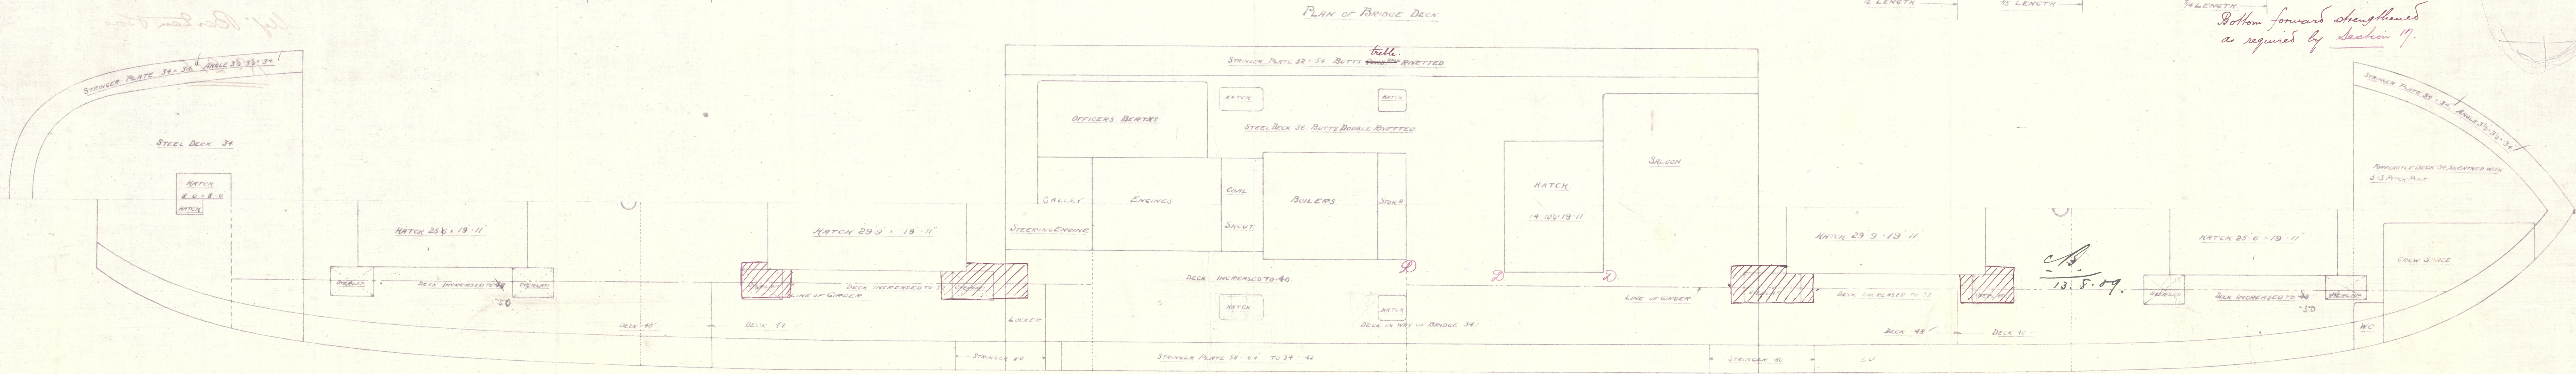


13.8.09
10.9.09

— PROFILE & DECK PLAN S.S.N° 215 —
— SCALE 1/8" = 1 FOOT —

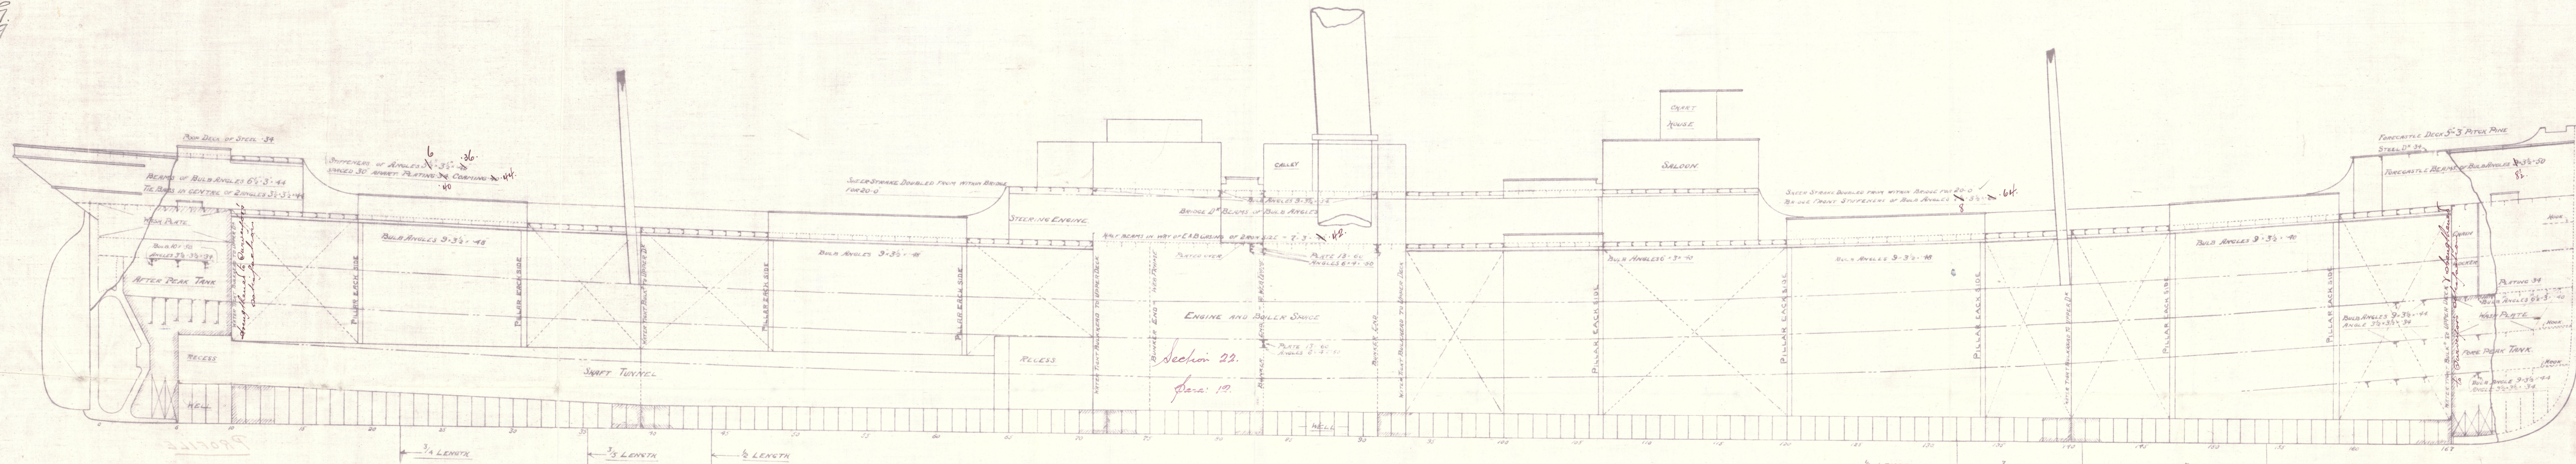

Bottom forward strengthened
as required by Section 17.

C.A.
13.5.09.

PROFILE

Ref: Barham & Sons

Nº 215

J. Mozart

Sl. Rpt 24382




RUSEN
EX
MOZART

w/s 736

YD 215

002876-002882-0070

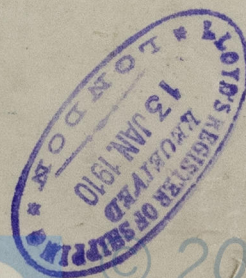

© 2020

Lloyd's Register
Foundation

002876-002882-0070