


— SCALE $\frac{1}{2}'' = 1$ FOOT. —

13. 8. 09.
10. 9. 09
11. 2. 10

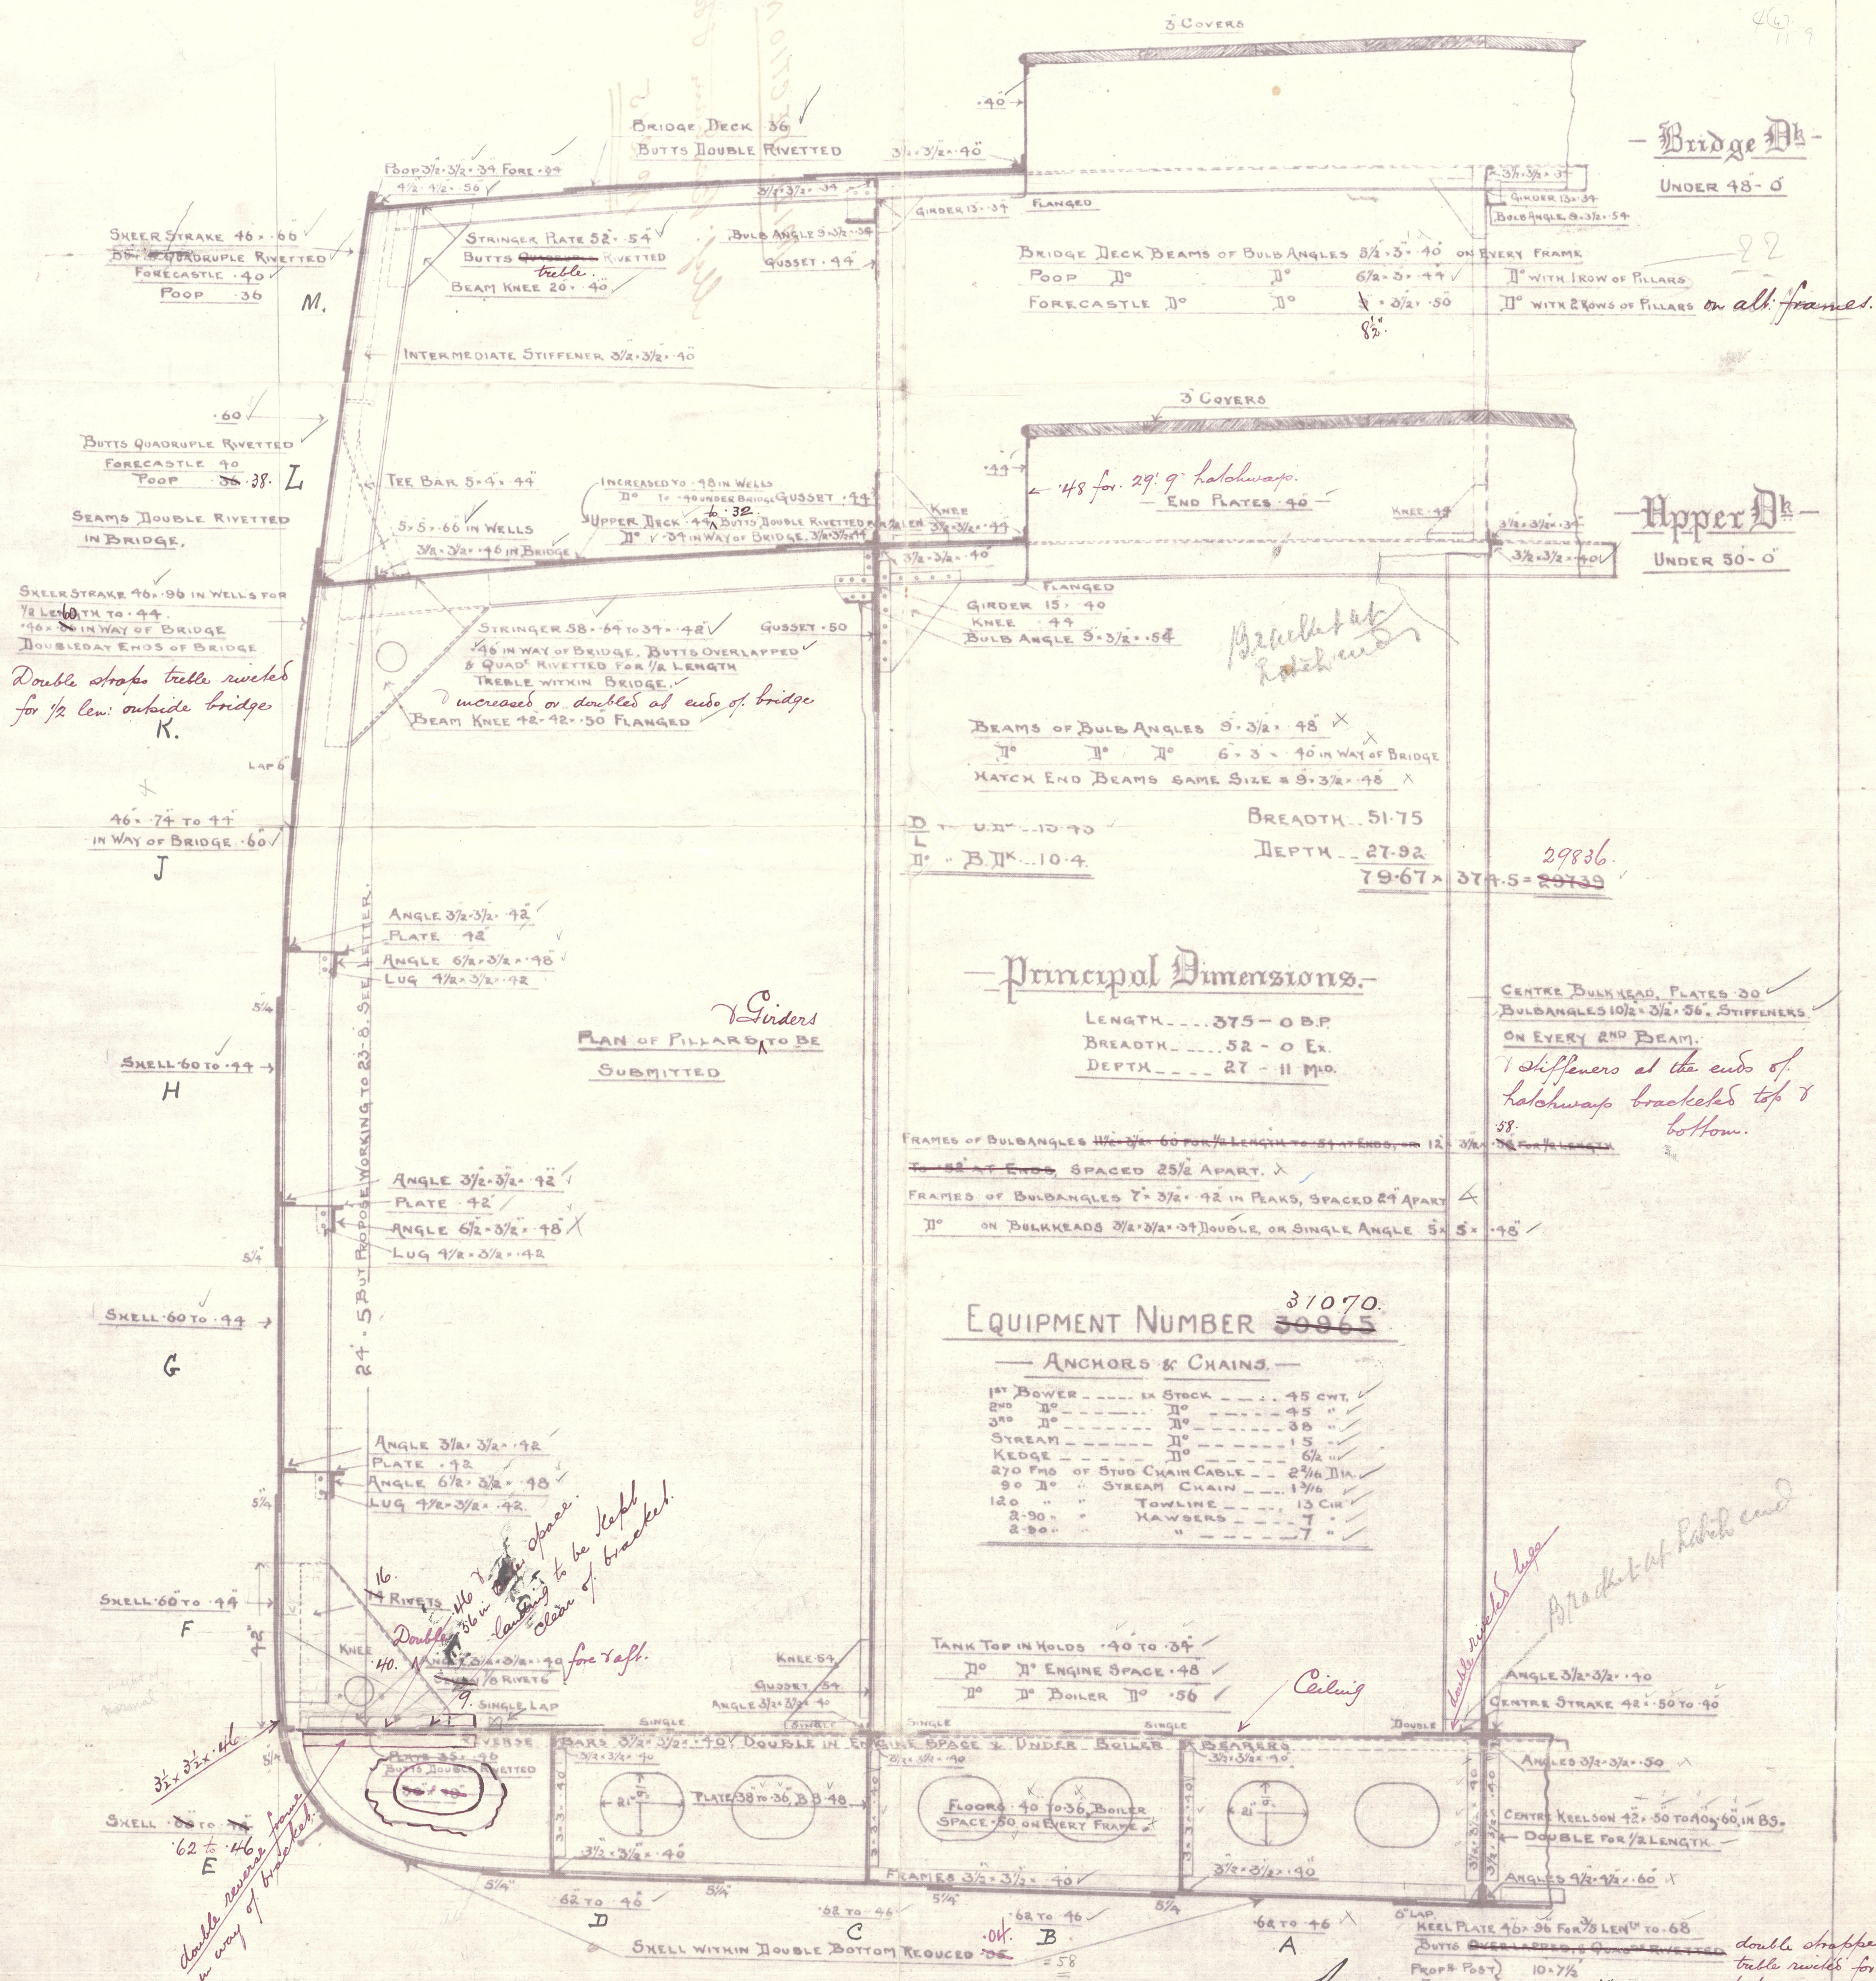

BARTRAM & SONS.

SHIPBUILDERS

SUNDERLAND

C.B.
13.8.09

RUDDER HEAD $9\frac{1}{2}$ } as per
" PINYLED $4\frac{3}{4}$ } Table 22

002416-002582-000

MID. SECTION

Ref: Barham & Son

No 215

% Mozart

alla Rpt 14382


Theomitor

RUSEW

BY

MOZART

VD 215

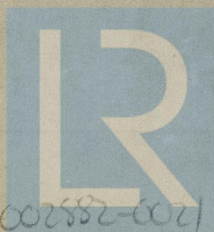

© 2020

Lloyd's Register
Foundation

002876-002882-0021