


T.S.S. No 416.

LONGITUDINAL SECTION AND DECK PLANS.

Scale 1/8" = 1 foot.

To Class LLOYDS 100A.I. with Freeboard corresponding to a C.S.S. Tessel.

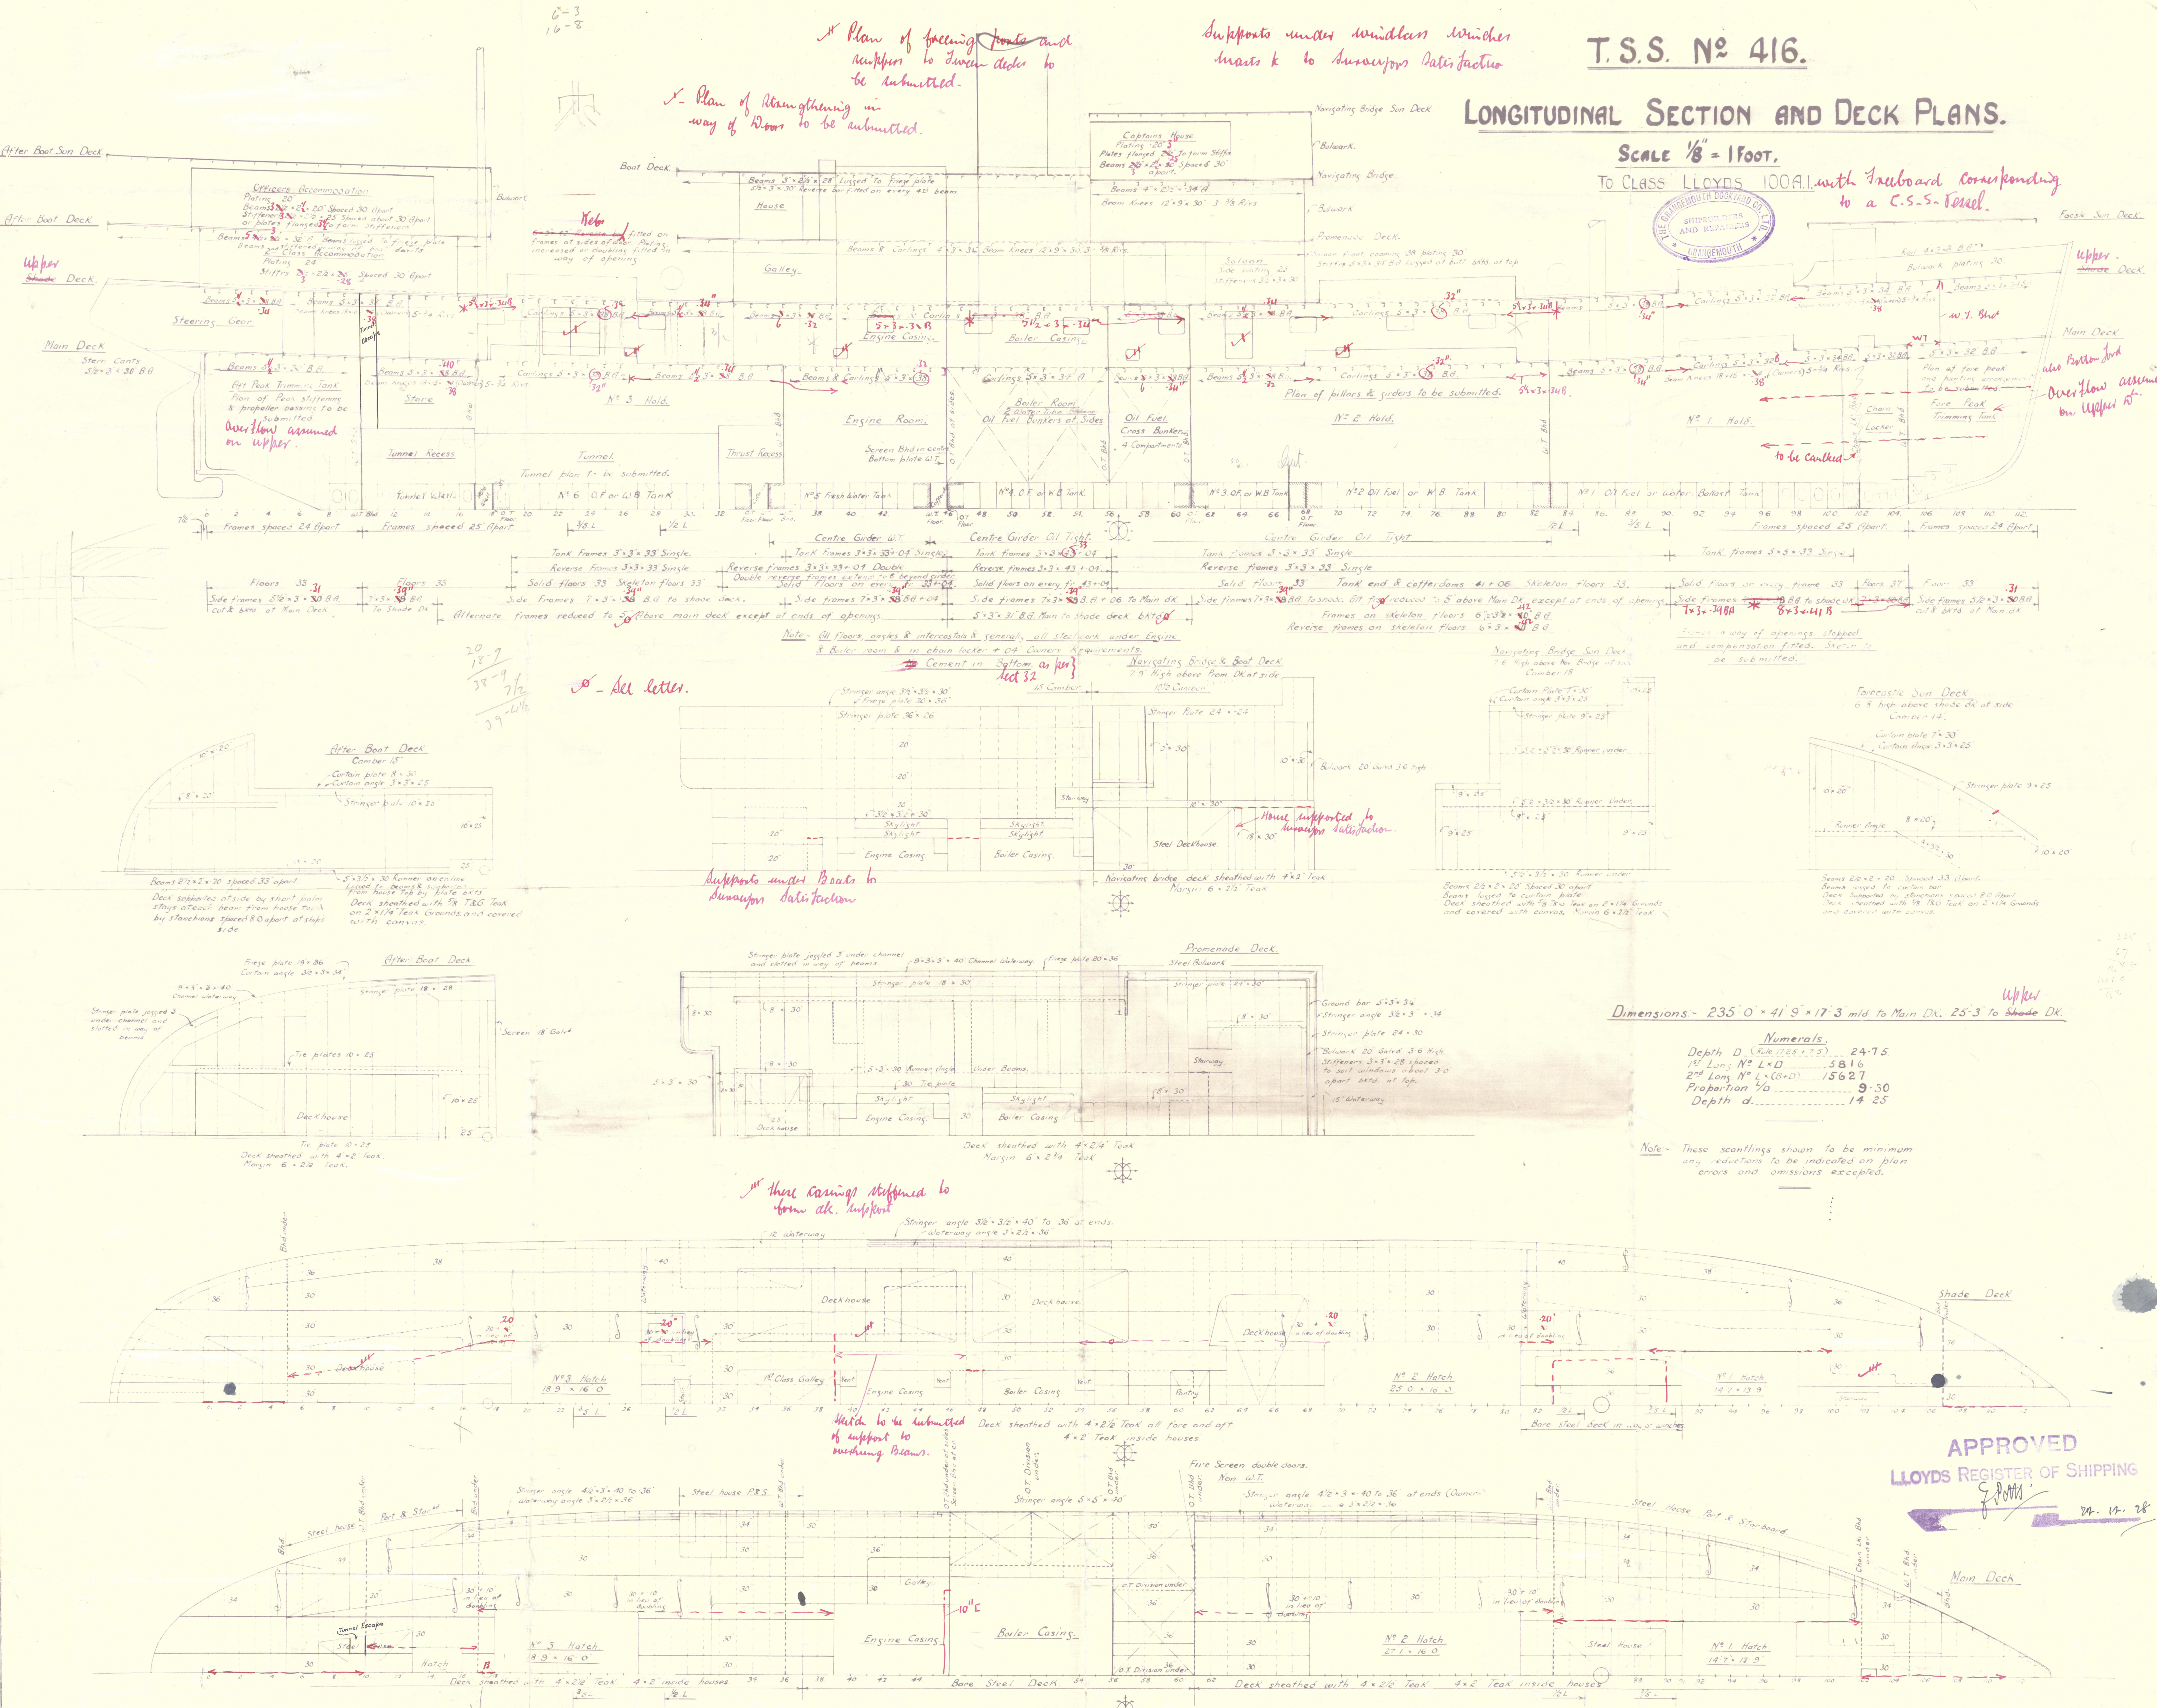

Dimensions: 235' 0" x 41' 9" x 17' 3" mld to Main Dk. 25' 3" to Shade Dk.

NUMERALS.

Depth D. (Rule 123 & 75)	24.75
1st Long N° L x D	58.16
2nd Long N° L x (G+D)	156.27
Proportion 1/2	9.30
Depth d.	14.25

Note: These scantlings shown to be minimum any reductions to be indicated on plan errors and omissions excepted.

APPROVED
LLOYDS REGISTER OF SHIPPING



© 2020

Lloyd's Register
Foundation

Grangemouth Drydock Co.
Ltd.

No. H/6.


Profile & decks

"Islander"

GLASGOW REPORT No 49892

002876-002882-6154

002876-002882-6154

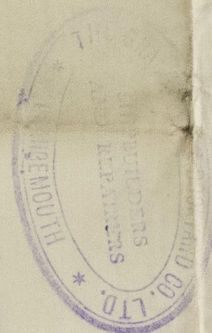

© 2020

Lloyd's Register
Foundation