

Newcastle-on-Tyne 87073

## Verification Report.

Index No.  
(For London Office only.)

34000

6. 11b  
Lloyd's Register  
3365-6Lloyd's Register of Shipping.  
SURVEYS FOR FREEBOARD. - Motor STEAM SHIPS. 25 APR 1931

PARTICULARS RELATING TO ALL STEAM SHIPS EITHER FLUSH DECKED, OR WITH TOP GALLANT FORECASTLES, SHORT POOPS AND BRIDGE HOUSES DISCONNECTED, OR WITH TOP GALLANT FORECASTLES HAVING LONG POOPS, OR RAISED QUARTER DECKS CONNECTED WITH BRIDGE HOUSES, OR OTHERWISE.

Port of Survey NEWCASTLE-ON-TYNE  
Date of Survey 22<sup>nd</sup> April 1931.  
Name of Surveyor Thomas S. Shute.

Ship's Name. M. S. Cardium	Port of Registry and Nationality. London British	Official Number. ✓	Gross Tonnage. ✓	Date of Build. New Vessel	Particulars of Classification. 100. A. I. "carrying petroleum in bulk" (Contemplated).
Number in Register Book ✓					
Registered dimensions from Ship's Register.	LENGTH. 451.3	BREADTH. 62.0	DEPTH. 34.05	UNDER DECK TONNAGE. 7482.67	Moulded Depth as measured..... - Rule wood deck less str 34'-0" - 3 1/4" 33'-8 3/4" to use
Length on LOADLINE.	450.0	mean Frame Depth 10 1/4" Ceiling + .20	Peak Included	Tanks E.R. Double Bottom + 5 1/2 tons.	Addition for Keel below base line for draught record..... 1 1/8 inches.
CORRECTED DIMENSIONS.	450.0	Rule " 7 Sheer + 1.03 6 1/2 = 2 X 3 1/4 - .54 No. S/3 + .33	Floors + 11 tons.		
					CORRECTION FOR LENGTH.
					Length of Ship on Loadline..... 450.0 Length in Table ..... 404.75 Difference ..... 45.25
					Correction for 10ft., Table A. .... 1.7 Table C. .... 8 x Difference divided by 10 ..... 7.44 (if required.) 3.62 If 1/10th length covered divide by 2 ✗ + 7 1/2 + 3 1/2
					CORRECTION FOR IRON DECK.
					Proportion covered, if less than 1/10th length covered ..... 4.008 Thickness of usual wood deck, less stringer ..... 3.3 Allowed in moulded depth - 1/4
					CORRECTION FOR ROUND OF BEAM.
					Breadth at Gunnwale amidships..... 61.75 Round of Beam ..... 15 1/2 Normal round ..... 15 1/2 Difference ..... ✓ ÷ 2 = ..... ✓
					Proportion of Deck uncovered (Para. 19) ..... ✓ N.I.P.
					Freeboard, Table A ..... 9-2.40 Correction for Sheer ..... - 7.09 8-5.31 + 7.69 19-1.00 + 7 1/2
					Correction for Length ..... 19-1.00 Allowance for Deck Erections ..... - 8.46 8-4.54 - 8 1/2 8-5.2 4 1/2
					Correction for Round of Beam ..... ✓
					Correction for fall in Sheer (if any). .... ✓
					Correction for Steel Deck (if required) Allowed in moulded depth - 1/4 8-4.54
					Additions for non-compliance with provisions of Para. 11 (d) and (e) + ✓
					Other Corrections (if any) ..... ✓
					Winter Freeboard ..... 8-4 1/2 Summer Freeboard ..... (5 3/4 - 6 1/2) 6 ..... 7-10 1/2 Indian Summer Freeboard ..... 7-4 1/2 N.A. Winter Freeboard ..... + 1 3/4 -
					Correction necessary because clearside amidships, measured in accordance with the Statute is not taken at the intersection of the wood or steel deck with side. + 1 3/4 -
					Winter Freeboard from deck line ..... 8-6 1/4 Summer " " " ..... 8-0 1/4 Indian Summer " " " ..... 7-6 1/4 N.A. Winter " " " ..... 8-0 1/4 - 23/12/31
					Length. 42.125' Length allowed. 42.125' Height. 7.25' Bridge House 34.5' 34.5' 7.25' + Raised Q. Dk. 104.96' 102.54' 7.25' Poop. Side 102.54' 103.75' 7.25' Total 180.275' 179.165' 39.81' = 4008 Length of Ship 450.0 Corresponding percentage 26.06% 24.88% Percentage as below 26.06% 24.88%
					FREEBOARD recommended amidships from centre of Disc to top of Statutory Deck Line, Wood (Steel) Deck : -
					Fresh Water Line above centre of Disc .....
					Indian Summer Line " " " .....
					Winter Line below " " .....
					Winter North Atlantic Line " " .....

If the frames, skin planking, or ceiling are of unusual thickness, the breadth of vessel to inside of ceiling should be reported if possible.  
In vessels obtaining an allowance for deck erections under Para. 11 where the sheer drops abeam amidships the height of the R.Q.D. is to be taken from the level of the top of the amidship beam.  
In flush-decked vessels the total standard mean sheer means the sheer measured at the stem and stern-post. In vessels having poops and forecastles, it means the sheer measured at points distant one-eighth of the vessel's length from stem and stern-post.

State dimensions of freeing port area on back of this form.  
The Surveyor should state whether the fall in sheer as reported is measured relatively to the straight line of keel or to the water line. If measured relatively to water line the vessel's draft at time of survey, and also the usual load draft forward and aft should be reported.

MARKING FORM  
RECEIVED 7 MAY 1931

007907 002915 0057

28 APR 1931  
27.4.31

© 2021

Do all the Frames extend to the top height in the Poop?	Yes	Raised Quarter Deck?	✓	Bridge House?	Yes	Forecastle?	Yes
To what height do the Reverse Frames extend?	None	Frame legs = B.A.		Deck & bottom = Longitudinal Framing			
Has the Poop or Raised Quarter Deck an efficient Iron Bulkhead at the fore end?	Yes						
Give particulars of the means for closing the openings in Bulkhead	Two openings (5'0" x 2'6")	Steel coamings 18"	Closed with steel doors on riveted hinges				
Is the Poop or Raised Quarter Deck connected with the Bridge House?	No			Has the Bridge House an efficient Bulkhead at the fore end?	Yes		
Give particulars of the means for closing the openings in Bulkhead	One opening (5'0" x 2'6")	Steel coamings 18"	Closed with steel doors on riveted hinges				
What is the thickness of the Bridge Front plating?	40	and Coaming plate?	44				
Give scantlings and spacing of the Stiffeners	Bull angle 9 x 3½ x 44 N.B.S		Spaced 2'3½" — 2'7"				
Are bracket plates fitted at each end of the Stiffeners?	Yes			Are hor'l. brackets fitted connecting Bridge Bulk'd. with Bulwarks?	Yes		
Has the Bridge House an efficient Iron Bulkhead at the after end?	Yes						
How are the openings closed?	Two openings (5'1" x 3'1")	Steel coamings 18"	Closed with steel plates secured with hooked bolts (Top=2, Bottom=2, Each side=4) not through B.H.				
Is the Forecastle at least as high as the main or top-gallant rail?	7'3"			Has the Forecastle an efficient Iron or Wood Bulk'd. at after end?	Yes		
Are the Engine and Boiler openings covered by a Bridge, Poop, Raised Quarter Deck, or enclosed by a Strong Iron or Steel Deckhouse?	on Poop	Yes					
If the openings are not so protected are the exposed parts of the Casings efficiently constructed?		Yes					
Give thickness of plating; scantlings and spacing of Stiffeners							
What is the height of the exposed Casings?	7'9"			Are suitable means provided for closing all openings in them in bad weather?	Yes		
Are the Weather Deck Hatchways efficiently constructed and at least equal to the requirements of the Rules? Give particulars below:	Cargo Hatch Fore	O.T. Hatches					
Position.	U.D.K		Upper Deck				
Size.	9'0" x 12'1"		6'0" x 4'0"				
COAMING. Height above top of DECK	2'6"	2'0"	2'6"				
Thickness Sides.....	.44	.44	.40				
Thickness Ends.....	.44	.44	.40				
SHIFTING BEAMS OR WEB PLATES.	Number .....						
	Section and Scantlings .....	None					
	Material .....						
* FORE AND AFTERS.	Number .....						
	Section and Scantlings .....	None					
	Material .....						
HATCHES Thickness .....	Steel Covers .5'0" Stiffened with		Steel Covers .6'0				
Remarks.....	B.A. 5'2" x 3' x 4'2". S=3'0"						

\* The depth of Fore and Afters should be stated from the underside of the hatches in all cases.

(If the sill of the lowest side scuttle will be less than 6 inches above the Indian Summer Load Line if assigned under the tables, state vertical distance from top of keel to lower edge of lowest side scuttle.)

The following information is to be given in all Cases of vessels dealt with under Paras. 11, 12 (under 15 feet Moulded depth) and under Shelter Deck Rules.  
What is the thickness of the Bridge Sheerstrake? ✓ Strake between Main and Bridge Sheerstrakes?

The following information is to be given in all cases of vessels built with under Part II, II, II, or III (under 15 feet maximum depth) and what is the thickness of the Bridge Sheerstrake?

Delete the words { The Crew ~~are~~, are not, berthed in the bridge house. Poop, Bridge & Forecastle connected by gangway  
that do not apply { The arrangements to enable them to get backwards and forwards from their quarters are ~~are~~, not satisfactory.

#### Length of Bulwarks in well

Length of Bulwarks in well  
Area of Erasing Parts required by Bars 11 (s) each side of vessel


## Area of Freeing Ports required by Part

Ft. Tents.

Sq. ft.

Moulded displacement  
at 86% of depth moulded

Sq. ft. = 18278 tons

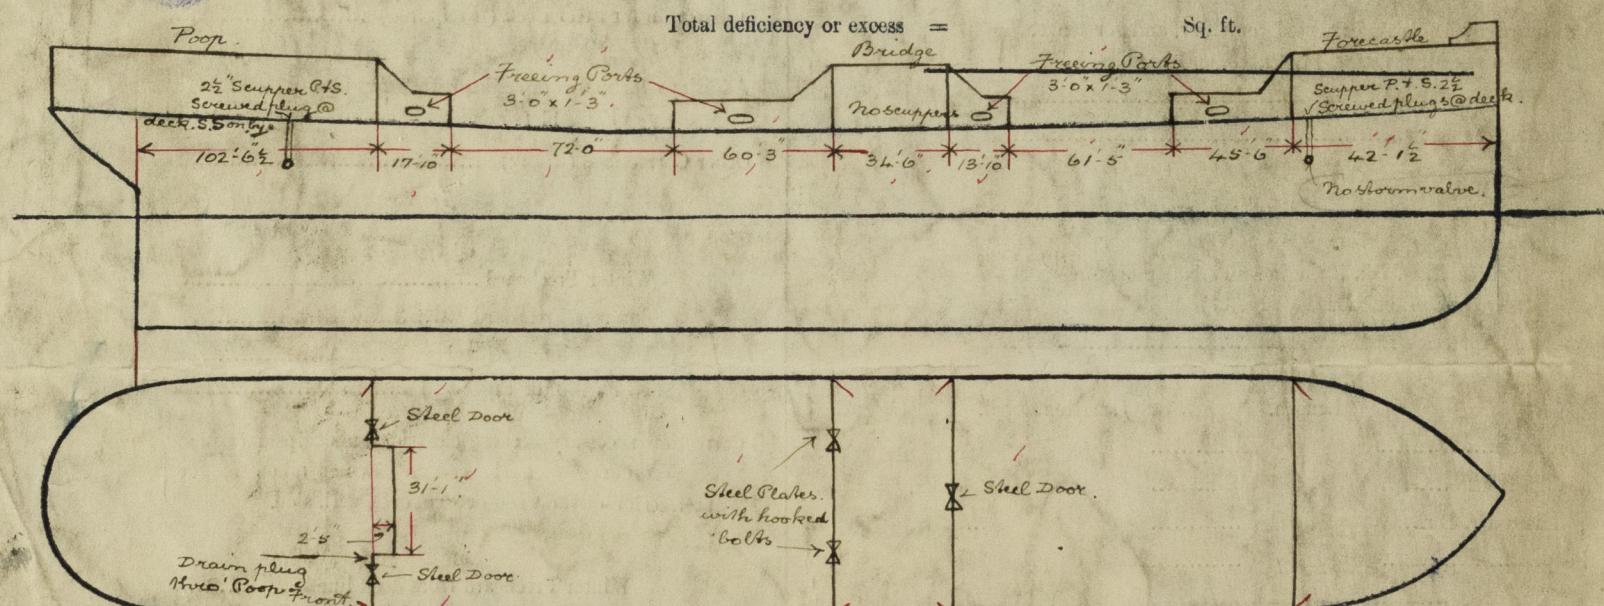

Show horizon line of Floors or Tank Top with position of any Breaks in same; also height of Peak, Tank tops, &c., &c.

State any special features in the construction of the Vessel      *Plans in London*

Builder's name and yard number Swan Hunter & Wigham Richardson Ltd. No 1455.

Names of sister vessels Motor ship "Cardita" N° 1453 " " " assignment letter dated 1<sup>st</sup> April  
Renewal No 86972.

Owners Anglo Saxon Petroleum Co Ltd

Add n222

“ Address

Fee £ ~~18~~ : 0 : 0.  
Paid 23 Febr 31.

Fee £ ~~10~~ : 0 : 0. Received by me See F.C. Report

