


No 179.

STEEL SCREW COASTING STEAMER.

DIMENSIONS:-  $130^{\text{FT}} \times 23^{\text{FT}} \times 10^{\text{FT}} - 6^{\text{IN}}$  MOULDED.

TO CLASS 100-A1 AT LLOYD'S

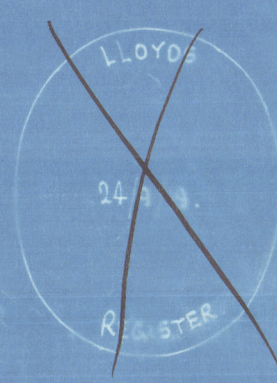



Crabtree & Co

S. S. 179

Midship Section

BEN VEEN

St. Crossbill.

London. 83810.

RETAIN



© 2020

Lloyd's Register  
Foundation

002916-002922-0001



202



© 2020

Lloyd's Register  
Fot...

002916-002922-0001