


Nos 510-11-12 & 13.


# LONGITUDINAL SECTION.

DIMENSIONS:- 425' x 57' x 38'-6" MLD To UPPER DS.

Scale:- 1/8" = 1 ft.

 

See Modified Panning Arrangement:-

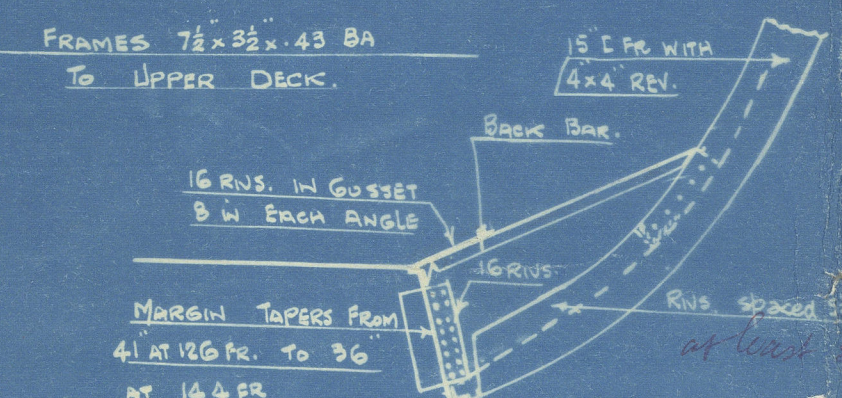


Section thru Tank Side in way of Panning  
See plan of modified main  
derrick 10/10/28

WJ,  
31.12.28



N. ews. 510 - 12

Profile

P.O. "Misbank" \*  — 510

P.O. "Lossiebank" — 511

P.O. "Gaybank" — 512

P.O. "Tweedbank" — 513



© 2020

Lloyd's  
Foundation

002938-002946-0052