

MIDSHIP SECTION, PROFILE & DECK PLAN.

YARD NO S2 & S3 & S4

19.6.19
5.7.19

MIDSHIP SECTION Scale 1/2" One foot.



DIMENSIONS


LENGTH BETWEEN PERPENDICULARS 160 - 0

BREADTH MOULDED 25 - 0

DEPTH MOULDED TO UPPER DECK 11 - 8

PROFILE & DECK PLAN. Scale 1/8" 1 foot.

ITEM	SCANTLING	PROPOSED SUBSTITUTION
AFT PEAK FRAMES	4 1/2 x 34	4 1/2 x 30
FORE "	"	4 1/2 x 30
R.O. DECK FRAMES	4 1/2 x 36 O.A.	6 x 3 x 35 B.A.
" IN BOLLER SPACE	5 x 3 x 36 "	"
UPPER DECK FRAMES	4 1/2 x 32 "	4 x 3 x 45 O.A.
UPPER DECK 1/2 BEAMS	4 x 3 x 30 "	5 x 3 x 30 O.A.
R.Q. DECK 1/2 "	4 x 3 x 30 "	5 x 3 x 30 O.A.
AFT PEAK BULKHEAD	5 x 3 x 34 "	"

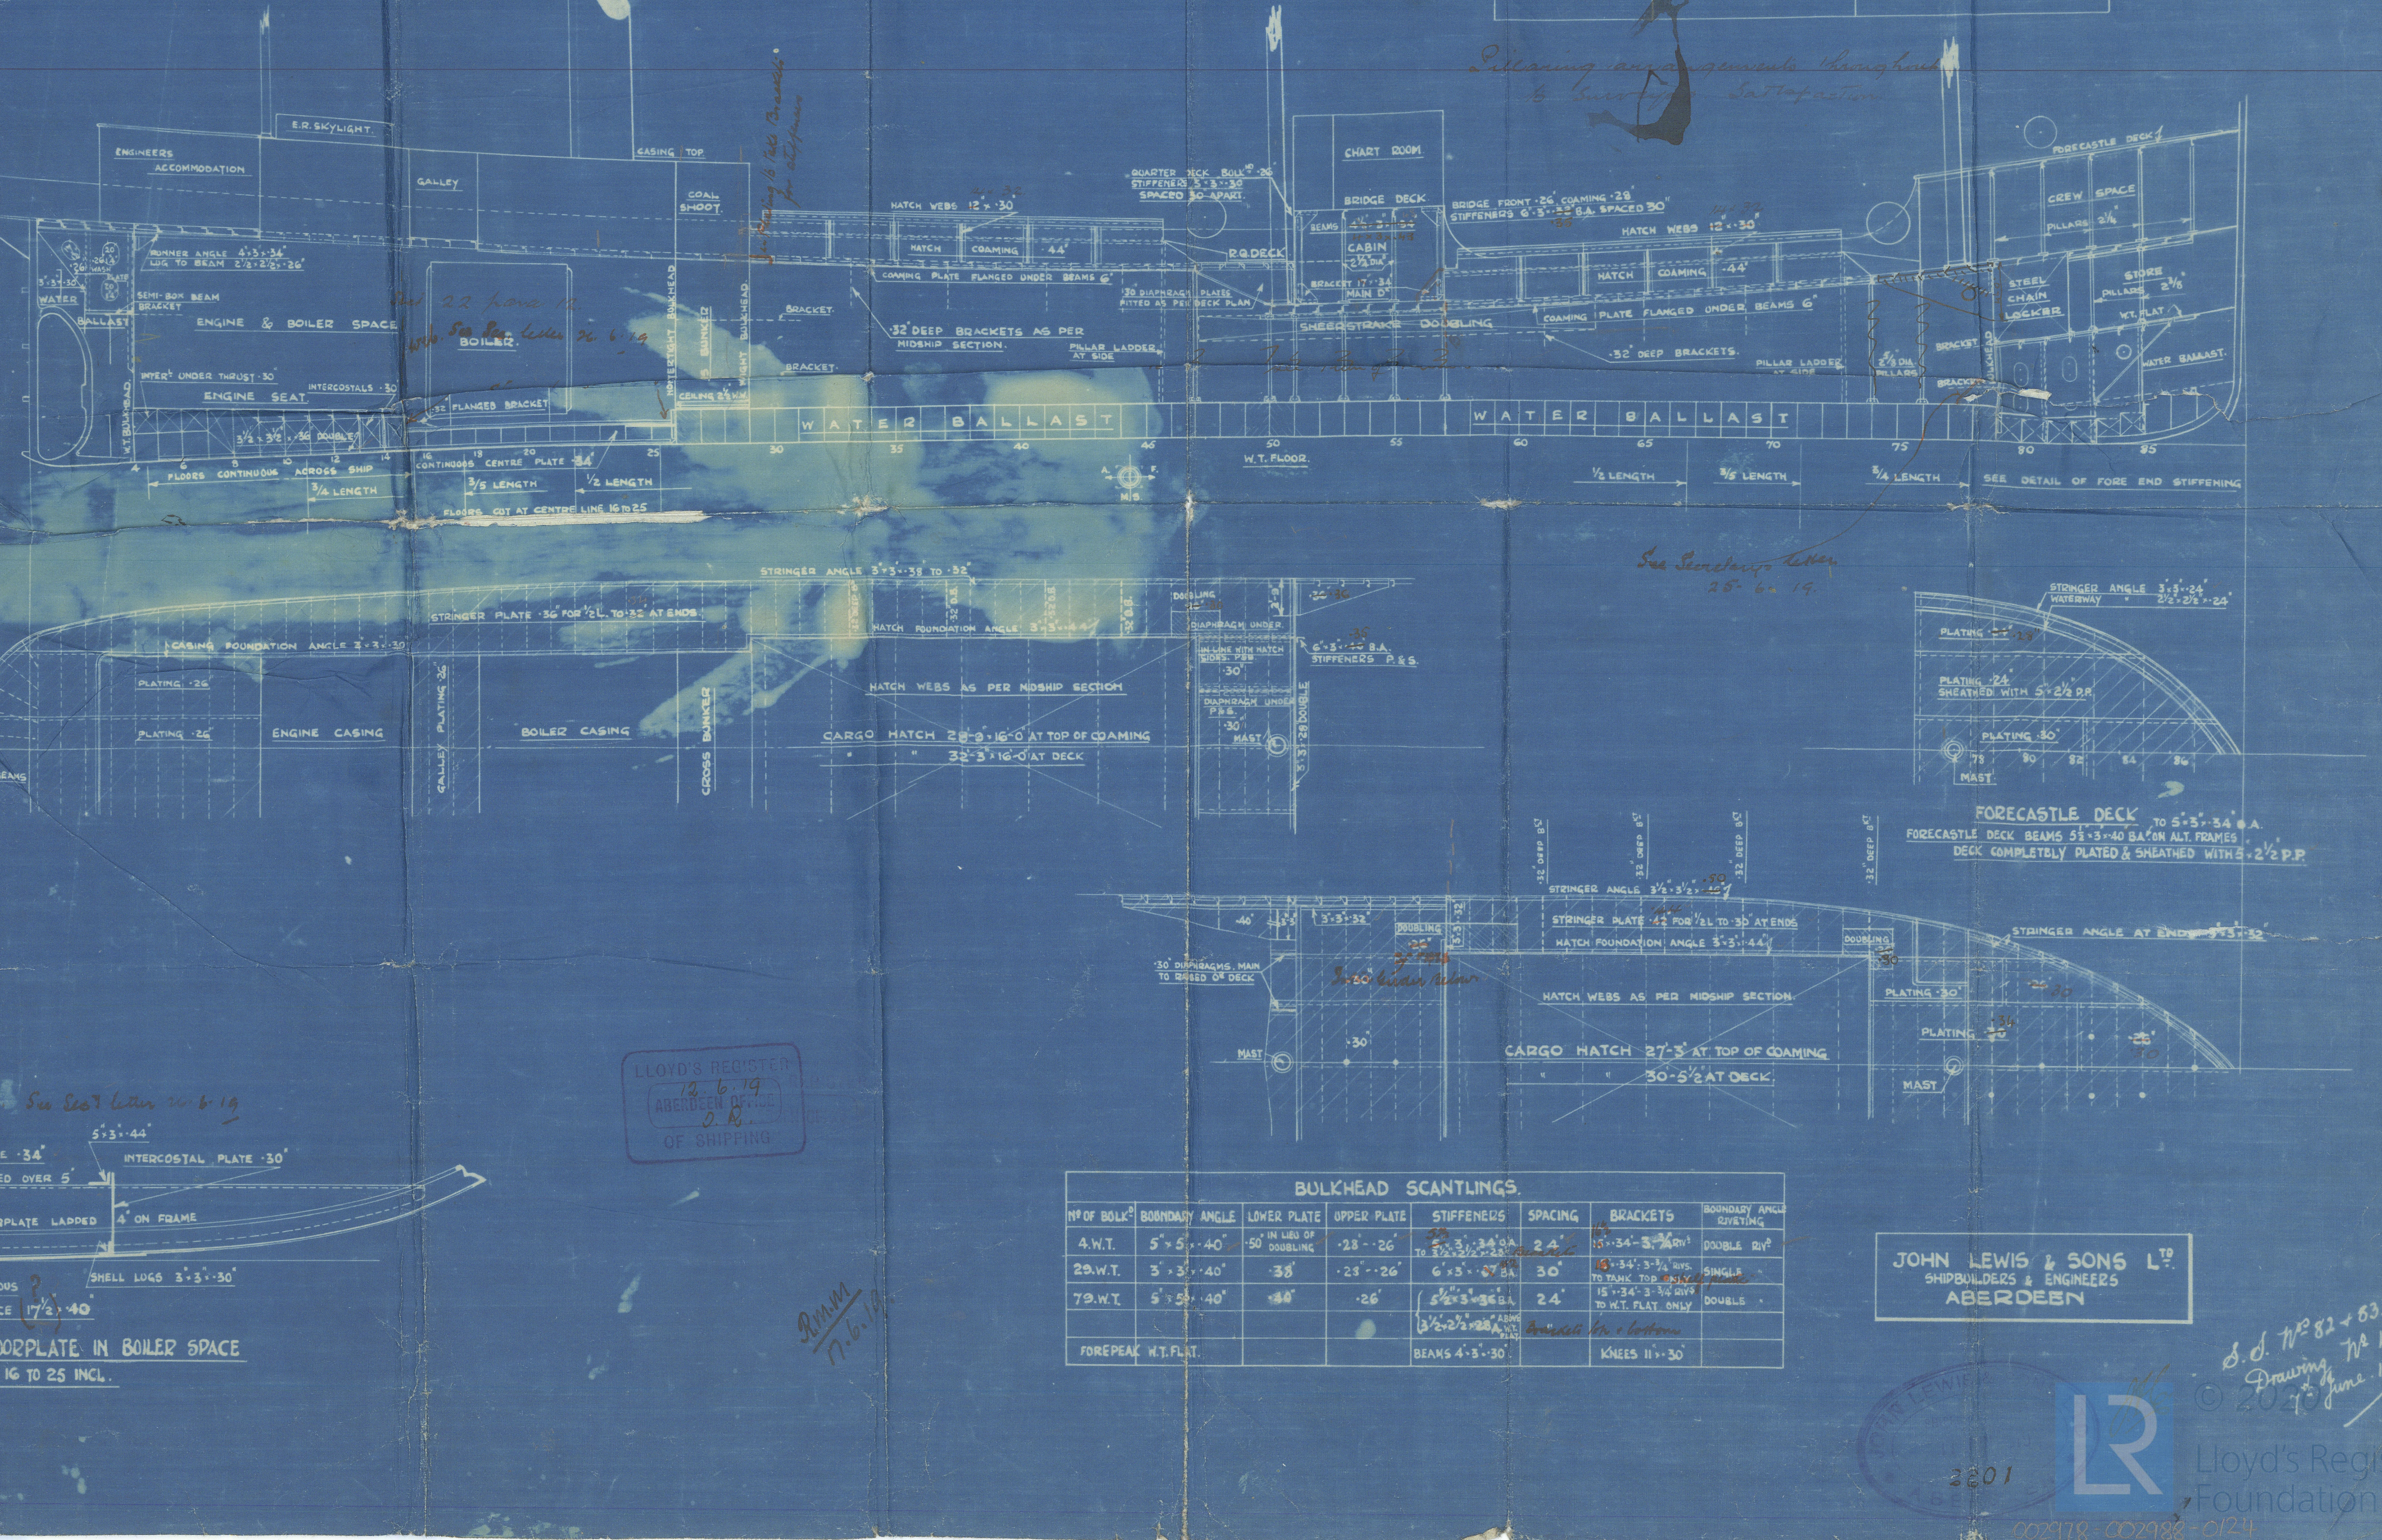

JOHN LEWIS + SONS LTD

N^{OS} 82 - 83 - 84.

PROFILE AND MIDSHIP SECTION.

"Banntrader"
~~EX~~


N^o 82. = "BEAULY FIRTH"

ABN. REPORT N^o = 12416.

BANNTRADER X.



ORTOLAN

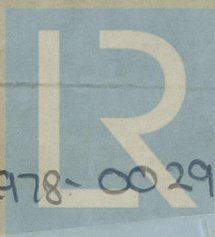

© 2020

002978-002988-0124

Lloyd's Register
Foundation