



Sketch of ends of bridge  
as lifted from inspection  
9-3-25

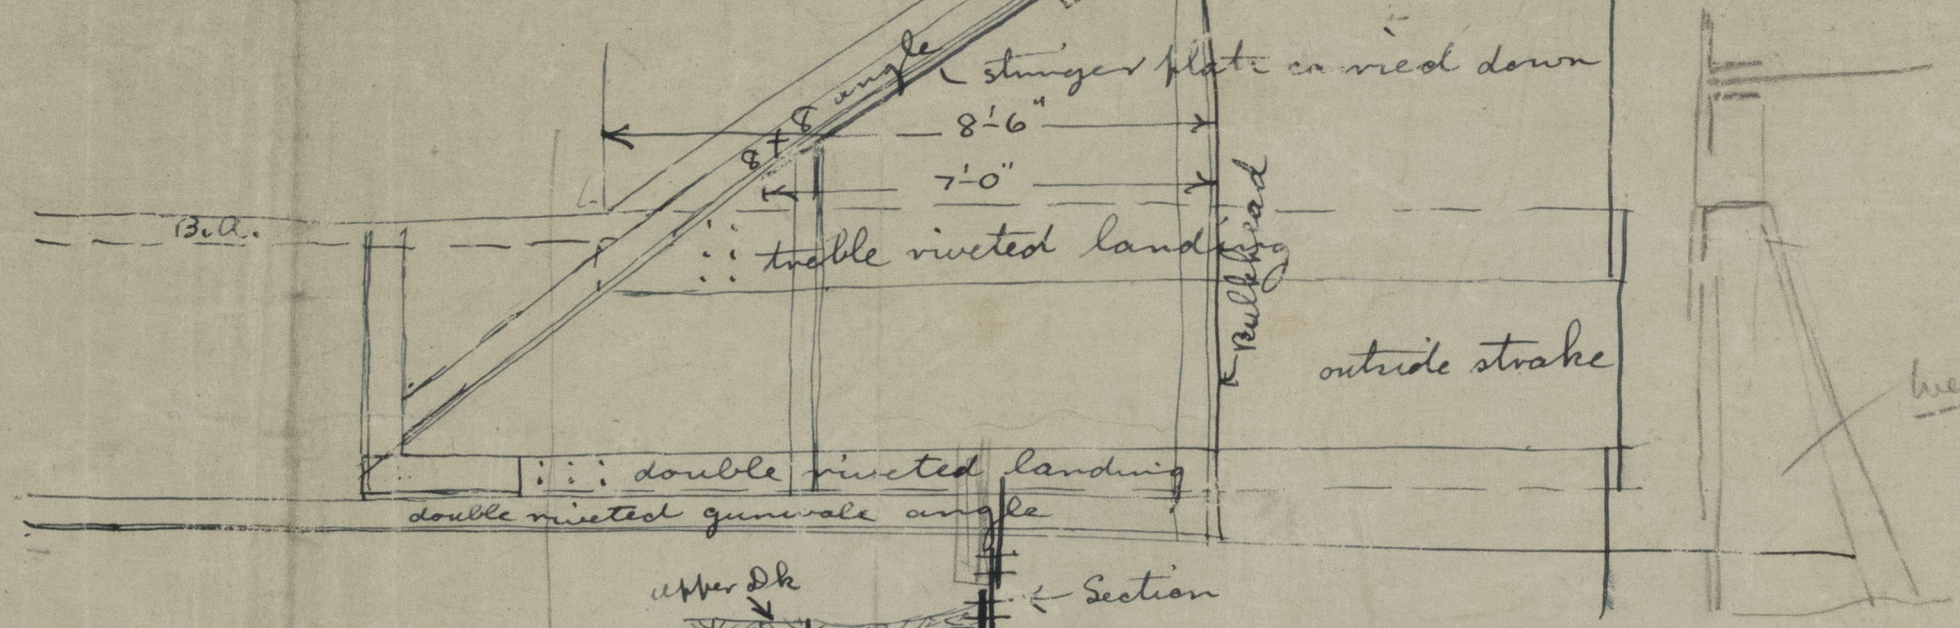

DETAIL SHOWING STRENGTHENING AT ENDS OF BRIDGE

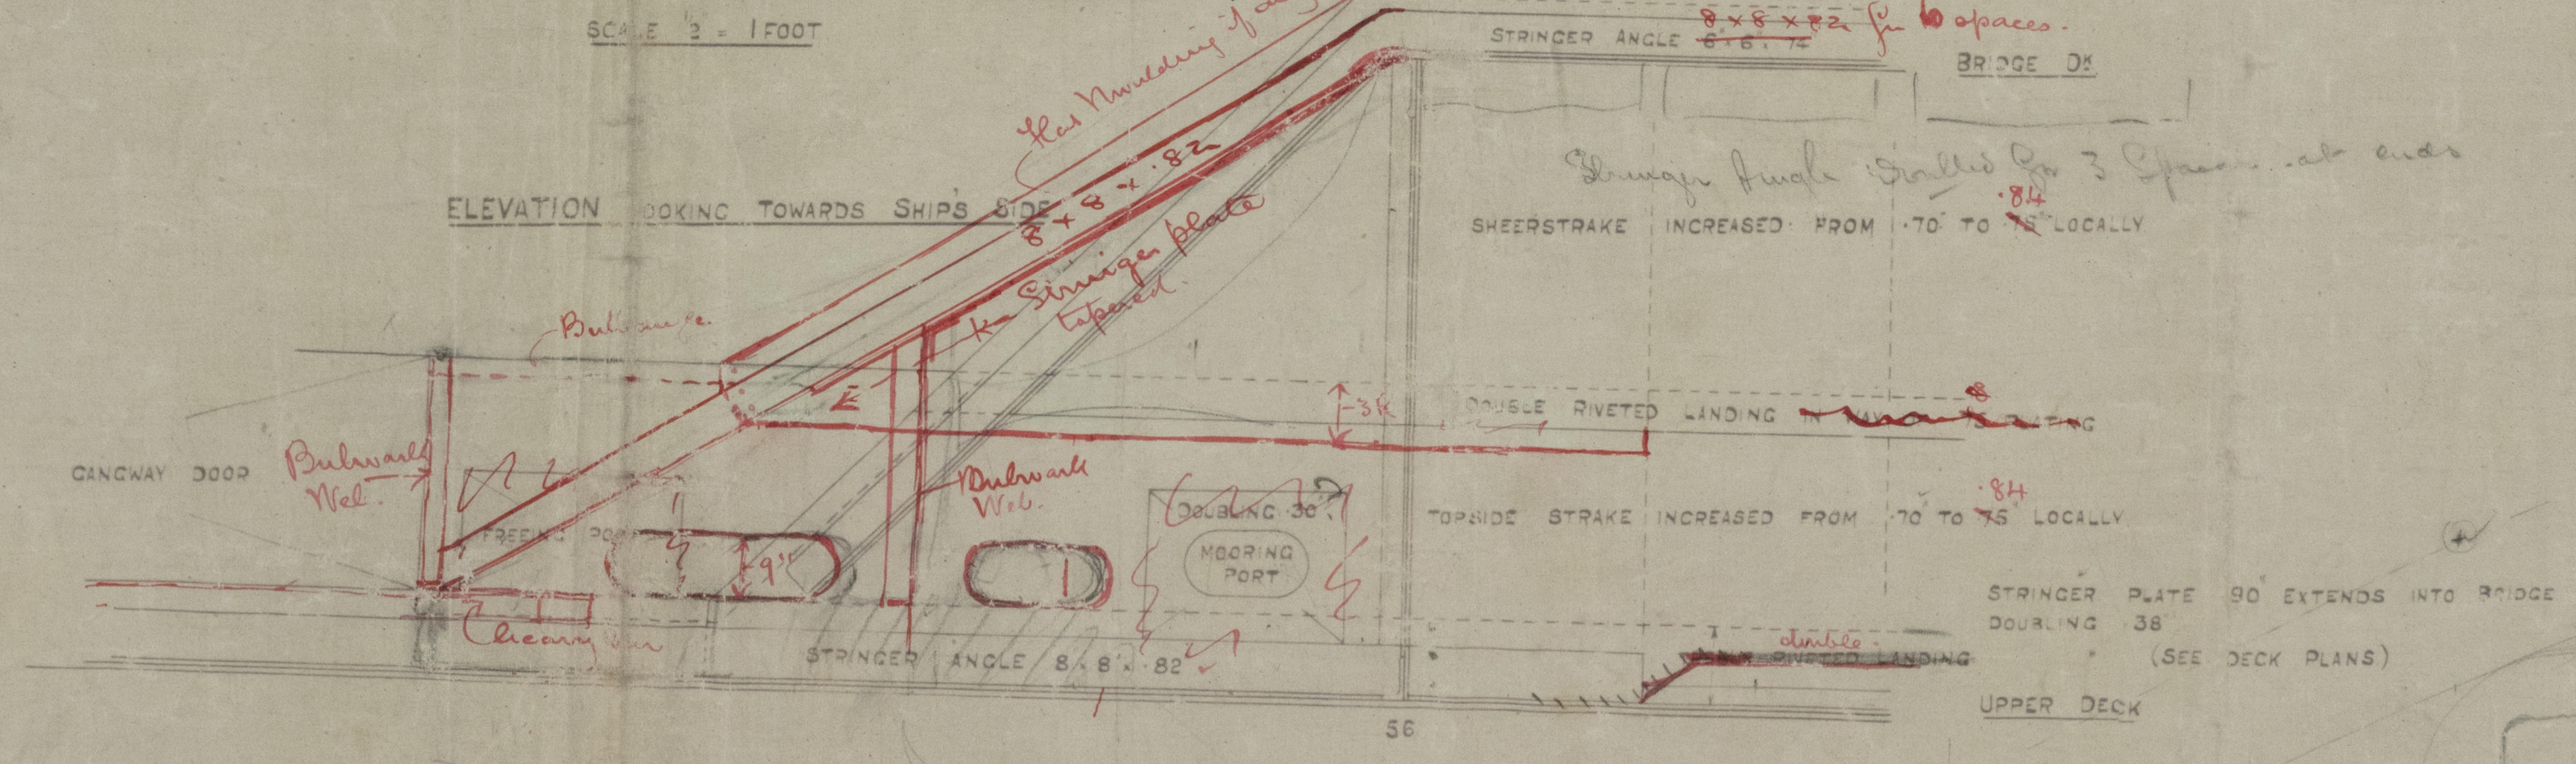


PROFILE.  
S. S. 465 x 59 x 33-4.  
SCALE 8" = 1' FOOT

LOAD DRAUGHT 25.41 FEET (WOULDED)

465  
12  
484

PILLARS & GIRDERS IN NUT HOLD  
ALTERNATIVE ARRANGEMENT

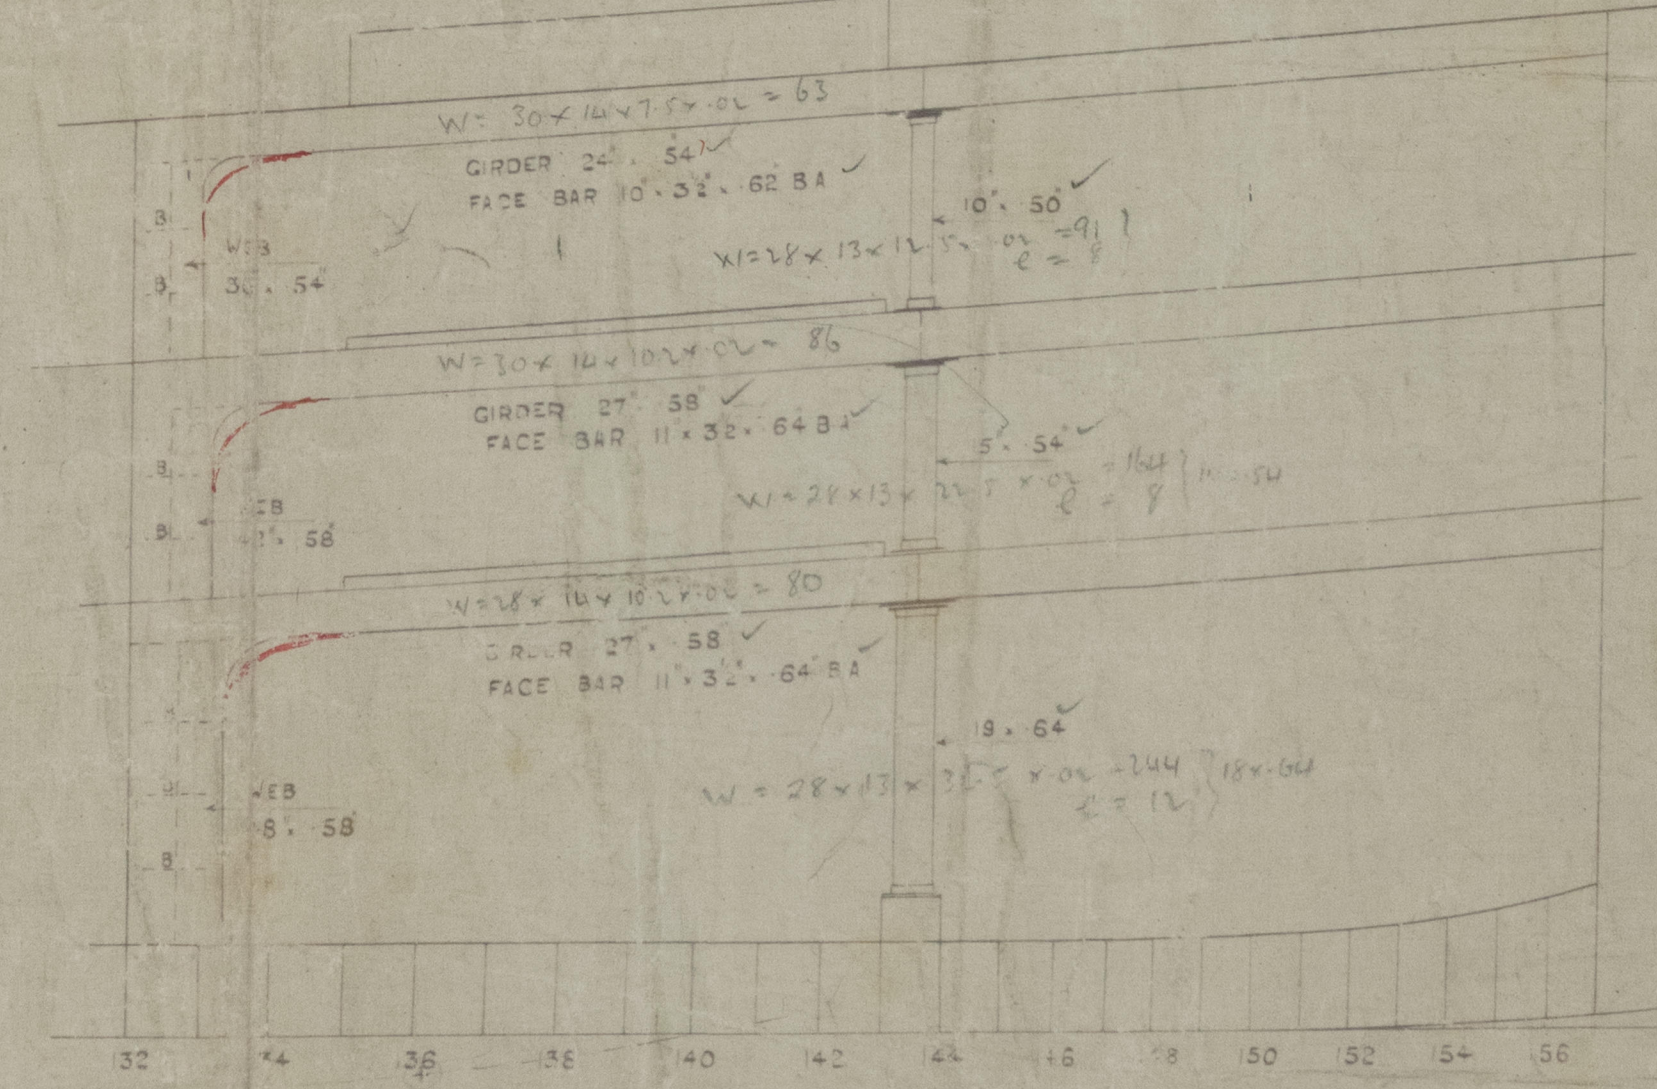

SOLID PLATES ON EVERY FRAME  
SOLID PLATES UNDER BOILER BEARING  
SOLID PLATES UNDER LOWER EDGE OF BULKHEAD STIFFENER BRACKETS

Approved  
See Letter 22-11-18



SS AMARAPOORA \*  
SS PEGU

profile  
Signed Copy

Y.L. 26 2 19

nn  
"Captain Hobson"

Hull

Denny's pro vessel

465' x 59' x 33'4  
1062

Profile

23-11-18

(3)

003013-003017-0043

© 2021

Lloyd's Register  
Foundation