

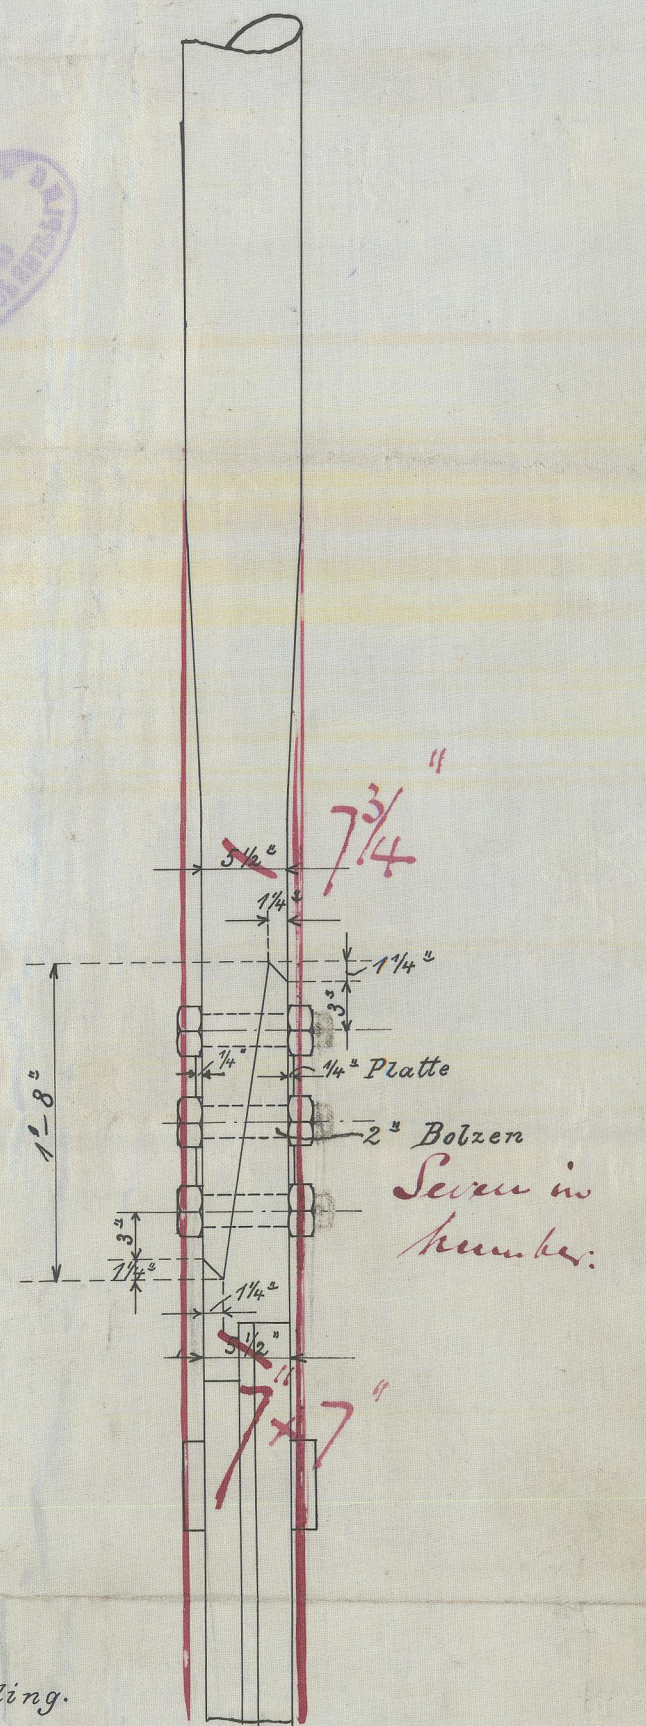


Maasse, englisch.

Ruder von hinten gesehen.

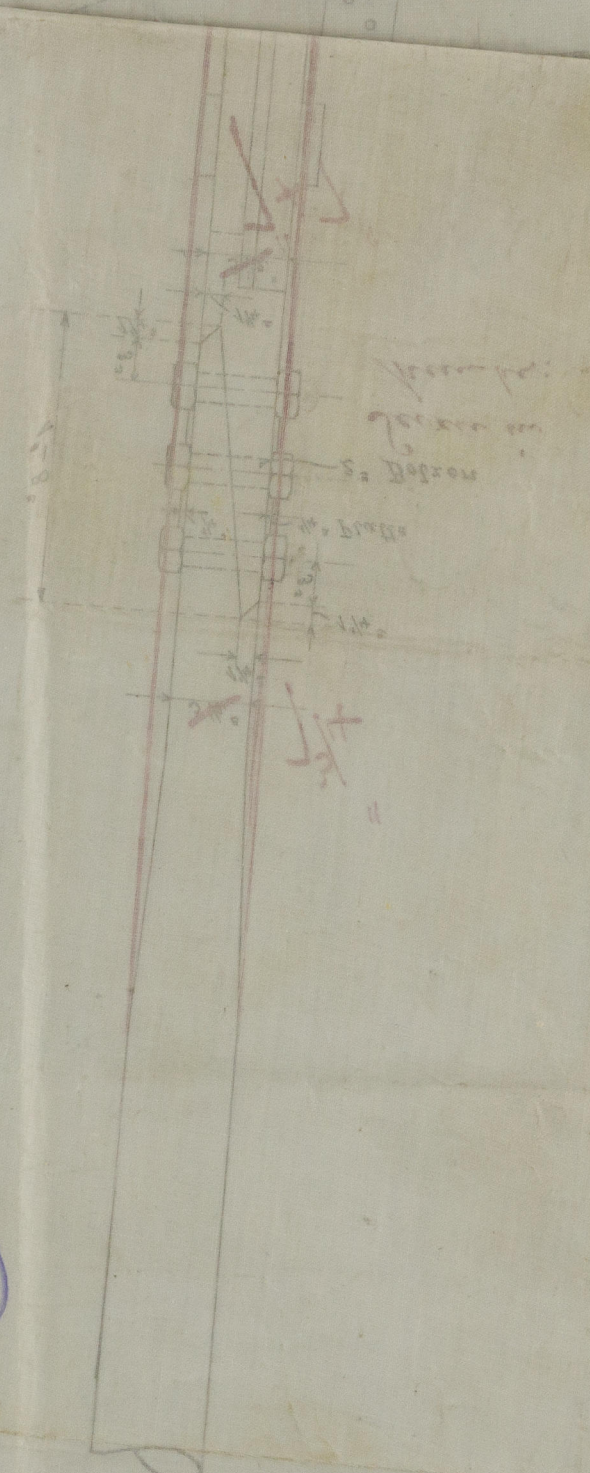

Rivets $1\frac{1}{8}$ dia^r $5\frac{5}{8}$ apart.

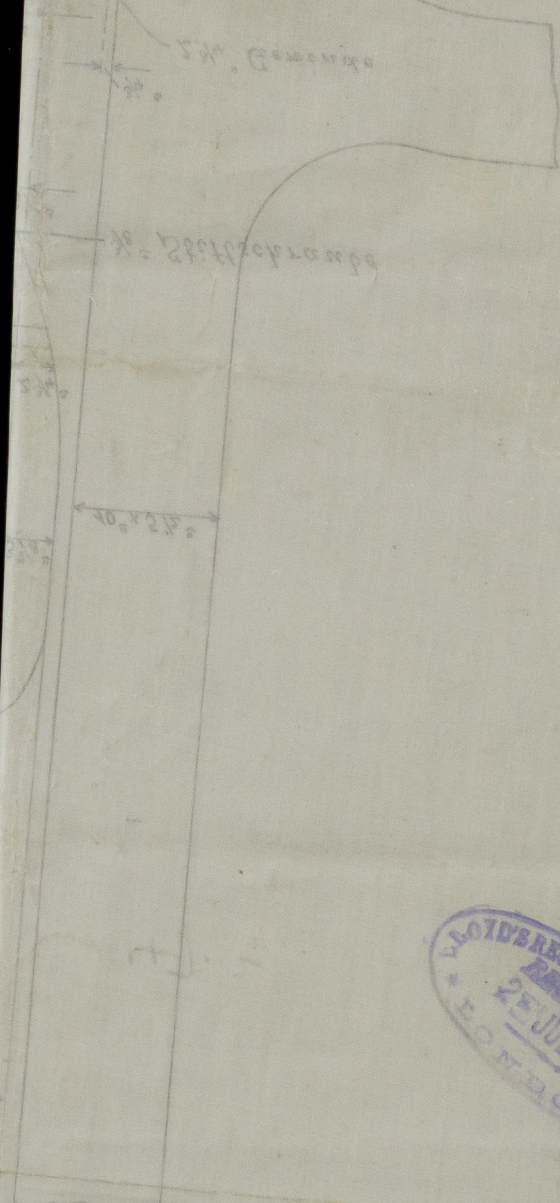

© 2021

Lloyd's Register
Foundation

Antikarstern & Co.

6.6.20.24


Elwine Kappen

Str 234

Stemframe Rudder

m/14 3.27
7.6

20.2.04
20.7.04

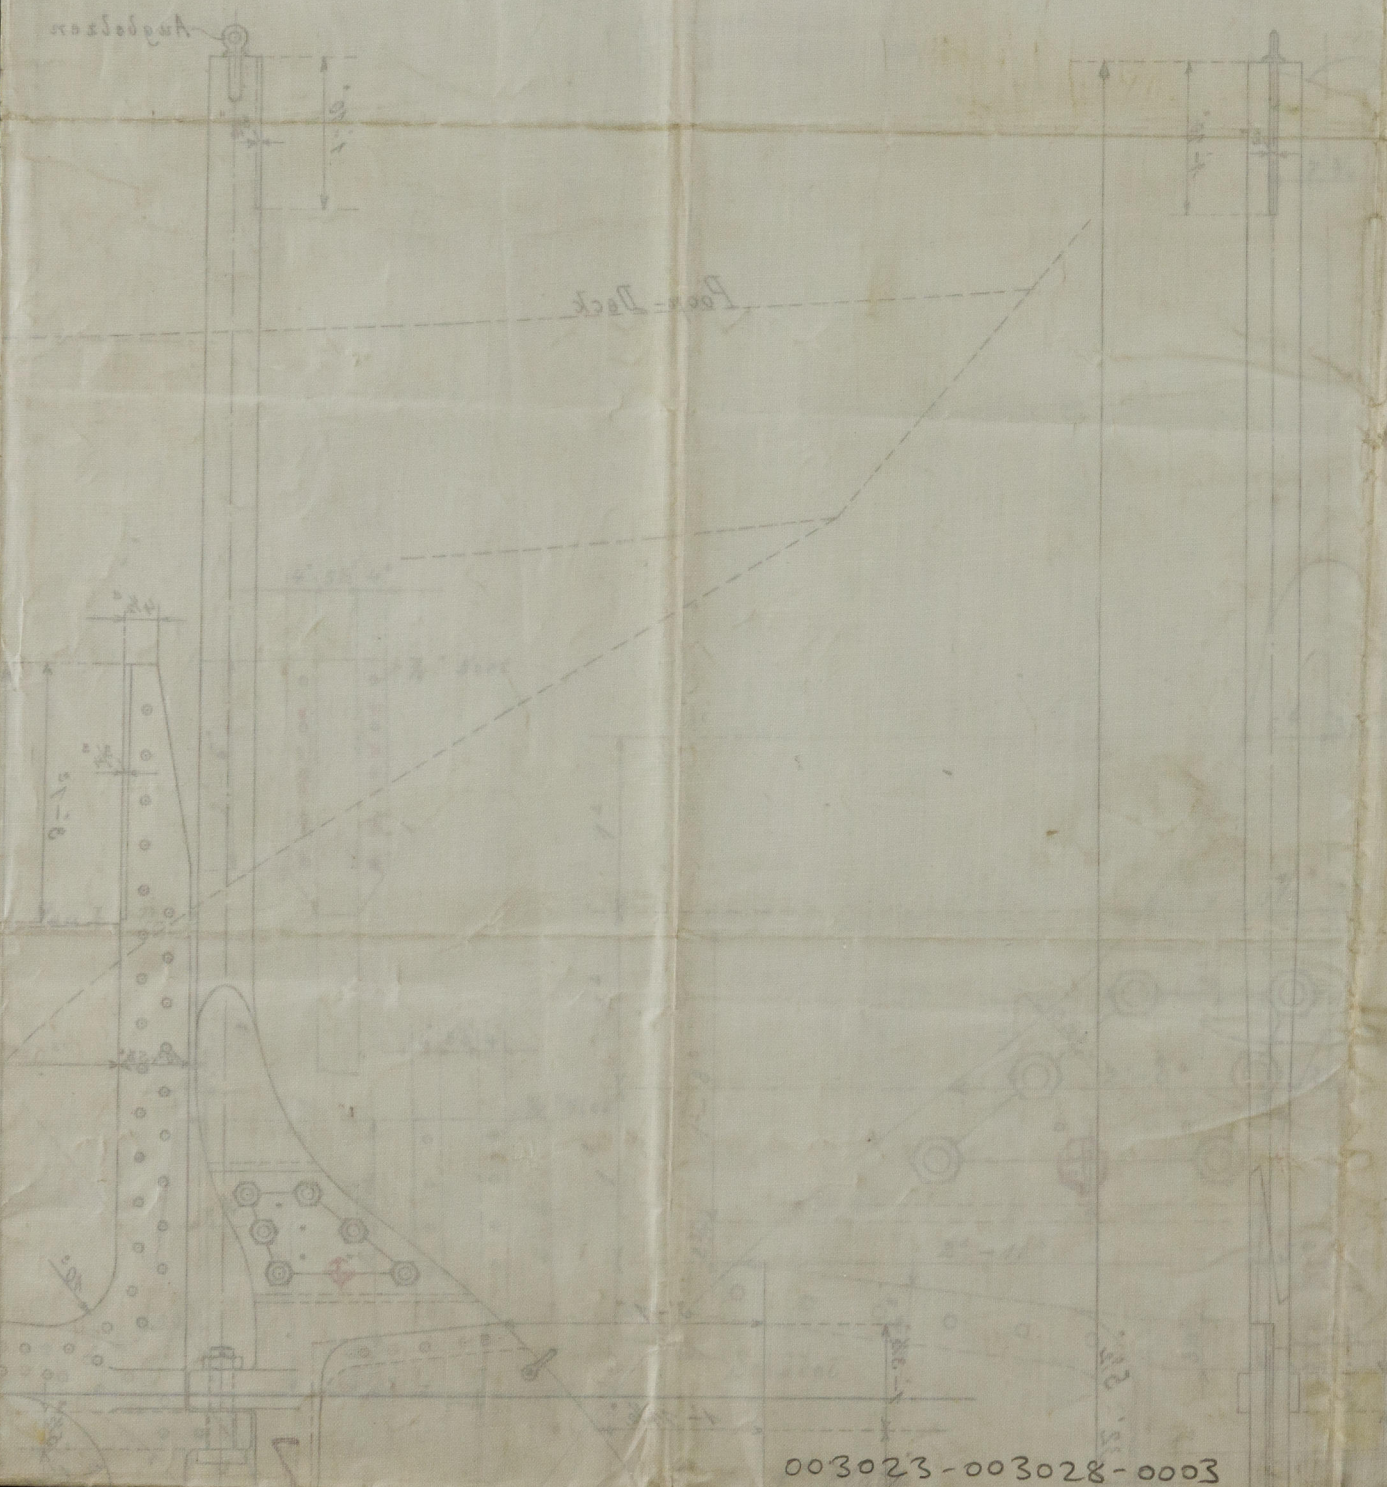

003023-003028-0003



© 2021
Lloyd's Register
Foundation