
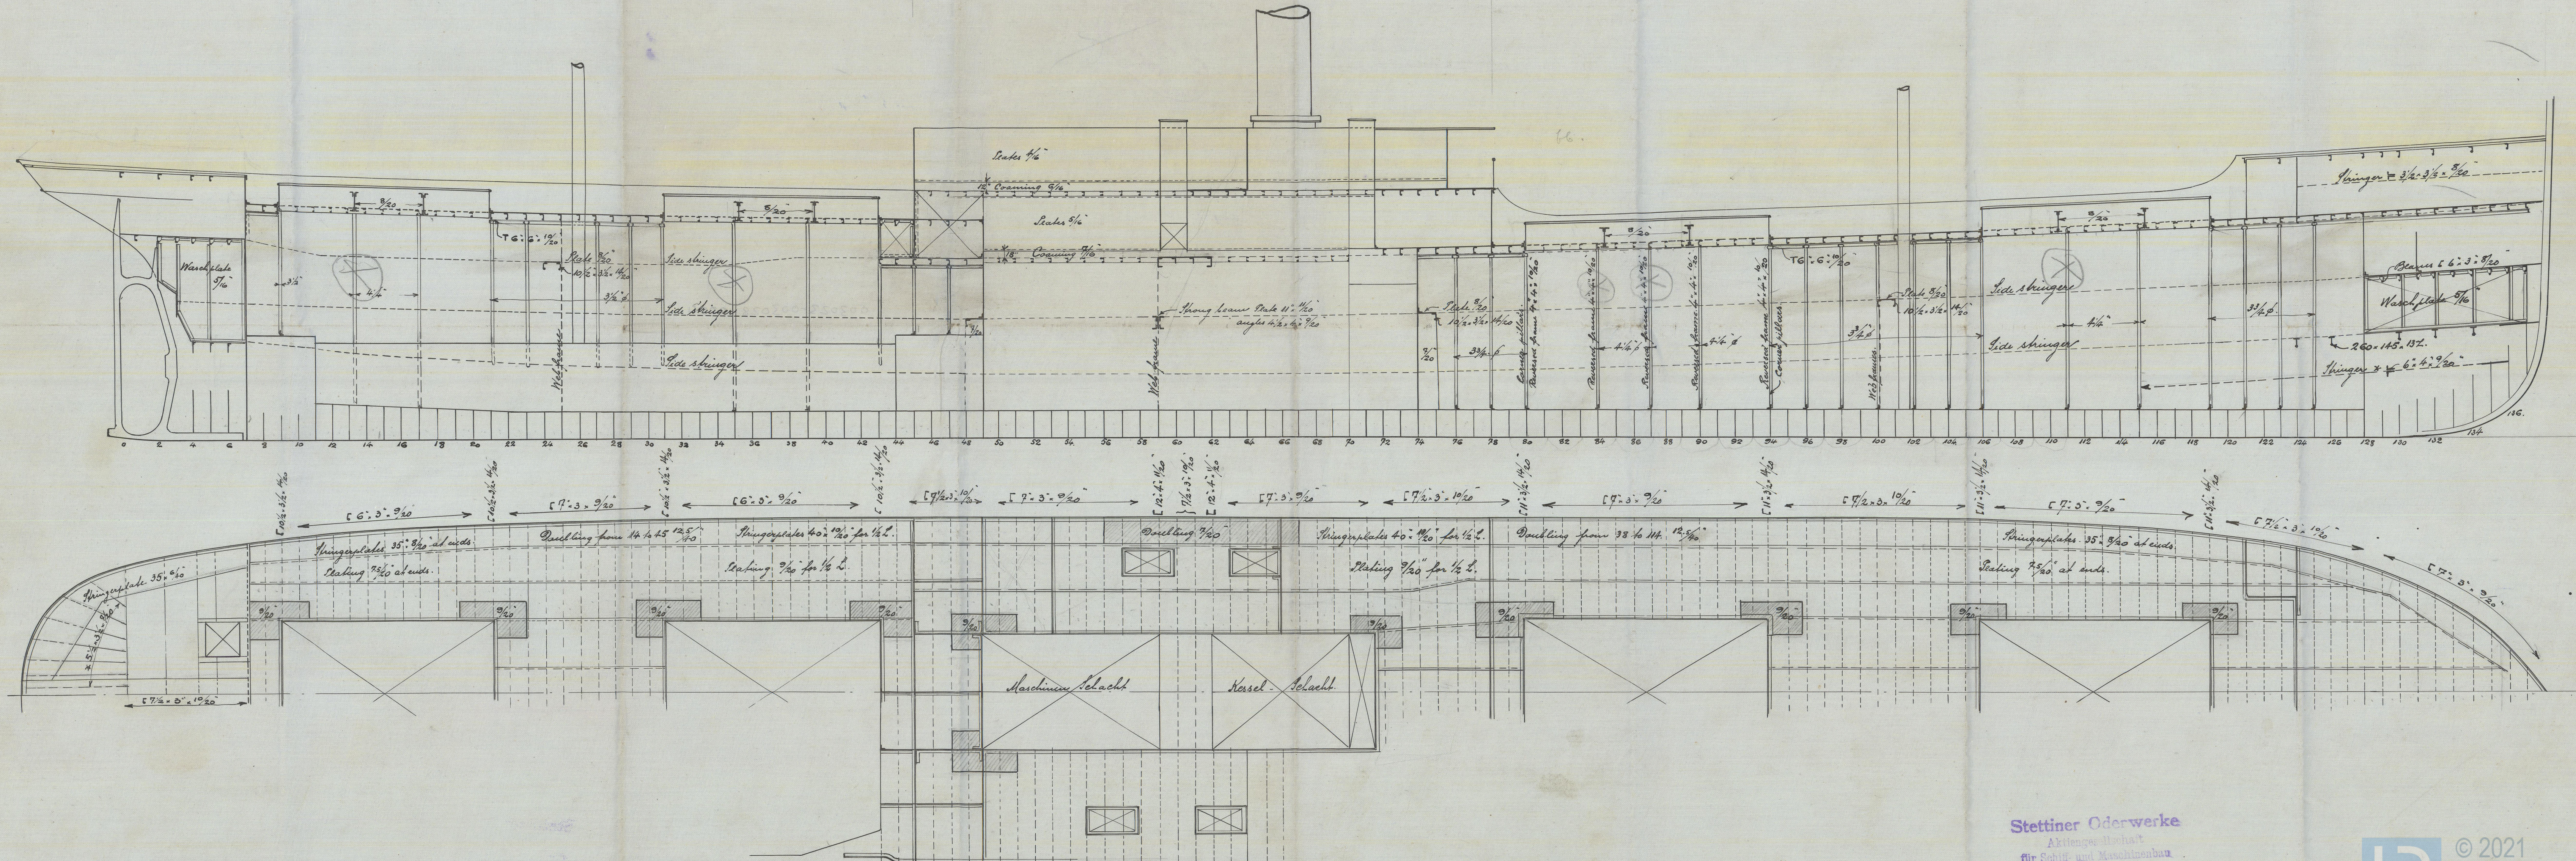


CORRECTED. PLAN

Dimensions.

Depth moulded. ----- 6.25. 4 ----- 20' 6" 4

1:100.

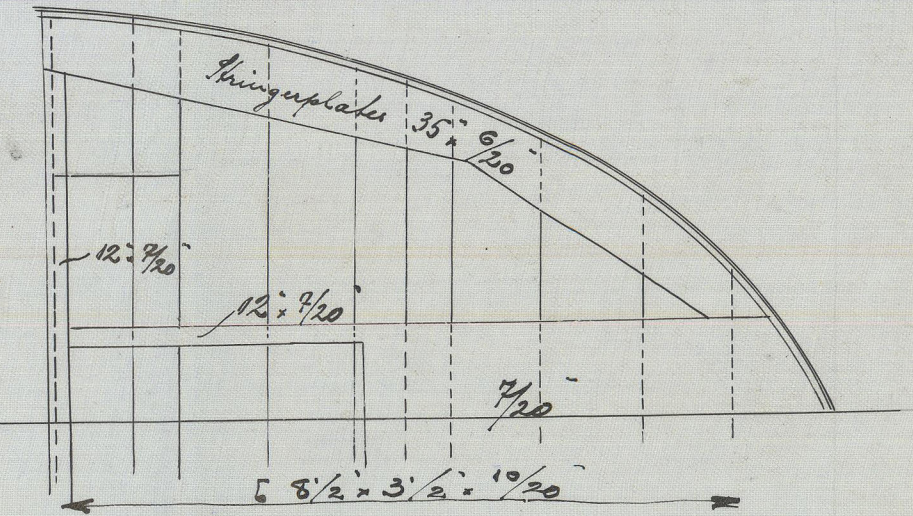

Stettiner Oderwerke
Aktiengesellschaft
für Schiff- und Maschinenbau

EX "Elwino Koppau
Stn 234

Now THORNBURY

Dimensions

79.21 35.26 4.1

Length between Perpend 79.21

Breadth moulded 35.26

Depth moulded 4.1

1:100.



© 2021

Lloyd's Register
Foundation

003023-003028-0004