


PROPOSED MODIFICATIONS
(MINIMUM SCANTLINGS REQ'D.)

12" x .75" FACEPLATE TO BE
FITTED ALL ACROSS BELOW
STRONGBEAM.

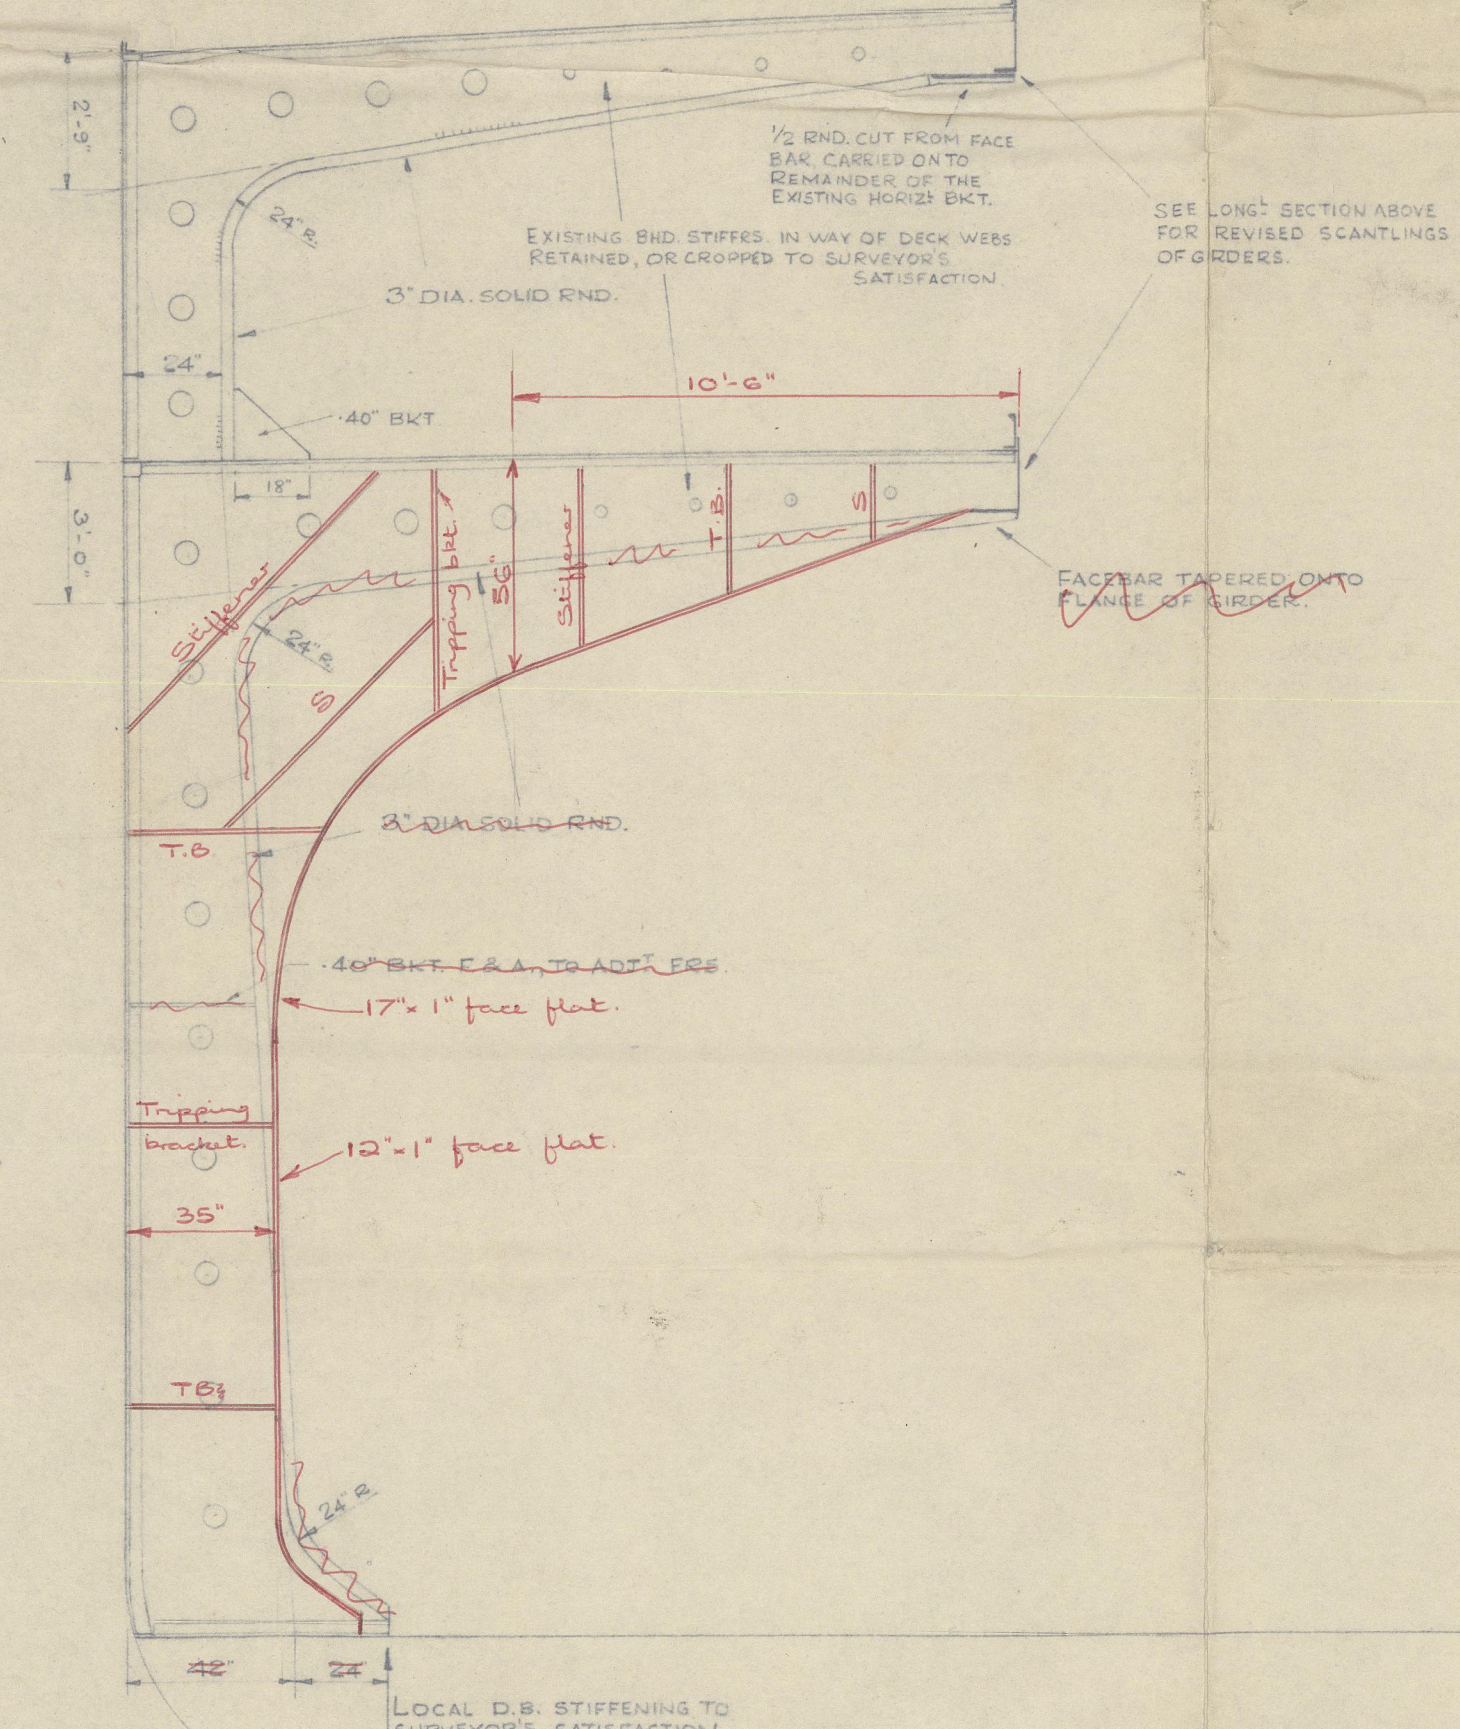

✓ Existing structure may ^{also} be used without alteration

ORIGINAL W.T.B. PLATING REMAINS TO FORM WEB,
EDGE STIFFENED & LIGHTNING HOLES CUT AS SHOWN.

WEB FR. TO PROVIDE ~~PARTIAL~~ GDR. SUPPORT ONLY

G.H.W
3.11.60

OWNERS REQUIRE THE WORK TO BE ACCOMPLISHED WITHOUT THE USE OF ADDITIONAL PILLARS.

5/8 "CAPE DREPANON"

(EX "AKTI HILL"
EX "FORT LA CLOCHE")

PROPOSED MODIFICATIONS TO STRUCTURE
IN WAY OF NP 3 HOLD

SCALE: 1" = 1/4" x 1 FT

L.B.P.	416' - 0"
BE. EXT.	57' - 2"
D.MLD. UPPER DK.	37' - 4"
" " 2ND "	28' - 7"

VEROLME CORK DOCKYARD LIMITED

© 2021

Lloyd's Register
Foundation

003023-003028-0082

DUBLIN REPORT to 9020

SS/MS " CAPE DREPANON "	
TO ACC	Sub rpt. No. 9070
Dated 1-1-61.	
SUBJECT	Proposed modifications to structure remains of W. S. Gold.



© 2021

Lloyd's Register
Foundation

003023-003028-0082