

To go with Val. Rpt N° 576
 Deck repairs
 Feb - June 1954
PL

CABO DE HORNOS


DECKS
CUBIERTAS

±: 1/200

Plates renewed.
 Planchas reemplazadas

A-Deck
CUBIERTA "A"

Prom. Deck
CUBIERTA DE PASEO

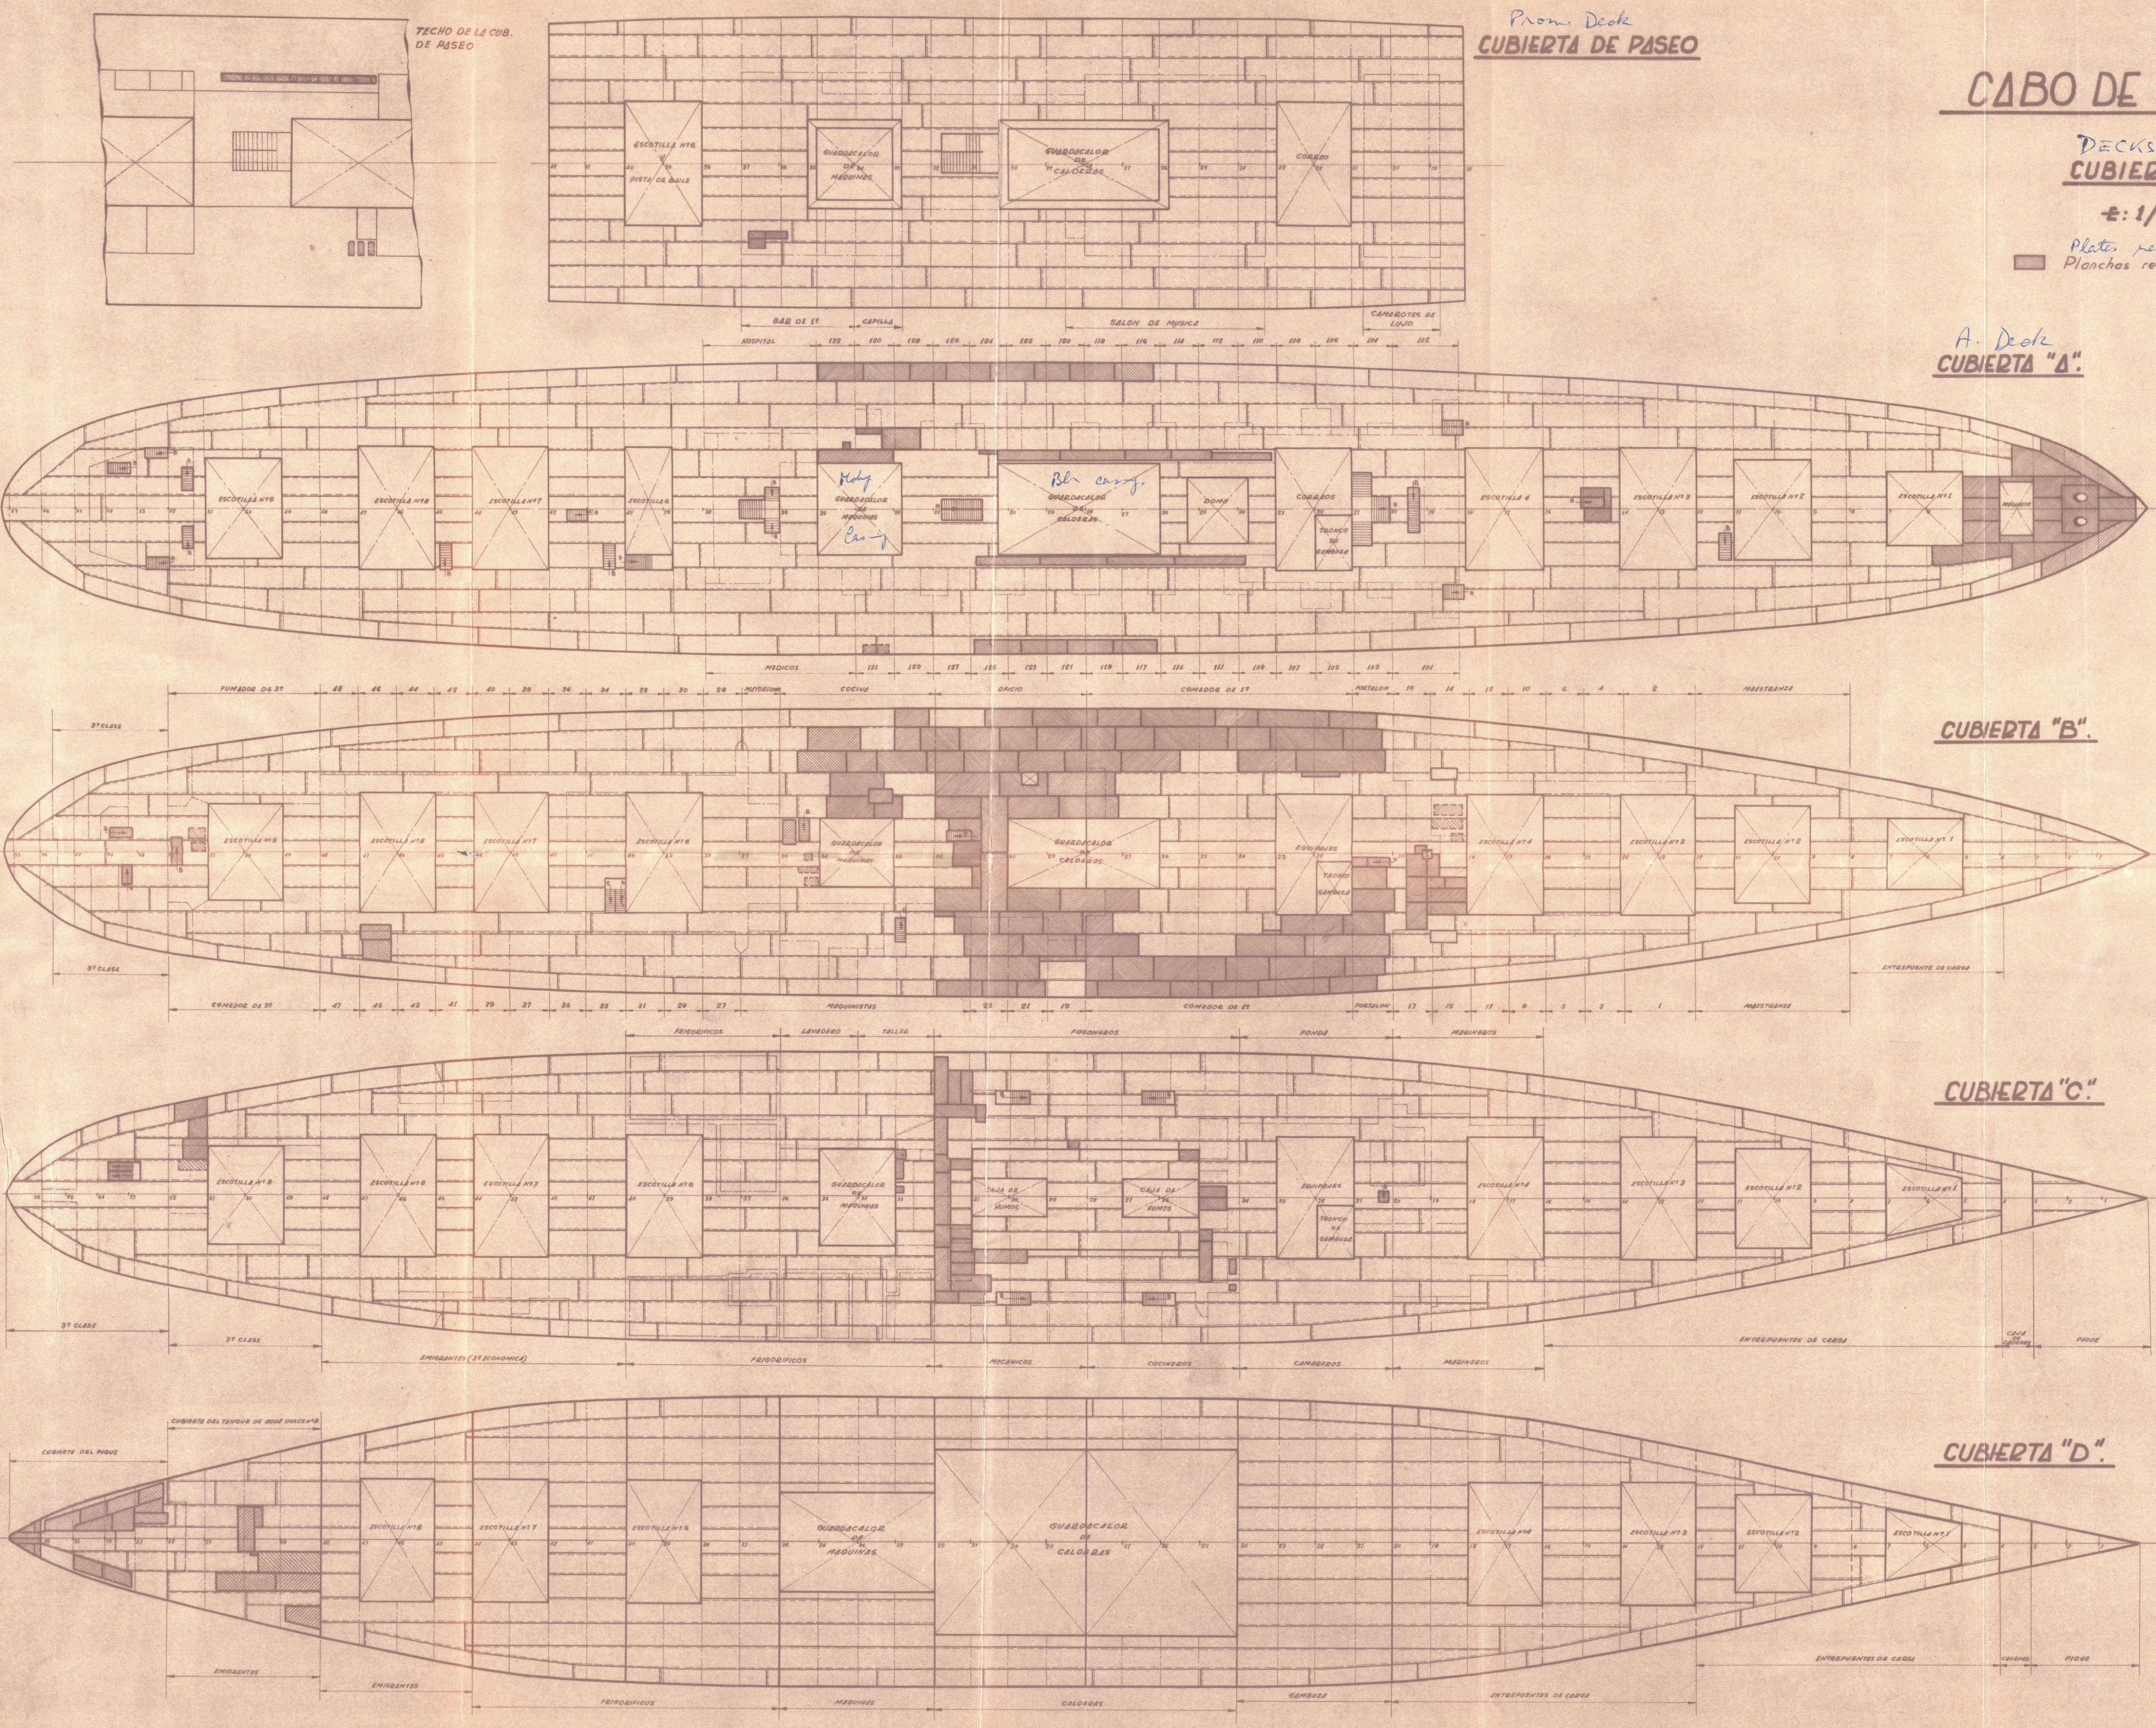

¹ CABO DE HORROS ⁴
Valencia 516



© 2021

Lloyd's Register
Foundation

003065-003074-0143