

3673.8

## Lloyd's Register of Shipping. 26 OCT 1954

Ship's Name " BASEDALE ".

Official No. 168256.


Memorandum of alterations reported since ship was surveyed for assignment of Load Lines in

Watertight hatch has now been fitted on Upper deck starboard side forward to

Fire pump compartment in forward hold.


21'-2" x 22", 9" B.A. coaming with steel cover, grease packing and toggles.

Doubling plate fitted on deck in way of opening.

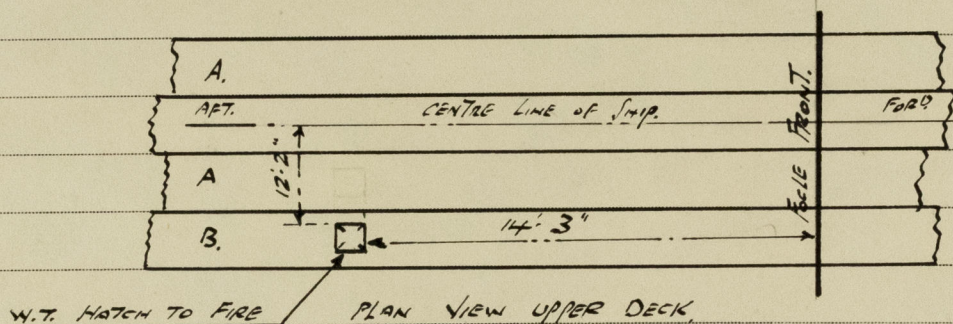

W.T. HATCH TO FIRE  
PUMP COMPARTMENT.

*W. Henderson*

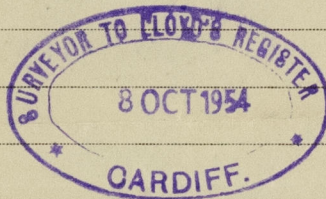

The original has been placed on board.

*Mr. Bennett*

*11 NOV 1954*

*Doubtless (better see plans)*