

# MIDSHIP SECTION

## S/S. CONSTANTINOS XII.

SCALE  $\frac{1}{2}$ " = ONE FOOT

TO CLASS 100 A.I. AT LLOYDS


DIMENSIONS  
LENGTH B.P. 380'-0"  
BREADTH EXT. 51'-6"  
DEPTH MLD. 25'-6"

POOP SCANTLING

BEAMS 6" x 5" x 10" ON EVERY FRAME.  
1 ROW PILLARS, 2" x 8" DIAM. STRINGER 36" x 54" TK.  
STRINGER ANGLE 3" x 5" x 54" STEEL DECK 30" TK.  
SIDE PLATING 36" TK.

FORECASTLE SCANTLING

BEAMS 6" x 5" x 10" ON ALT FRAMES 2 ROWS PILLARS 2" x 8"  
STRINGER 36" x 54" STRINGER ANGLE 3" x 5" x 54"  
WOOD DECK 30" P.P. SIDE PLATING 40" TK.

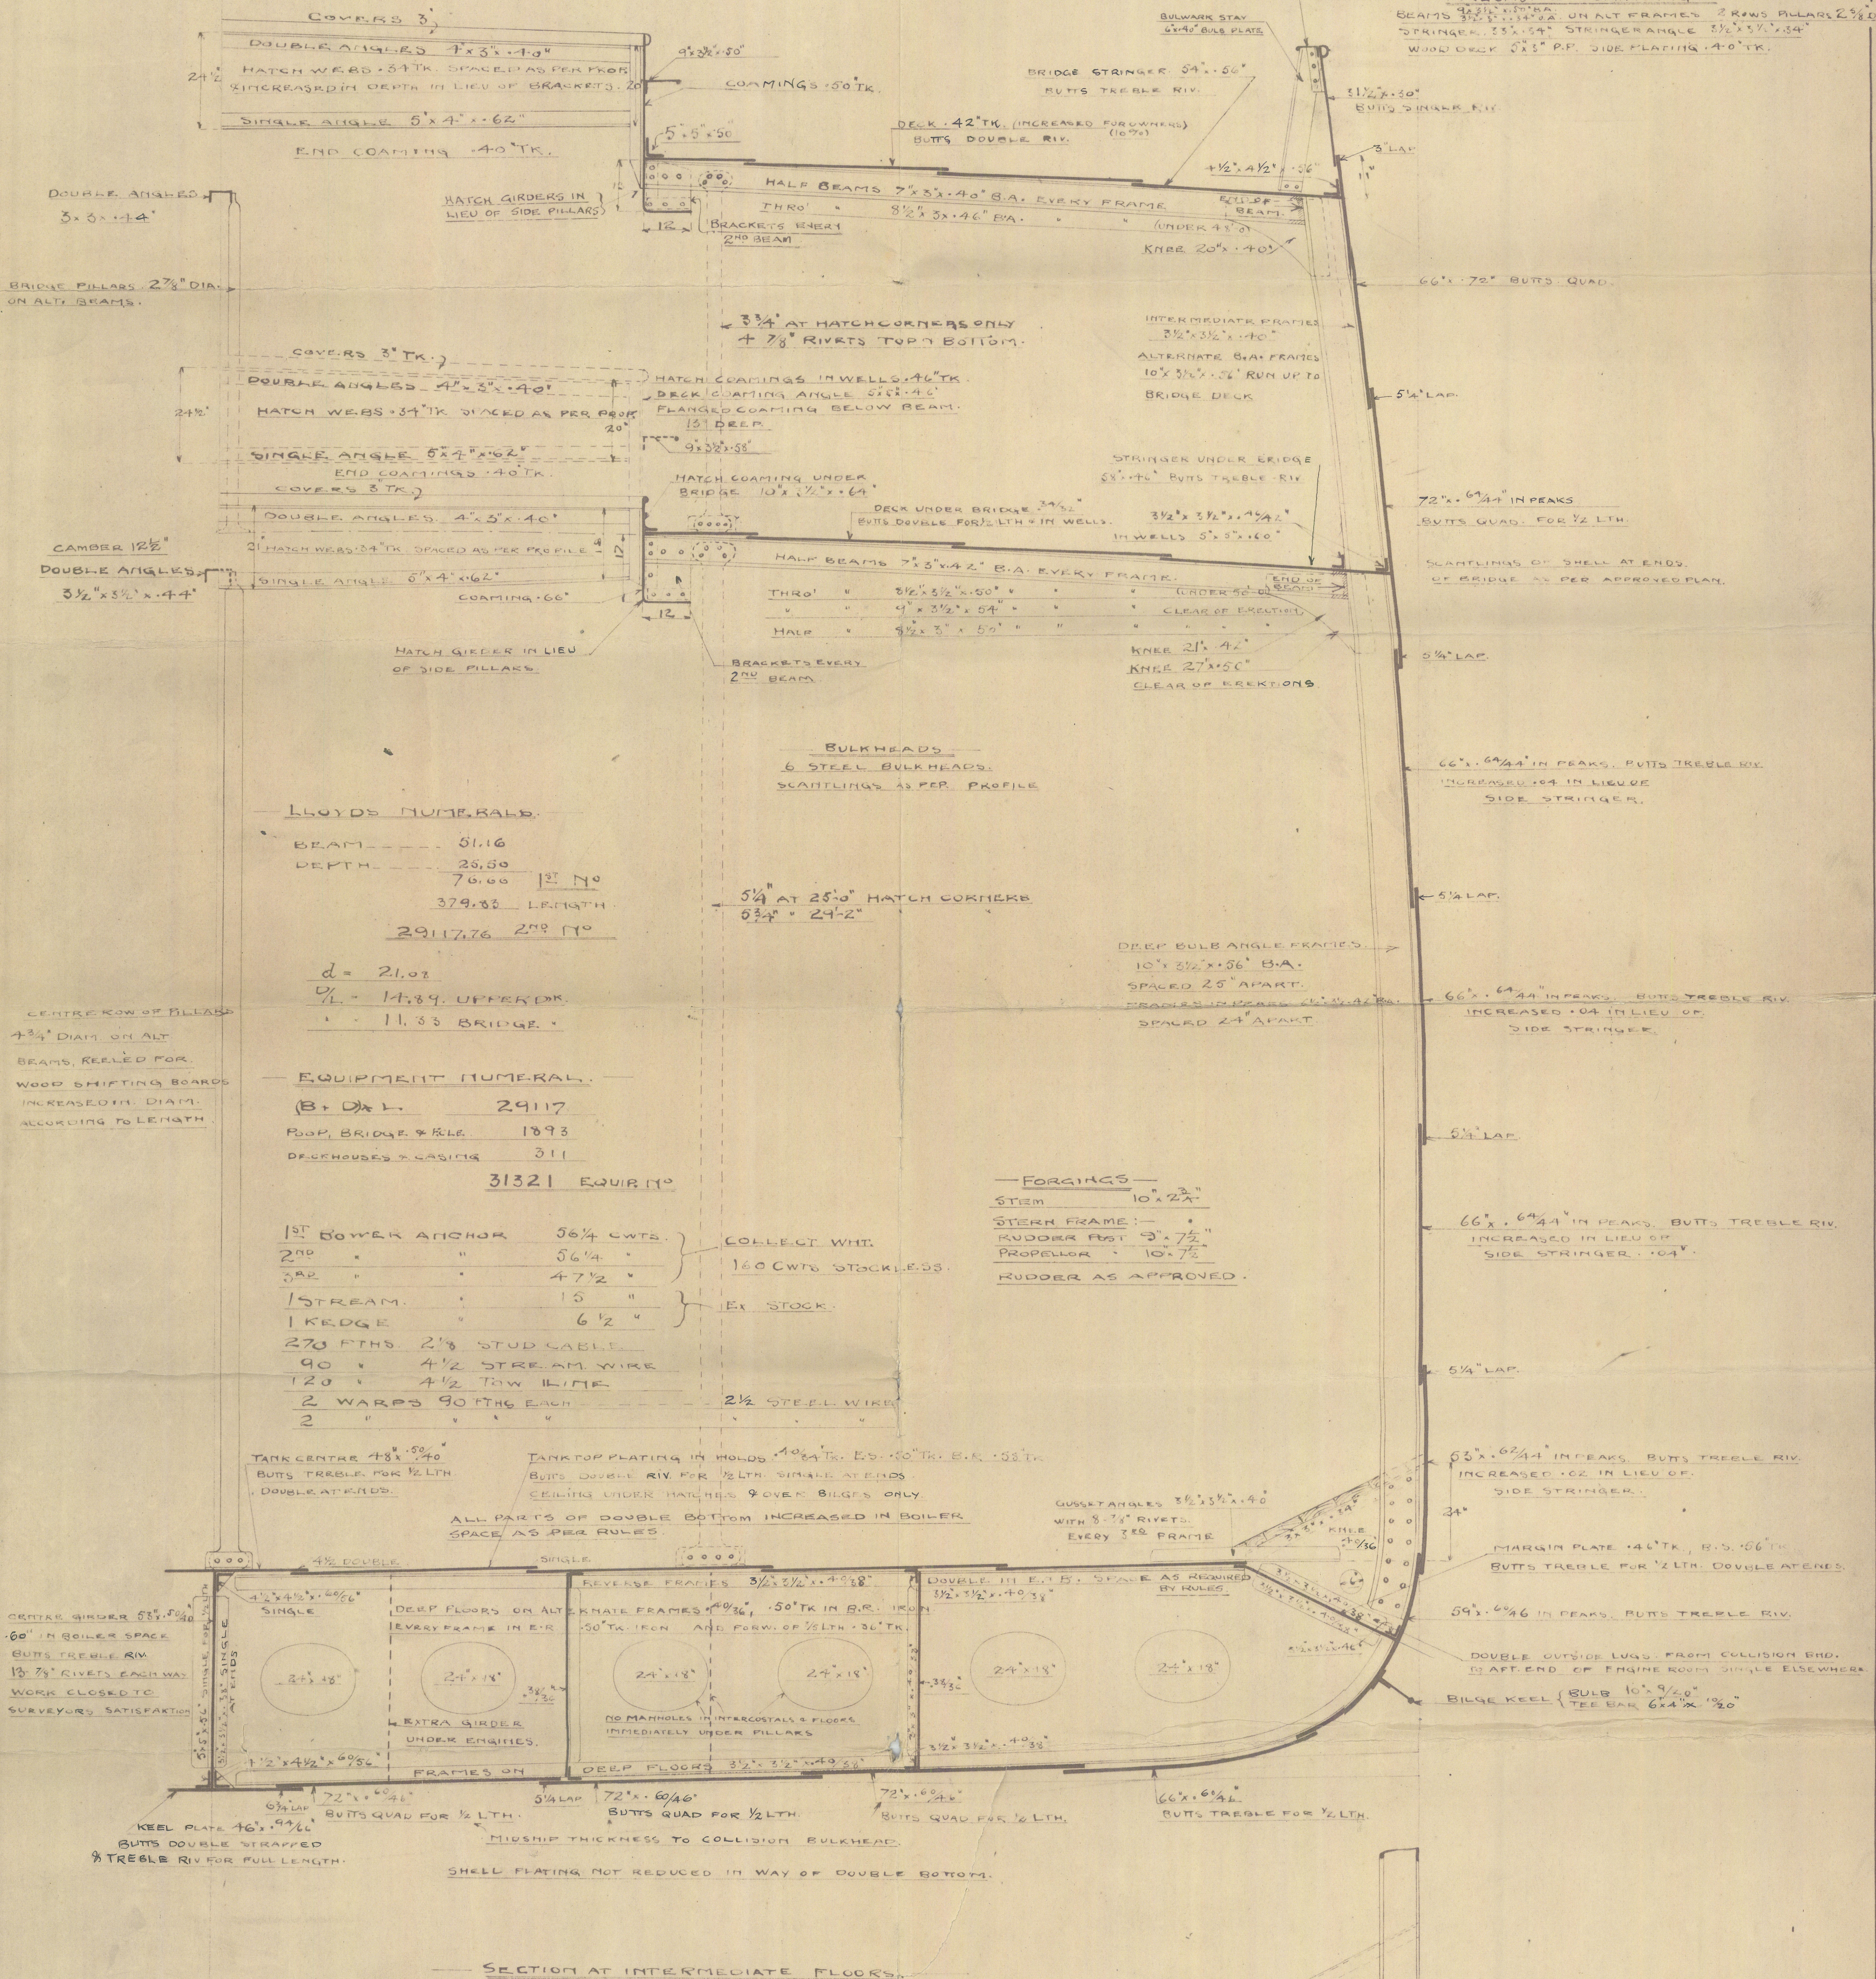

LLOYDS NUMERALS

BEAM 51.16  
DEPTH 25.59  
76.66 1<sup>st</sup> NO  
379.88 LENGTH  
29117.76 2<sup>nd</sup> NO

d = 21.02

11.89 UPPER DECK  
11.33 BRIDGE

EQUIPMENT NUMERALS

(B + D) x L 29117  
POOP, BRIDGE & B.L. 1893  
DECKHOUSES & CASINGS 311  
31321 EQUIP NO

1 <sup>st</sup> BOWER ANCHOR	56 1/4 CWTs.	COLLECT WHIP 160 CWTs STOCKLESS
2 <sup>nd</sup> "	56 1/4 "	
3 <sup>rd</sup> "	47 1/2 "	
1 <sup>st</sup> STREAM	15 "	EX STOCK
1 <sup>st</sup> KEDGE	6 1/2 "	
270 FTHS. 2 1/8" STUD CABLE		
90 " 4 1/2" STREAM WIRE		
120 " 4 1/2" TOW LINE		
2 WARPS 90 FTHS EACH		2 1/2" STEEL WIRE
2 "		

FORGINGS

STEM 10" x 24"  
STEM FRAME 10" x 32" x 56" B.A.  
SPACED 28" APART.  
RUDDER POST 9" x 7 1/2"  
PROPELLER 10" x 7 1/2"  
RUDDER AS APPROVED.

JOHN PRIESTMAN & CO

SHIPBUILDERS

SUNDERLAND



© 2020

Lloyd's Register Foundation




"S.S. CONSTANTINOS XII"

PRIESTMANS N<sup>o</sup> 246


MIDSHIP SECTION (AS FITTED)

SLD RPT N<sup>o</sup> 25997

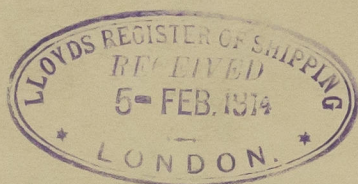

*hoemi*

"Alex"

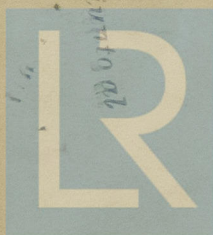

© 2020

Lloyd's Register  
Foundation

003083-003091-0198