

YARD No 83 - ARRANGEMENT OF THE FORWARD END - SCALE 1:50.

ALL BULB SECTIONS ARE BASED ON THE 1924 STANDARDS



Gdenae. 83  
 Amended Fore End. Arrangement  
 Appl. Apr 2/12/38

ODENSE STAALSKIBSVÆRF  
VED A. P. MØLLER  
28/11 38978

2/12/38.

1:50  
4-10-58  
MK.  
OK

~~CORRECTED BY LLOYD'S APPROVED PLAN 12-10-38 WK.~~  
~~P.N.V. 22-10-38 WK.~~  
CORRECTED BY LLOYD'S LETTERS 5/11/38 L.I.  
003092-003099-010




Tou und arrangement.

for  
Yard No 88.  
Odense Staalsskibs værft & S,

⑨ Bense

\* m/s. Marine Mærsk af Fredericia  
Copenhagen Report No. 11756.

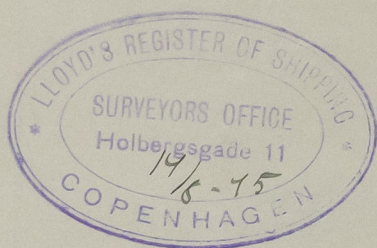

© 2020

Lloyd's Register  
Foundation

003092-003099-0102