

3/2/28


No 504.

LONGITUDINAL SECTION.

Scale $\frac{1}{8}'' = 1'-0''$

MA Dimensions 452'-57'-9" x 34'-6" Upper

To CLASS+100 A-1 Lloyd's.

 

W.J.
3.12.28.


W. Clarke. 504

Amended Outline Profile

app'd 3/12/28

See later Approved Profile
for Amended Scatterings of Framing

"City of Lancy."

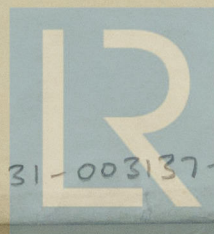

© 2020

Lloyd's Register
Foundation

003131-003137-0048