

Rpt. 11b.
Kota Sunda 32480
Kota Sunda 32758
GVERNMENT

Lloyd's Register of Shipping.

SURVEYS FOR FREEBOARD. STEAM SHIPS.

Index No.
(For London Office only)

33774

27 JUN 1930

PARTICULARS RELATING TO ALL STEAM SHIPS EITHER ~~FLUSH DECKED~~, OR WITH TOP GALLANT FORECASTLES, SHORT POOPS AND BRIDGE HOUSES DISCONNECTED, OR WITH TOP GALLANT FORECASTLES HAVING LONG POOPS, OR RAISED QUARTER DECKS CONNECTED WITH BRIDGE HOUSES, OR OTHERWISE.

Port of Survey Rotterdam
Date of Survey Building
Name of Surveyor R. Geeneweg

Ship's Name.	Port of Registry and Nationality.	Official Number.	Gross Tonnage.	Date of Build.	Particulars of Classification.
" <u>KOTA AGOENG</u> "	<u>Dutch</u>	<u>v</u>	<u>v</u>	<u>1930</u>	<u>+ 100 A1. contemplated</u>

Number in Register Book	Length.	Breadth.	Depth.	Under Deck Tonnage.	Moulded Depth as measured.....
Registered dimensions from ship's Register.	<u>449.6</u>	<u>60.83</u>	<u>29.67</u>	<u>6509.79</u>	<u>33.6"</u>
Length on LOADLINE.	<u>448.4</u>				Addition for Keel below base line for draught record..... <u>1.6</u>inches.
CORRECTED DIMENSIONS.	<u>448.33</u>	<u>60.41</u>	<u>31.86</u>	<u>6553.79</u>	

Co-efficient of fineness.....	<u>.759</u>
Any modification necessary {	<u>C.D.B.</u>
[Para. 4 (a) to (e)]*	
Co-efficient as corrected	<u>.74</u>
Sheer { Stem..... <u>10'-11 3/4"</u>	<u>164.75 ÷ 2 = 82.37</u> ...Mean
at Sternpost ... <u>2'-9"</u>	<u>36/30.62</u>
	<u>.86</u>
Sheer at $\frac{1}{8}$ of the length from Stem <u>6'3 1/2"</u>	<u>194.0 ÷ 2 = 47.0</u> ...Mean
Sternpost <u>1'-6 1/2"</u>	<u>allowed 83.91 ÷ .55 = 151.65</u>
Gradual mean Sheer	<u>54.83</u> Correction
Standard mean Sheer [Table, Para. 18] <u>54.83</u>	
Difference..... <u>29.08 ÷ 4 = 7.27</u>	
§ If limited as Para. 18 (f)	<u>- 7 1/4"</u>

Rise in Sheer { At front of bridge house.....	<u>1'-1 3/4"</u>
from amidships { At after end of forecastle	<u>5'-10 3/4"</u>

Fall in Sheer { Para. 18 (d) {	<u>÷ 2 =</u>
Length uncovered	Correction

ALLOWANCE FOR DECK ERECTIONS:

Freeboard, Table C.....	<u>5' 9"</u>
Correction for Length, if required (Para. 12, 13, 14)	<u>+ 3 3/4"</u>
Freeboard by Table A, corrected for sheer, and for length, if required (Para. 12, 13, and 14)	<u>6' 0 1/2"</u>
Difference	<u>8' 11 1/4"</u>
Percentage as below.....	<u>2 - 10 1/2</u>
	<u>38.80%</u>
	<u>*. 13.38</u>

Correction for R. Q. Dk. if engine and boiler openings not covered by bridge house (Para. 11)	<u>- 1' 1 1/4"</u>
Allowance for Deck Erections	

Length.	Length allowed.	Height.
Forecastle..... <u>61.25</u>	<u>60.45</u>	<u>7' 6"</u>
Bridge House	<u>150.00</u>	<u>7' 9"</u>
+ Raised Q. Dk.....		
Poop..... <u>50.6</u>	<u>60.6</u>	<u>7' 3"</u>
Total	<u>262.30</u>	<u>- .585</u>
Length of Ship	<u>448.38</u>	
Corresponding percentage { (Para. 12, 13, 14)	<u>38.80%</u>	

FREEBOARD recommended amidships from centre of Disc to top of Statutory Deck Line, (Steel) Deck :-

Fresh Water Line	above centre of Disc	...
Indian Summer Line	" "	...
Winter Line	below "	...
Winter North Atlantic Line	" "	...

If the frames skin planking, or ceiling are of unusual thickness the breadth of vessel to inside of ceiling should be reported if possible.
In vessels obtaining an allowance for deck erections under Para. 11 where the sheer drops abeam amidships the height of the R.Q.D. is to be taken from the level of the top of the amidship beam.
In flush-decked vessels the total standard mean sheer means the sheer measured at the stem and stern post. In vessels having poops and forecastles, it means the sheer measured at points distant one-eighth of the vessel's length from stem and stern-post.

m.328. T.

State dimensions of freeing port area on back of this form.

The Surveyor should state whether the fall in sheer as reported is measured relatively to the straight line of keel or to the water line. If measured relatively to water line the vessel's draft at time of survey, and also the usual load draft forward and aft should be reported.

NOTE.—If the depth is measured when vessel is afloat, the depth of measurement should be reported.

NOTE.—The round of beam should be reported on the full breadth of vessel at the gunwale.

NOTE.—The height of the freeboard should be reported on the full breadth of vessel at the gunwale.

Do all the Frames extend to the top height in the Poop?	<i>Yes</i>	Raised Quarter Deck?	<i>Yes</i>	Bridge House?	<i>Yes as on plan</i>	Forecastle?	<i>Yes</i>	
To what height do the Reverse Frames extend?	<i>No frames</i>							
Has the Poop or Raised Quarter Deck an efficient Iron Bulkhead at the fore end?	<i>No</i>							
Give particulars of the means for closing the openings in Bulkhead	<i>Wood full height in riveted channels.</i>	<i>2 1/2"</i>						
Is the Poop or Raised Quarter Deck connected with the Bridge House?	<i>No</i>			Has the Bridge House an efficient Bulkhead at the fore end?	<i>No</i>			
Give particulars of the means for closing the openings in Bulkhead	<i>WT door on hinges</i>							
What is the thickness of the Bridge Front plating?	<i>.40</i>	and Coaming plate?	<i>.44</i>					
Give scantlings and spacing of the Stiffeners	<i>10 x 3 1/2 x .63</i>	<i>30"</i>	<i>L 250 x 90 x 16 1/2 x 760 1/2</i>					
Are bracket plates fitted at each end of the Stiffeners?	<i>Yes part & caps.</i>	Are hor'l. brackets fitted connecting Bridge Bulk'd. with Bulwarks?	<i>Yes</i>					
Has the Bridge House an efficient Iron Bulkhead at the after end?	<i>Yes</i>							
How are the openings closed?	<i>Wood full height. in riveted channels. 2 1/2"</i>							
Is the Forecastle at least as high as the main or top-gallant rail?	<i>Yes</i>	Has the Forecastle an efficient Iron or Wood Bulk'd. at after end?	<i>Yes</i>					
Are the Engine and Boiler openings covered by a Bridge, Poop, Raised Quarter Deck, or enclosed by a Strong Iron or Steel Deckhouse?	<i>Yes</i>							
if the openings are not so protected are the exposed parts of the Casings efficiently constructed?	<i>Protected</i>							
ave thickness of plating; scantlings and spacing of Stiffeners	<i>As per approved</i>							
what is the height of the exposed Casings?	<i>over above</i>	Are suitable means provided for closing all openings in them in bad weather?	<i>Yes</i>					
Are the Weather Deck Hatchways efficiently constructed and at least equal to the requirements of Section 28 of the Rules for 1904-5? Give particulars below:	<i>See below</i>	<i>Yes</i>						
Position and Size.	<i>22' 6" x 18' 0"</i>	<i>30' 0" x 18' 0"</i>	<i>32' 6" x 18' 0"</i>	<i>22' 6" x 18' 0"</i>				
Item.	Ship.	Rule.	Ship.	Rule.	Ship.	Rule.	Ship.	
COAMING Height above top of DECK	<i>30"</i>							
Thickness { Sides.....	<i>.49</i>	<i>{ For all Hatchs.</i>						
Thickness { Ends.....	<i>.44</i>							
SHIFTING BEAMS OR WEB PLATES.	Number	<i>4</i>	Number	<i>5</i>	Number	<i>6</i>	Number	<i>4</i>
	Section and Scantlings	<i>16 x .36</i>		<i>4 x 3 x .43</i>				
	Material	<i>7/8 405 1/2 x 9 1/2 L 100 x 75 x 11</i>		<i>For all Hatchs.</i>				
* FORE AND AFTERS.	Number							
	Section and Scantlings							
	Material							
HATCHES Thickness	<i>2 1/2" For all Hatchs.</i>							
Remarks.....								

* The depth of Fore and Afters should be stated from the underside of the hatches in all cases.

(If the sill of the lowest side scuttle will be less than 6 inches above the Indian Summer Load Line if assigned under the tables, state vertical distance from top of deck at side amidships to lower edge of lowest side scuttle.)

The following information is to be given in all Cases of vessels dealt with under Paras. 11, 12 (under 15 feet Moulded depth) and under Shelter Deck Rules.
What is the thickness of the Bridge Sheerstrake?

Delete the words { The Crew are, are not, berthed in the bridge house. *Forecastle*.
that do not apply { The arrangements to enable them to get backwards and forwards from their quarters are, are not satisfactory.


Length of Bulwarks in well *91' 6" forward. 95' 0" aft.* = *forward 18.3 aft 19.0* Sq. ft.

Area of Freeing Ports required by Para. 11 (e) each side of vessel = *18.3 19.0* Sq. ft.

Ft. Tenth. Ft. Tenth. No.

<i>forward 3.25</i>	<i>x 1.6</i>	<i>x 3.</i>	Freeing Ports (each side of vessel)	<i>= 15.6</i>	<i>20.8</i>	Sq. ft.
<i>aft. well 3.25</i>	<i>x 1.6</i>	<i>x 4.</i>				

Total deficiency or excess = Sq. ft.

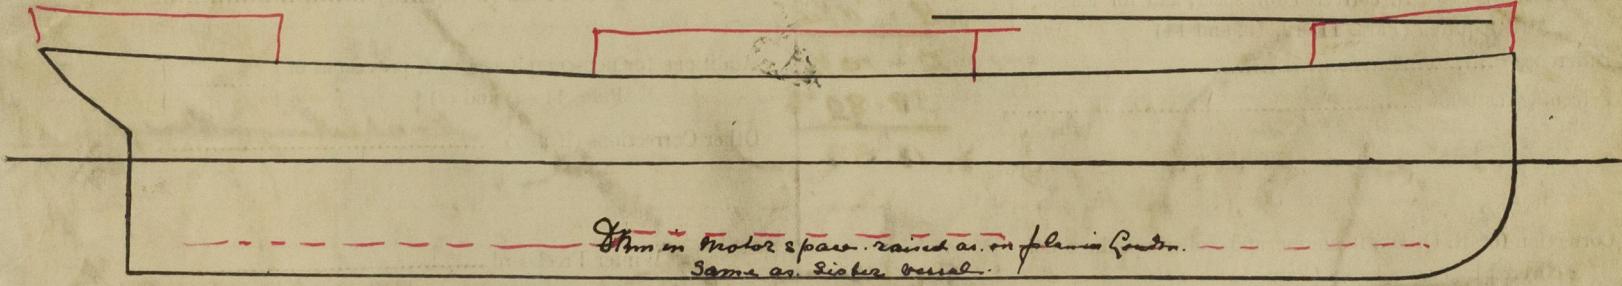

Show hereon line of Floors or Tank Top with position of any Breaks in same; also height of Peak Tank tops, &c., &c.

State any special features in the construction of the Vessel *Built in accordance with the approved plans.* 56' 04"

Builder's name and yard number *Maastricht Leyenoord. Yard no. 317.*

Names of sister vessels *"Kota Djandi" Kota Pinang.* same owners and after the same plans. 59' 66"

Owners *Rotterdam & C. Lloyd.*

Address *Rotterdam.*

Fee *144.00*

Received by me *P. G. Gremmeling*

