
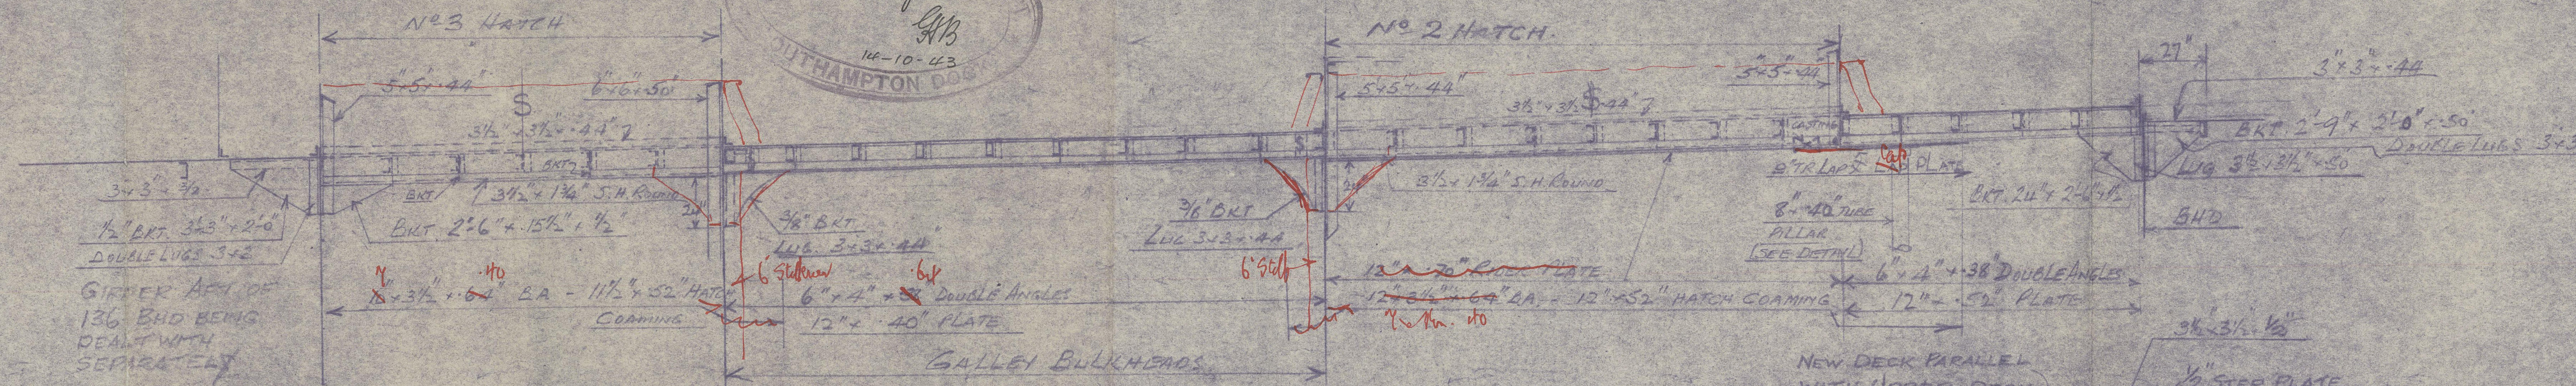


116 OCT 1943

H.M.T. "WORCESTERSHIRE" JOB NO 1500




MODIFIED EXTENSION OF BRIDGE DECK TO FORECASTLE DECK.

SCALE: 1/4" = 1 FOOT

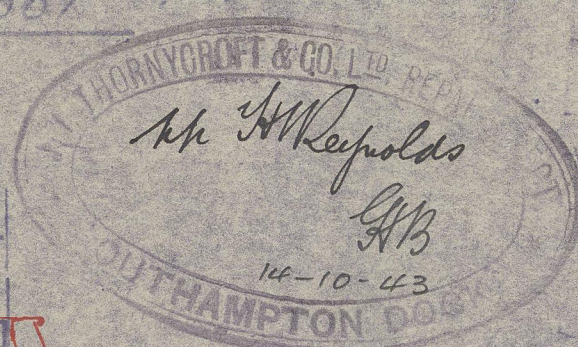


DETAILS AT NO 3 HATCH

1/2" = 1 FOOT

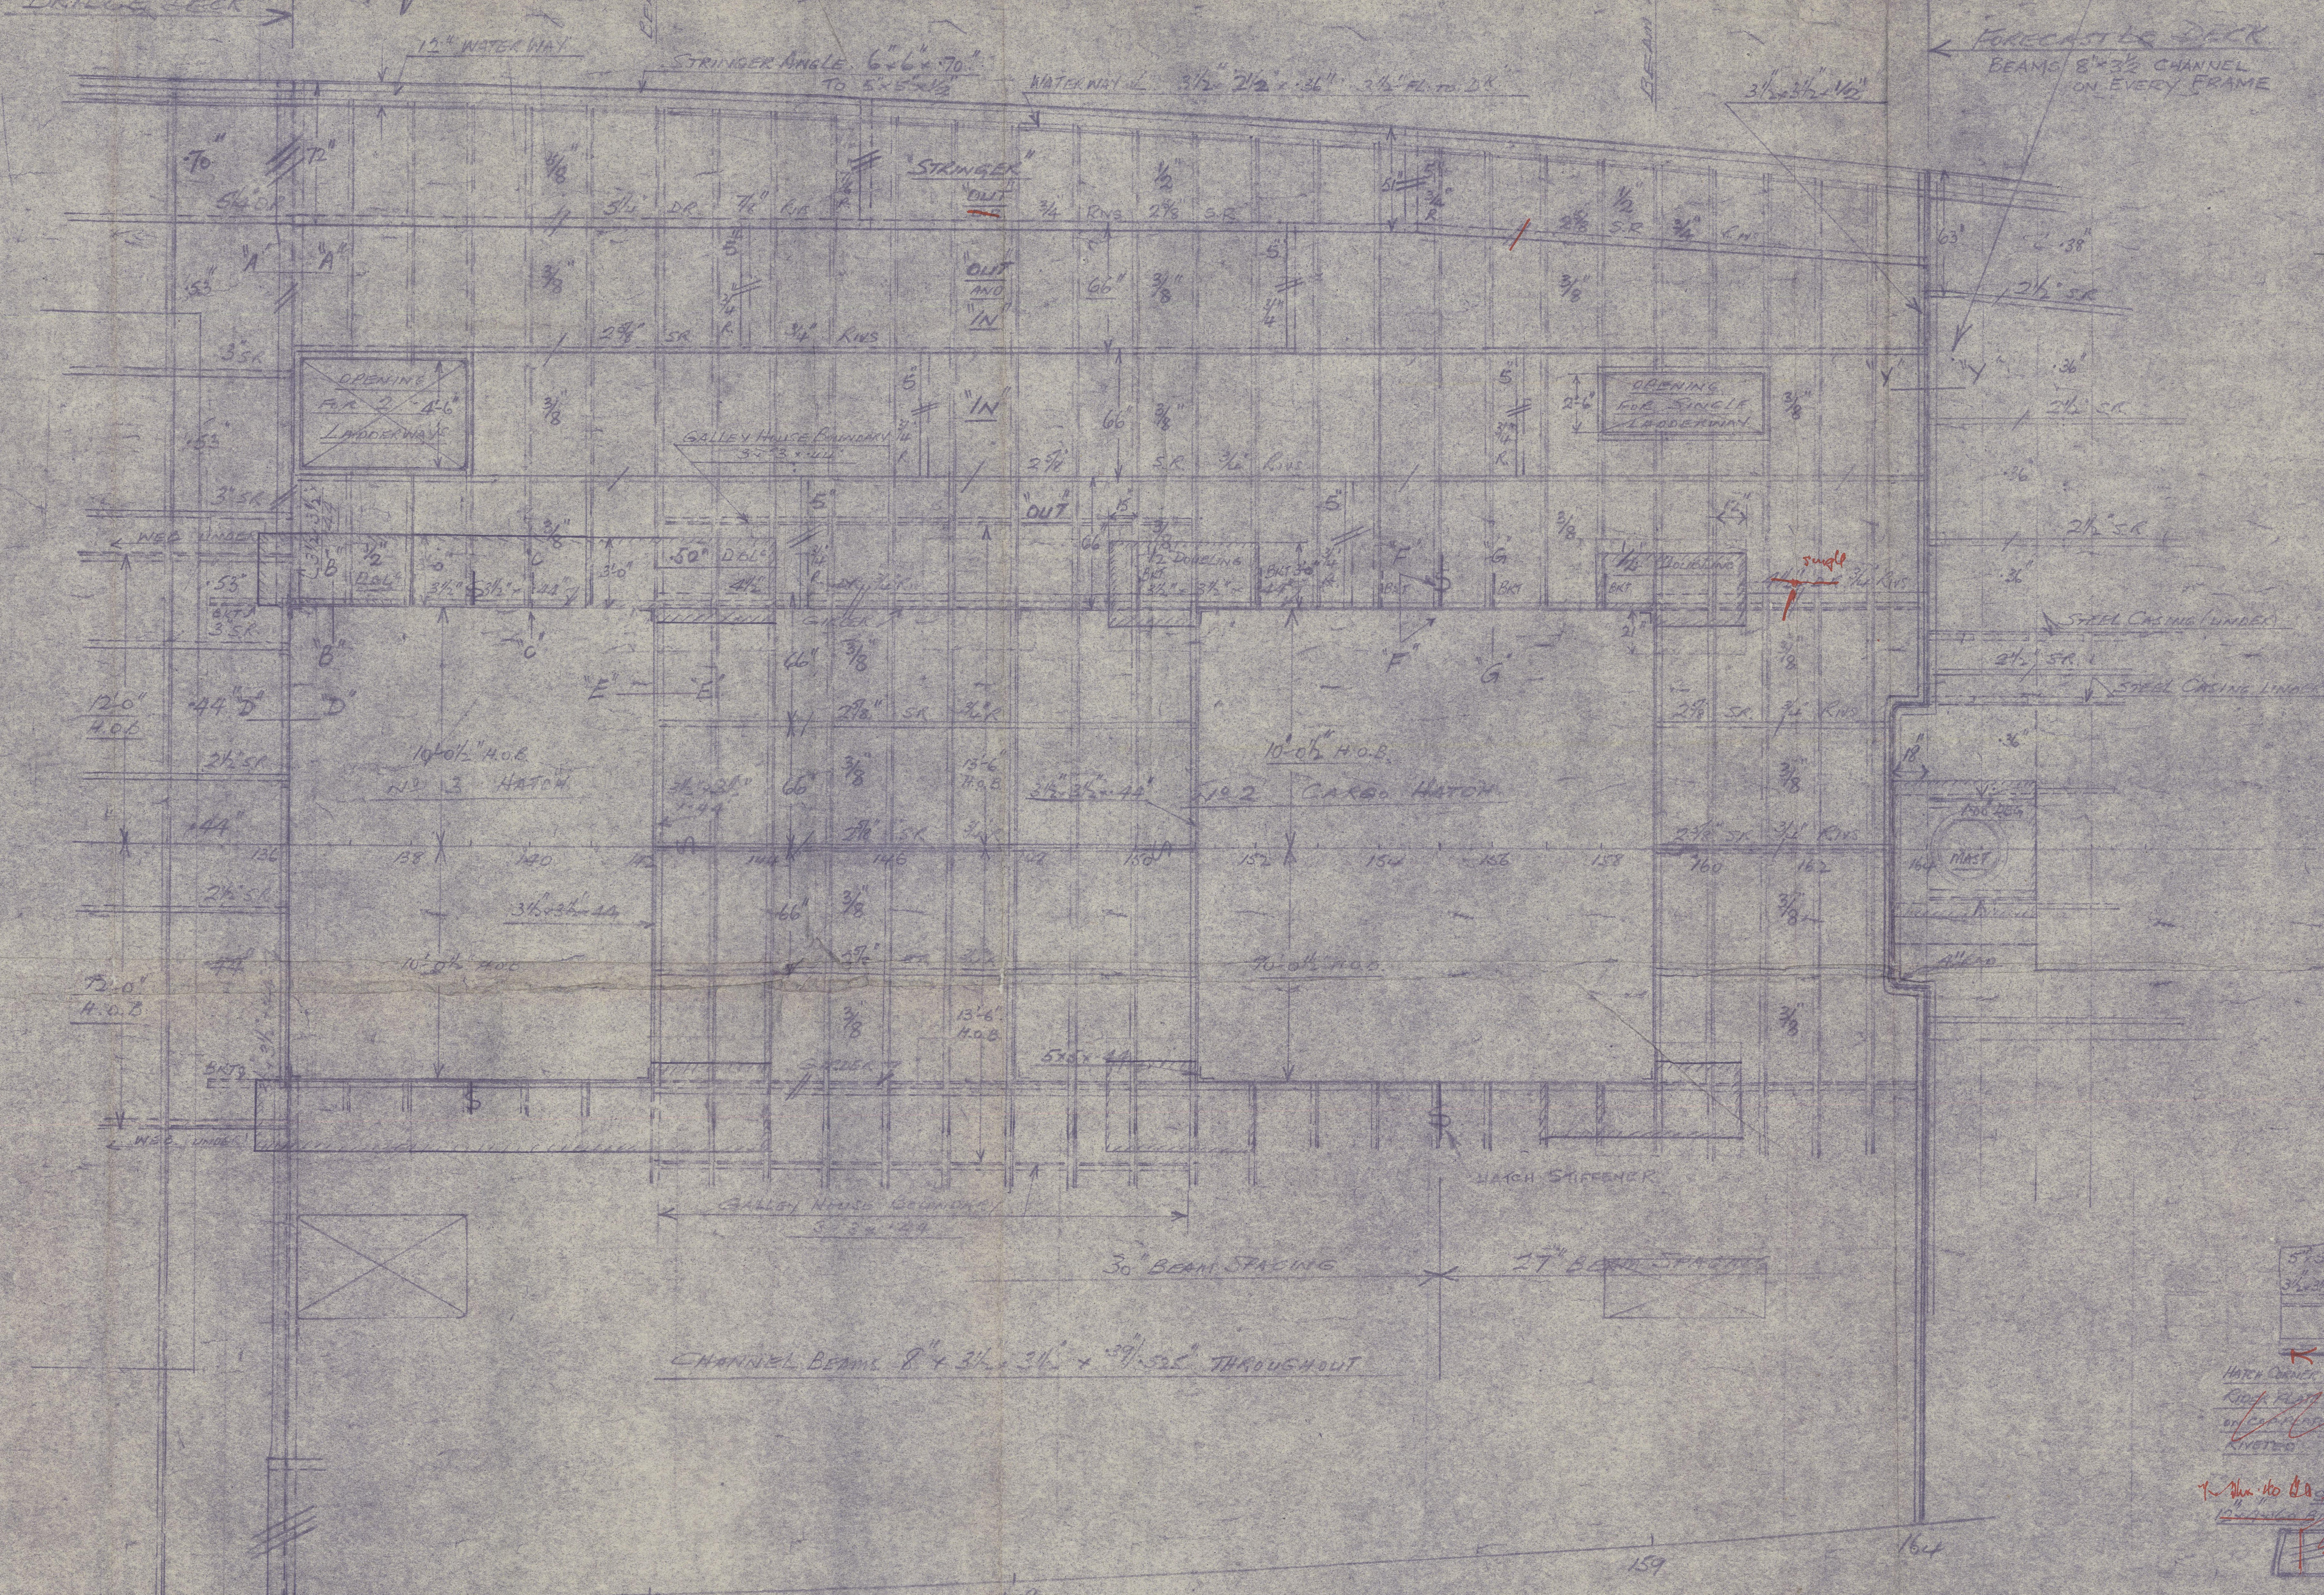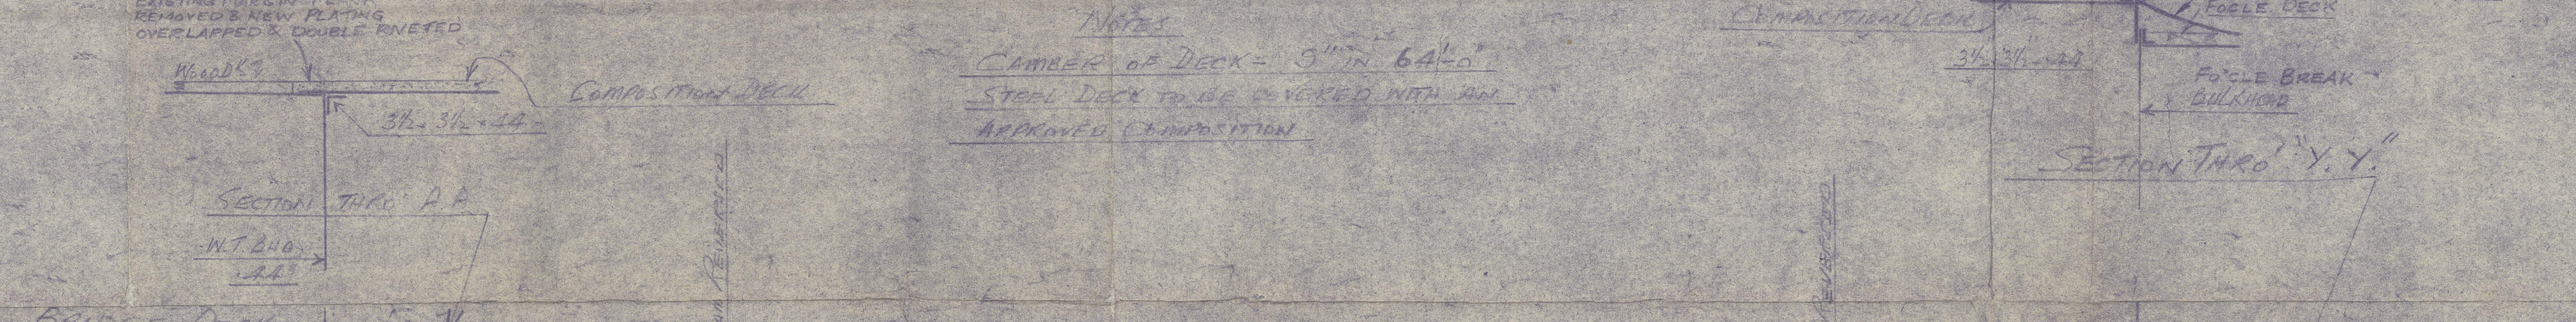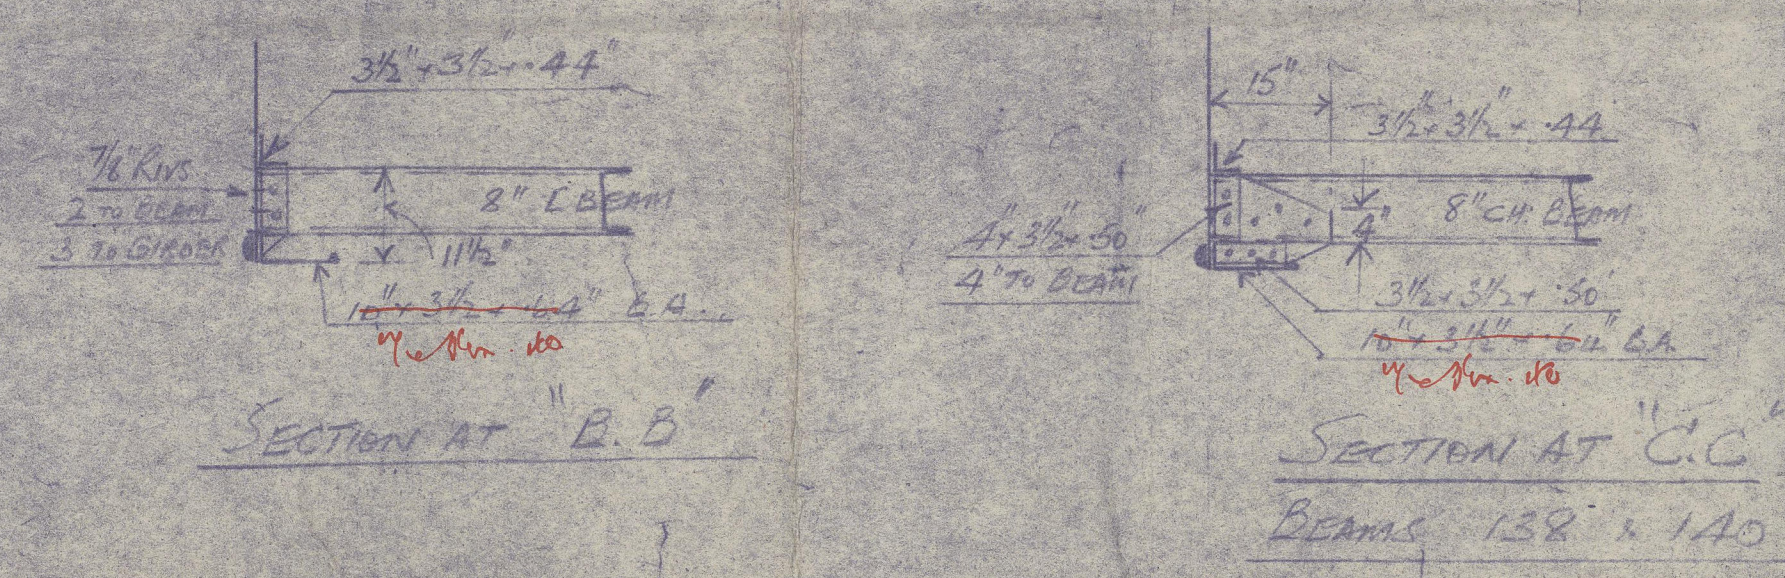


DETAILS AT NO 2 HATCH

1/2" = 1 FOOT

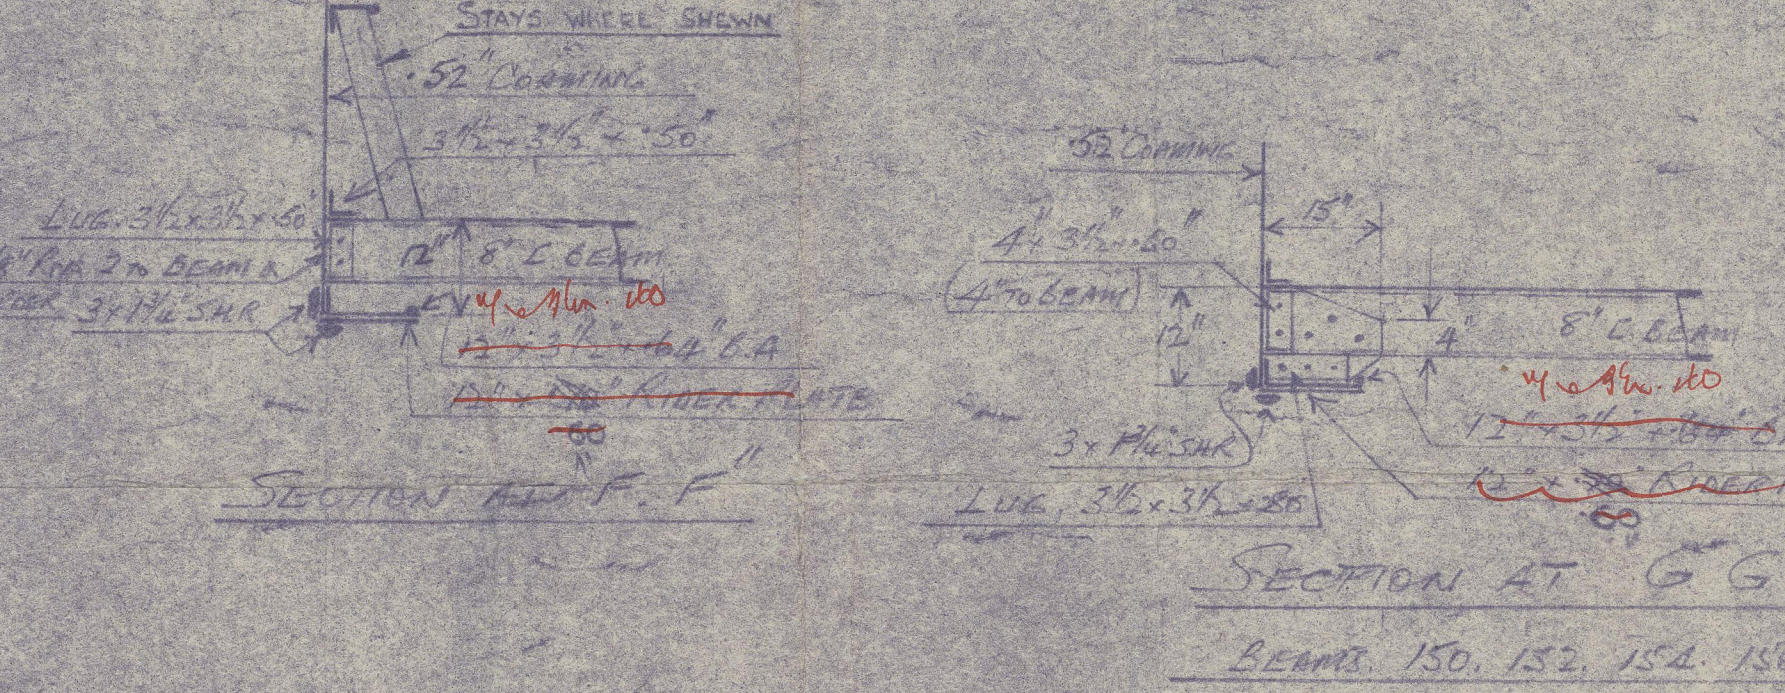

NOTE: SECTIONS AT HATCHES - SIMILAR TO NO 3 HATCH

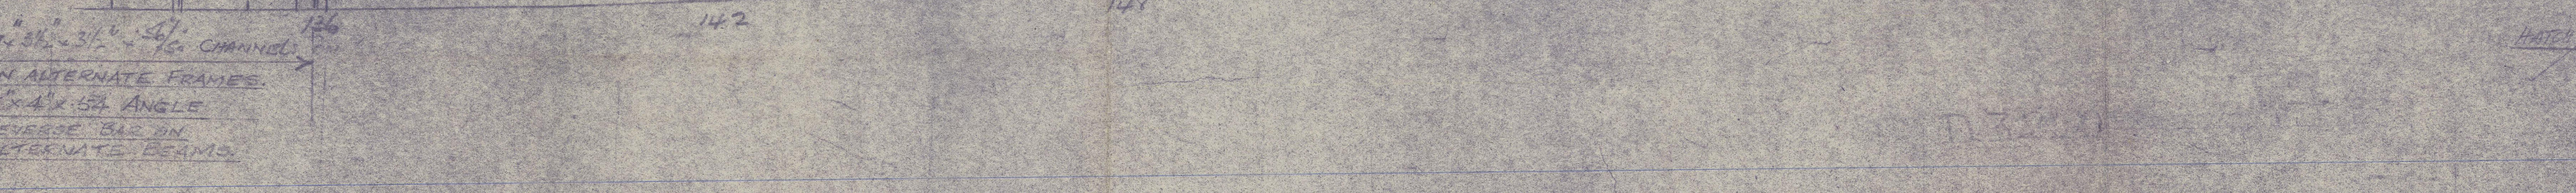



H.M.S. 'Worcestershire'

Modified Plan of Extension of Bridge  
Deck to Newcastle.

RPT. No 300.18282



© 2020

Lloyd's Register  
Foundation

003154-003161-00913