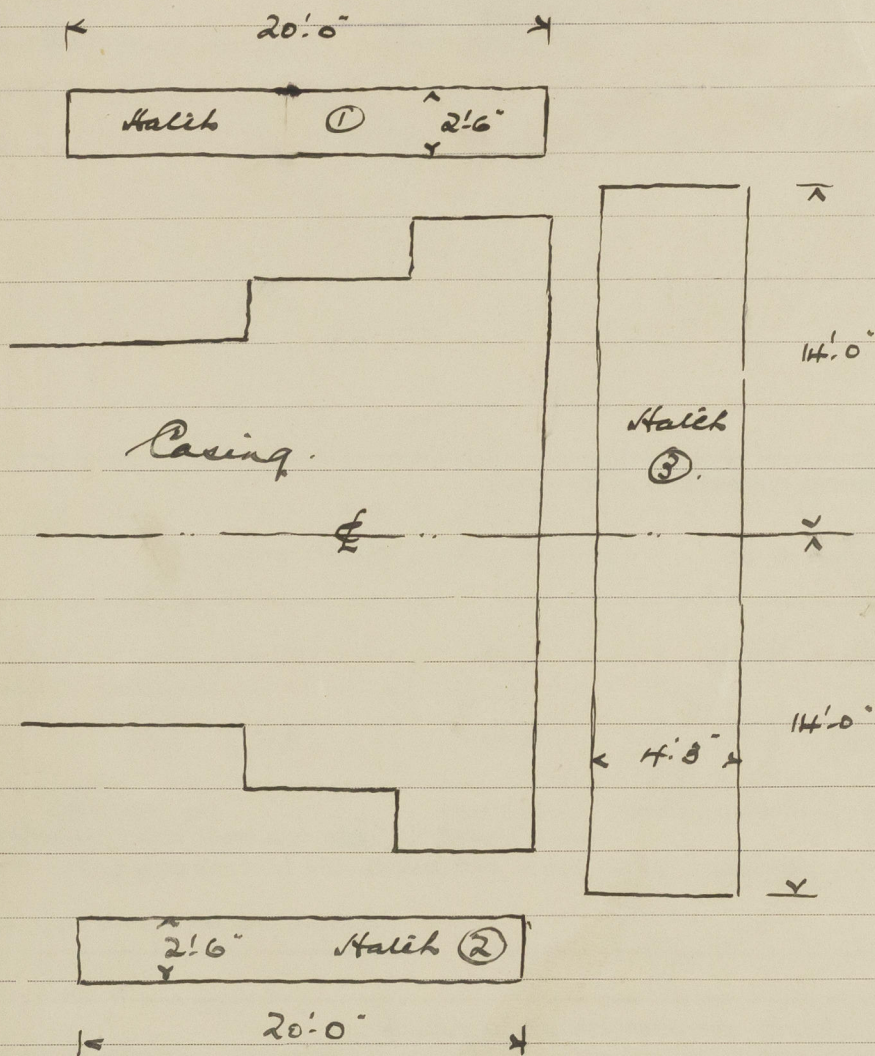


Lloyd's Register of Shipping.

Ship's Name ORIONOfficial No. 7288

Memorandum of alterations reported since ship was surveyed for assignment of Load Lines
in Göteborg. May. 1932.

Freeboard deck hatches in Bridge space.

Hatch. ① & ②

Coaming. 9" BA

Beams. none.

Fore rafters. none.

Cover 2½" wood. alkali?.

Bearing surface. 3"

Cleat spaces. 24"

Fastenings. 2.

Hatch No. 3.

9" BA

none.

none

2½" wood. F & A.

3"

24"

2.

J. Michalos & H. Perry

87.8
76.8.31