
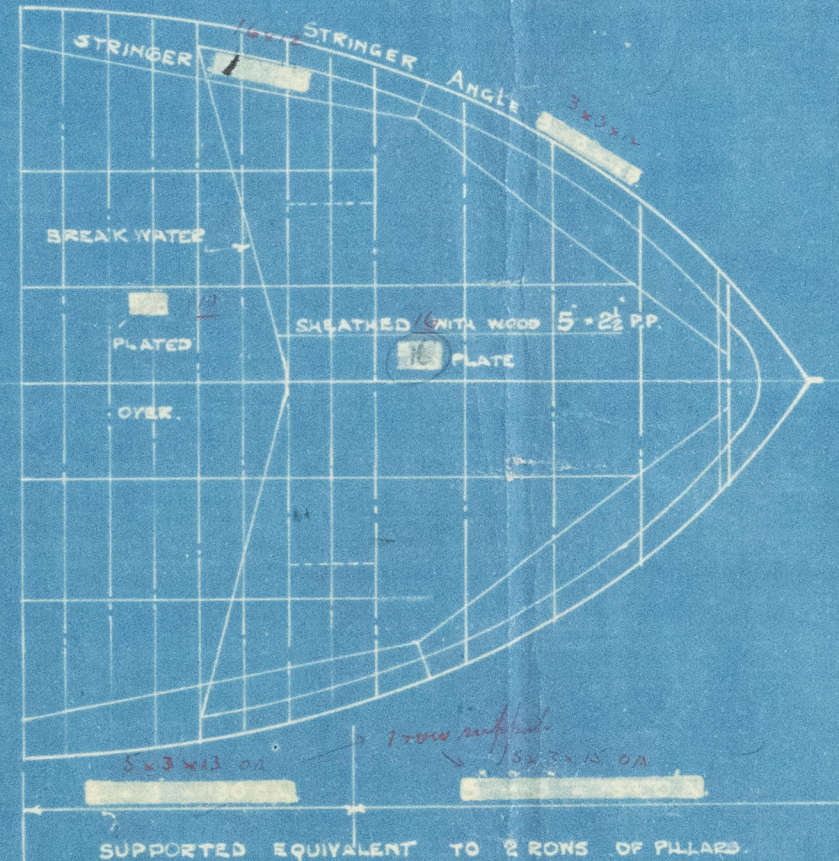
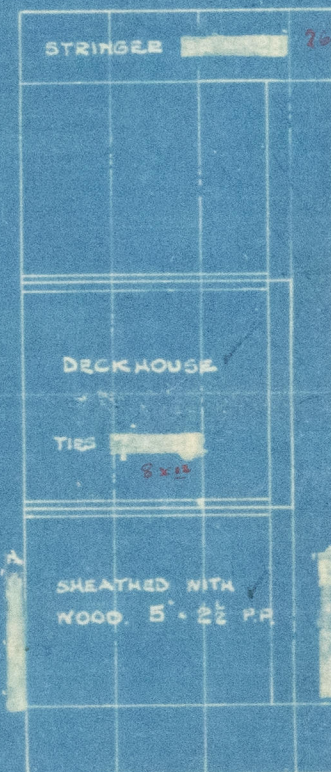


PROFILE AND DECK PLAN.

LENGTH B.P. 203'-0". BREADTH MLD 15'-0". DEPTH MLD 15'-0".

SCALE 1/8" INCH = ONE FOOT.

TO CLASS RAISED QUARTERDECK.

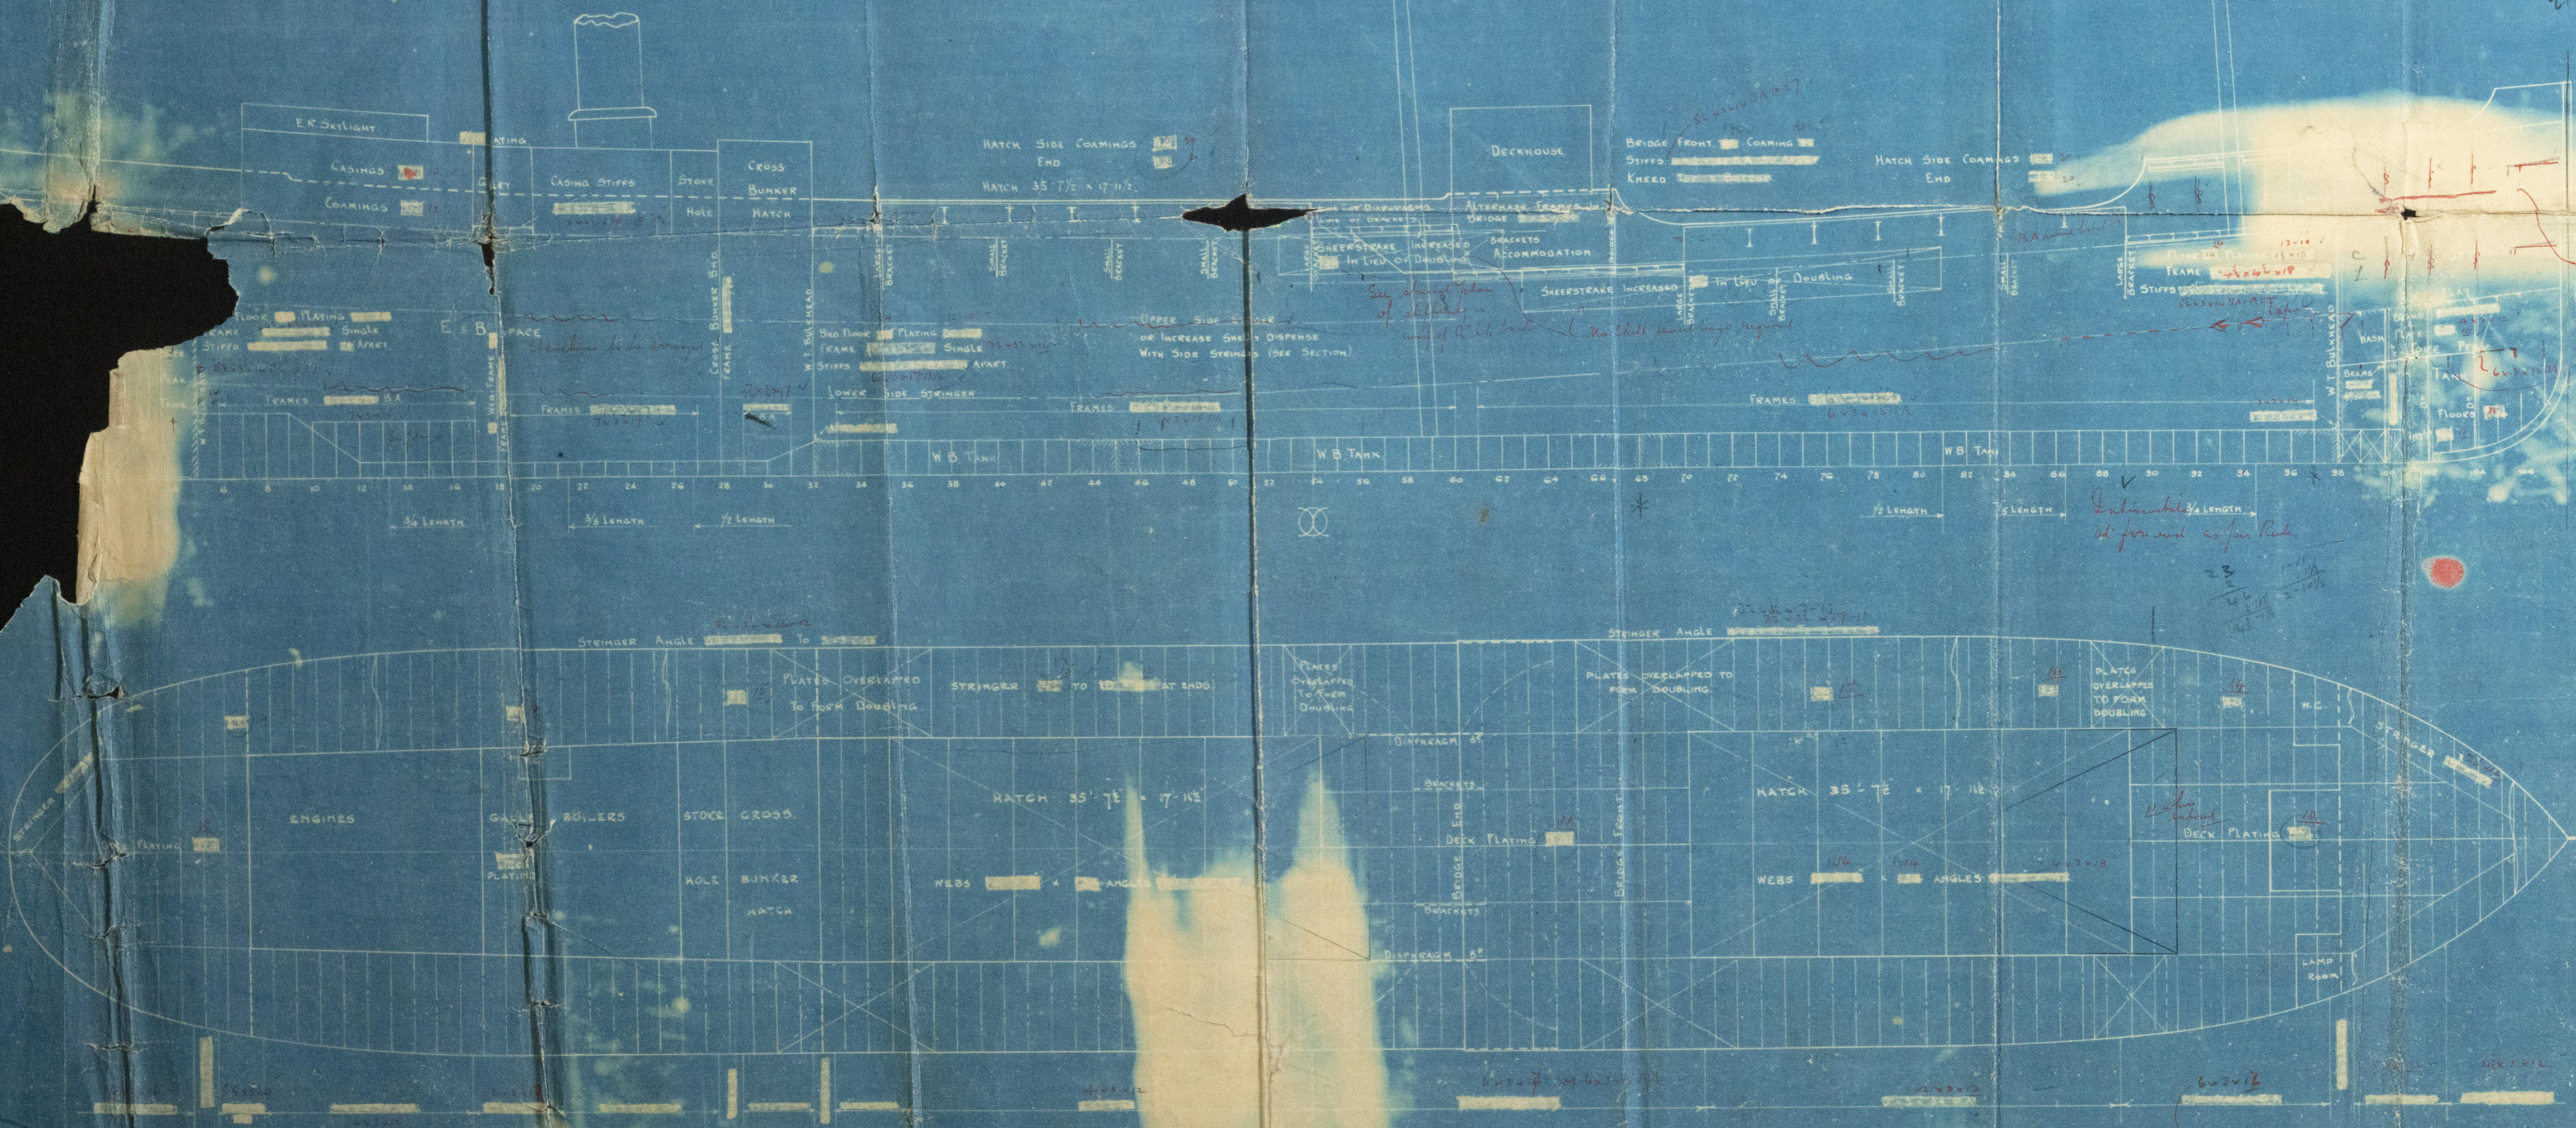

203'-0"
15'-0"
210'-0"

6-3 x 12 on all 1/2
feet 1/2
or say 6-3 x 12
feet 1/2

Indicate from
connection to plate
shape

Indicate length
of forward as per plan

No 218

14 Sept 1916
1935
R

Hankess
Profile + Decks

"Ryckelt"
CAMROSE

812 352/11/18
**NOW
STOCK FORCE**

9

B.C

003223-003 232-0245



© 2020

Foundation