


10. 2. 22




S.S. "CAMROSE"

RUDDER QUADRANT

SCALE 3" = 1 FOOT.

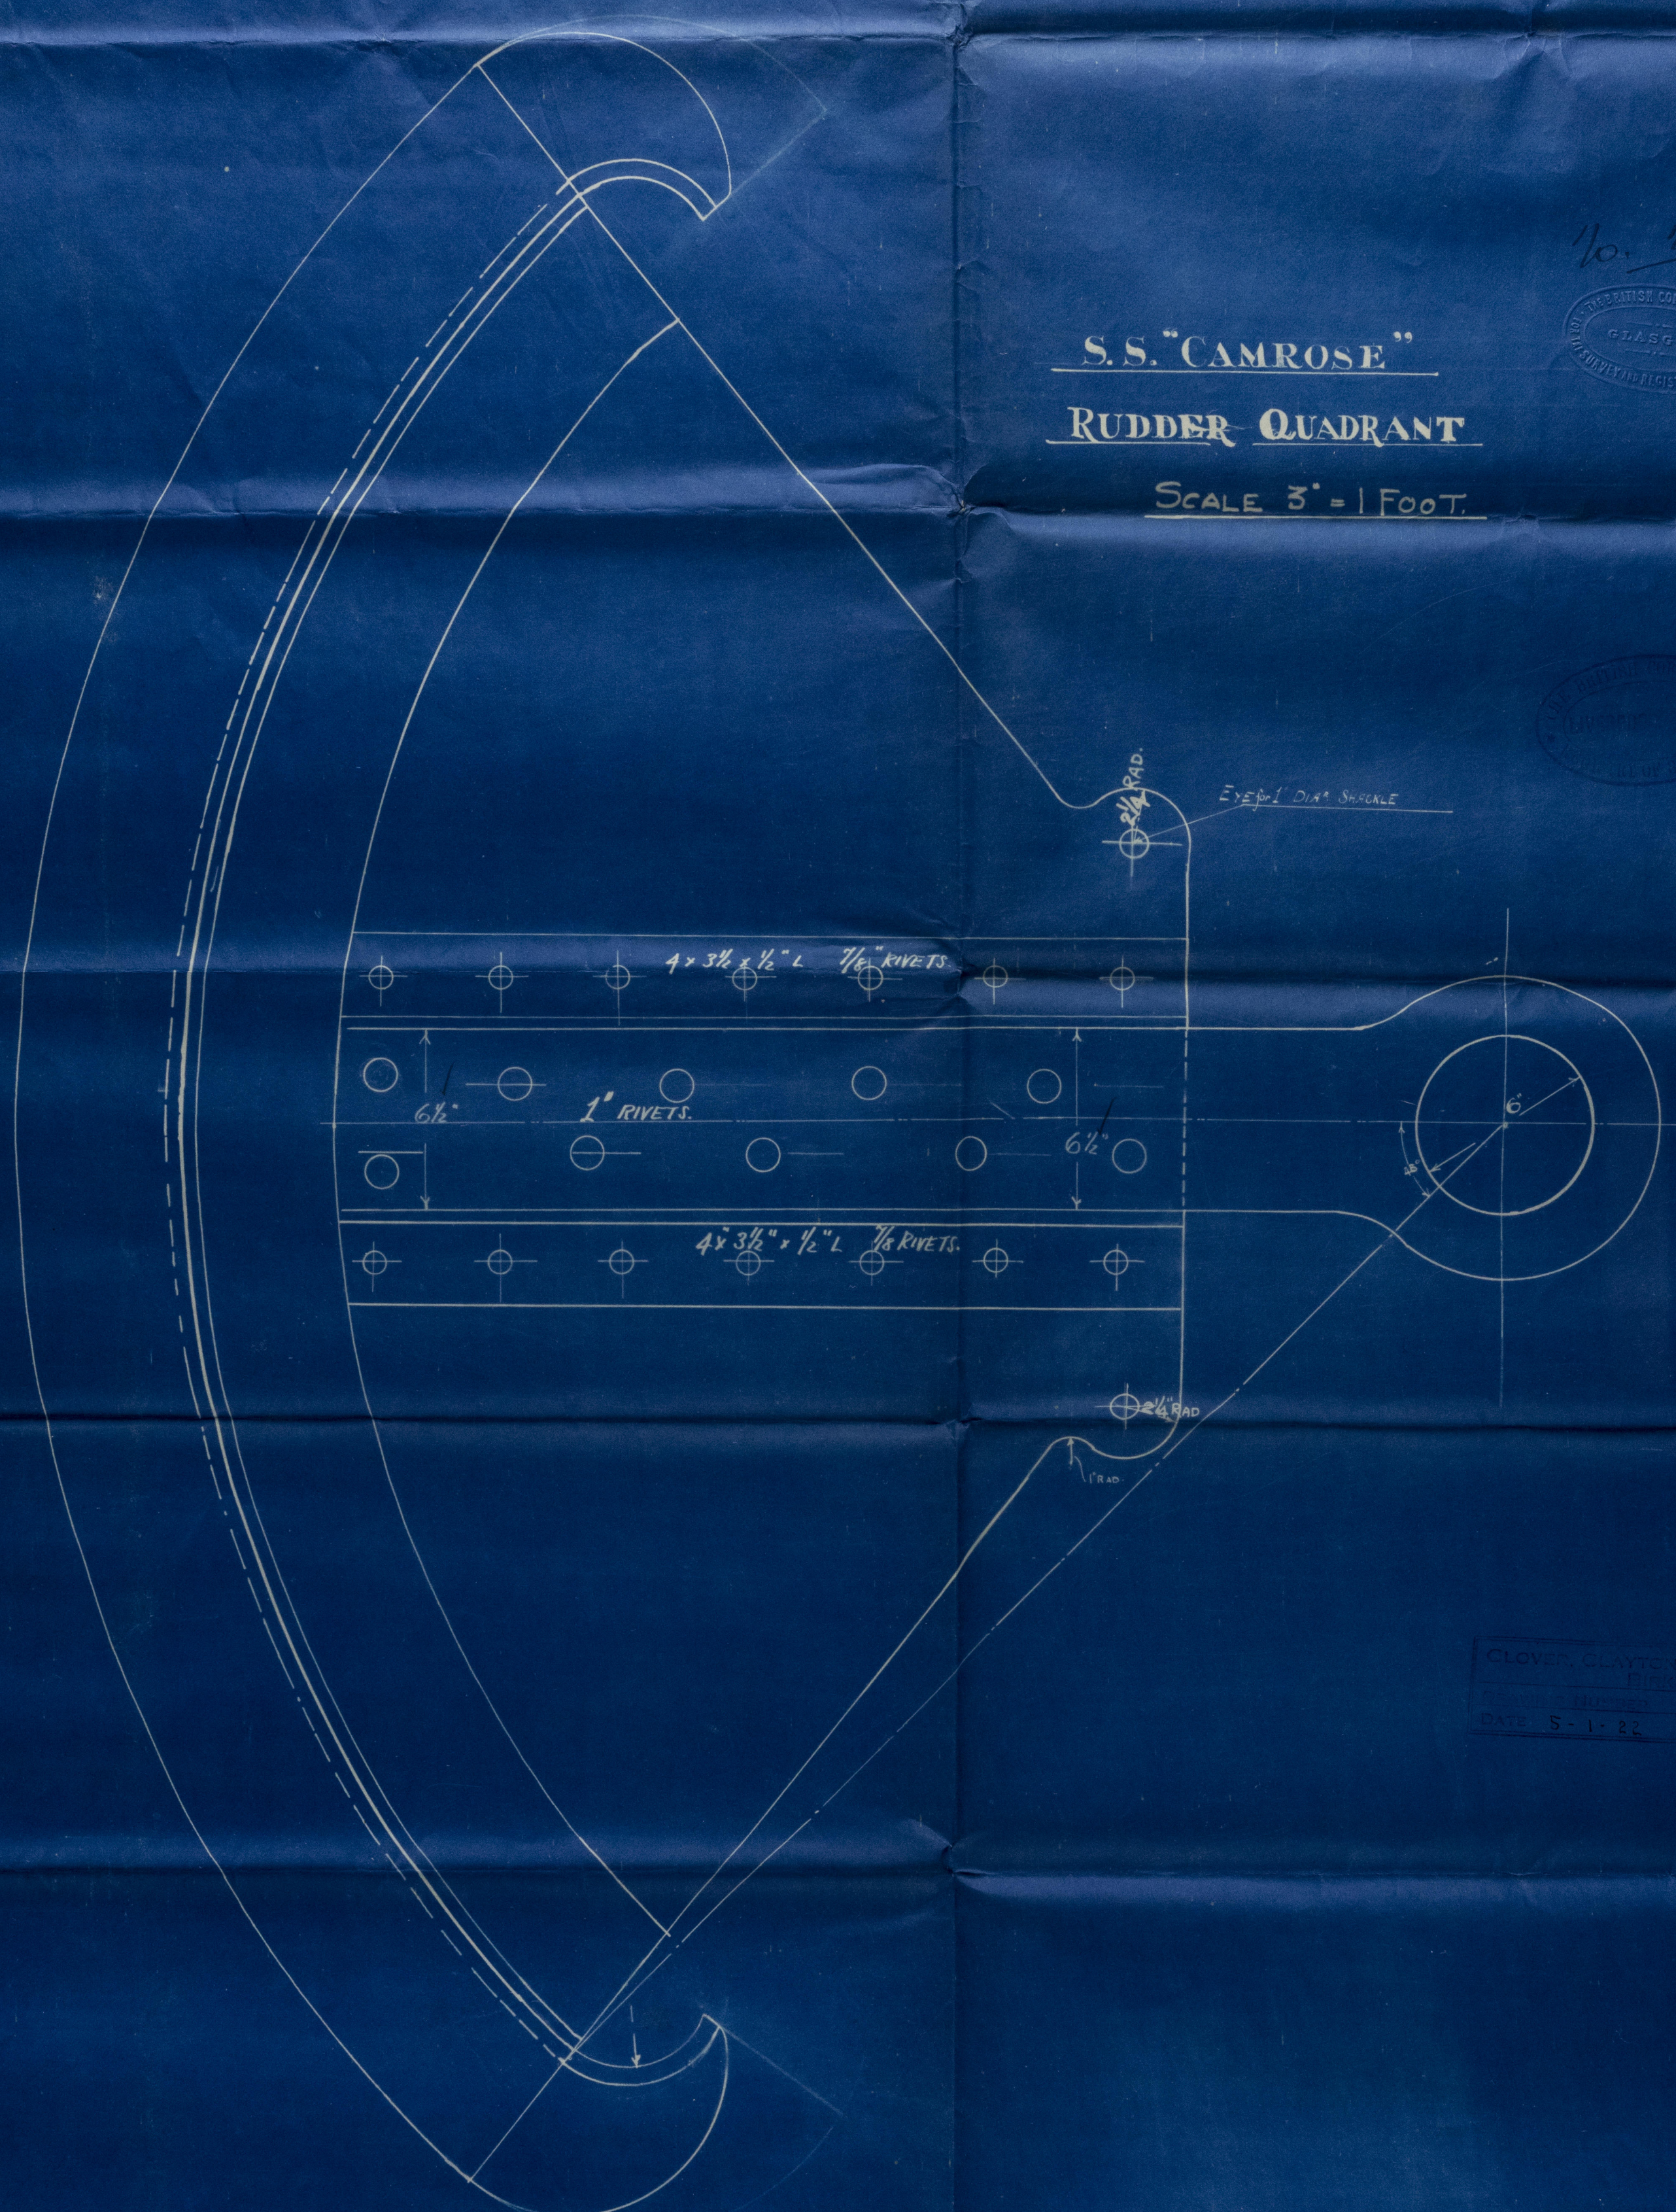

CLOVER, CLAYTON & CO. LTD.  
ENGINEERS  
791  
DATE 5-1-22

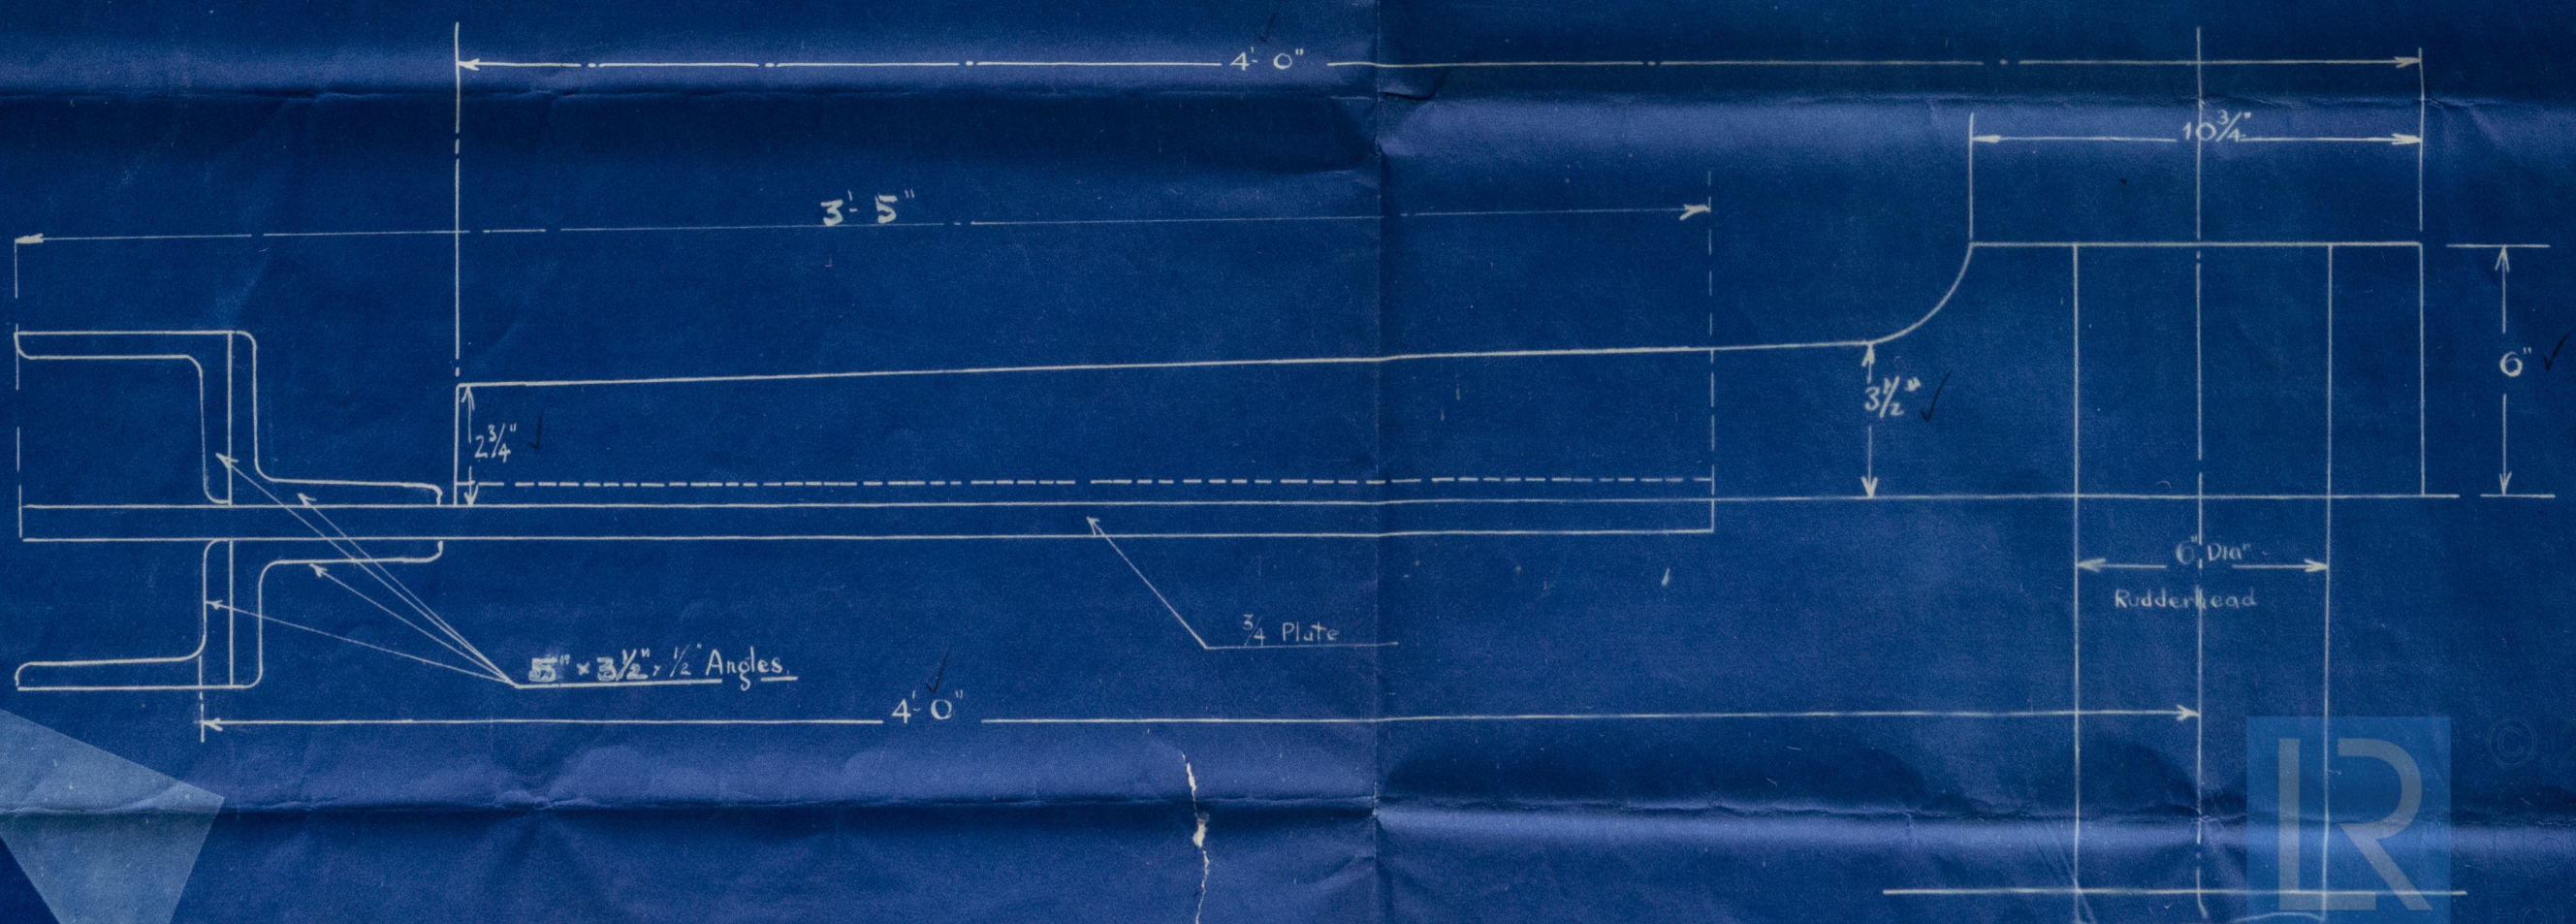

© 2020

003473-003732-02145



S.S. "STOCKFORCE"  
(EX: "CAMROSE")

QUADRANT. AS FITTED  
IN SHIP.

20/1/22.

To be sent to H. O.



© 2020

Lloyd's Register  
Foundation

003223-003232-0248