


666


APPROVED
LLOYDS REGISTER OF SHIPPING
UNITED WITH
THE BRITISH CORPORATION REGISTER
James R. Clark 27/6/49
Date
APPROVED In Accordance
WITH
BRITISH CORPORATION RULES AND REQUIREMENTS

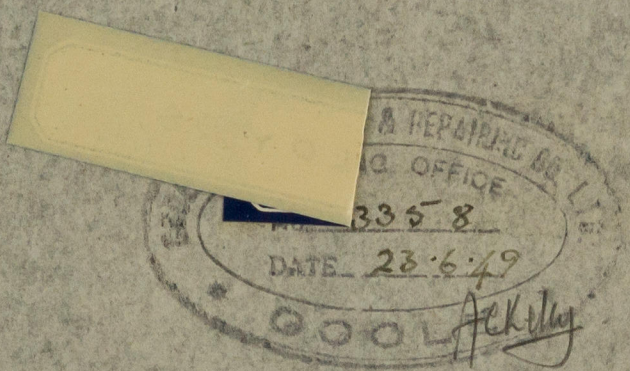

M.V. HULLGATE

PROPOSED MODIFICATION TO
STIFFENERS ON HOLD COAMING.

SCALE $\frac{1}{2}'' = 1 \text{ FOOT}$

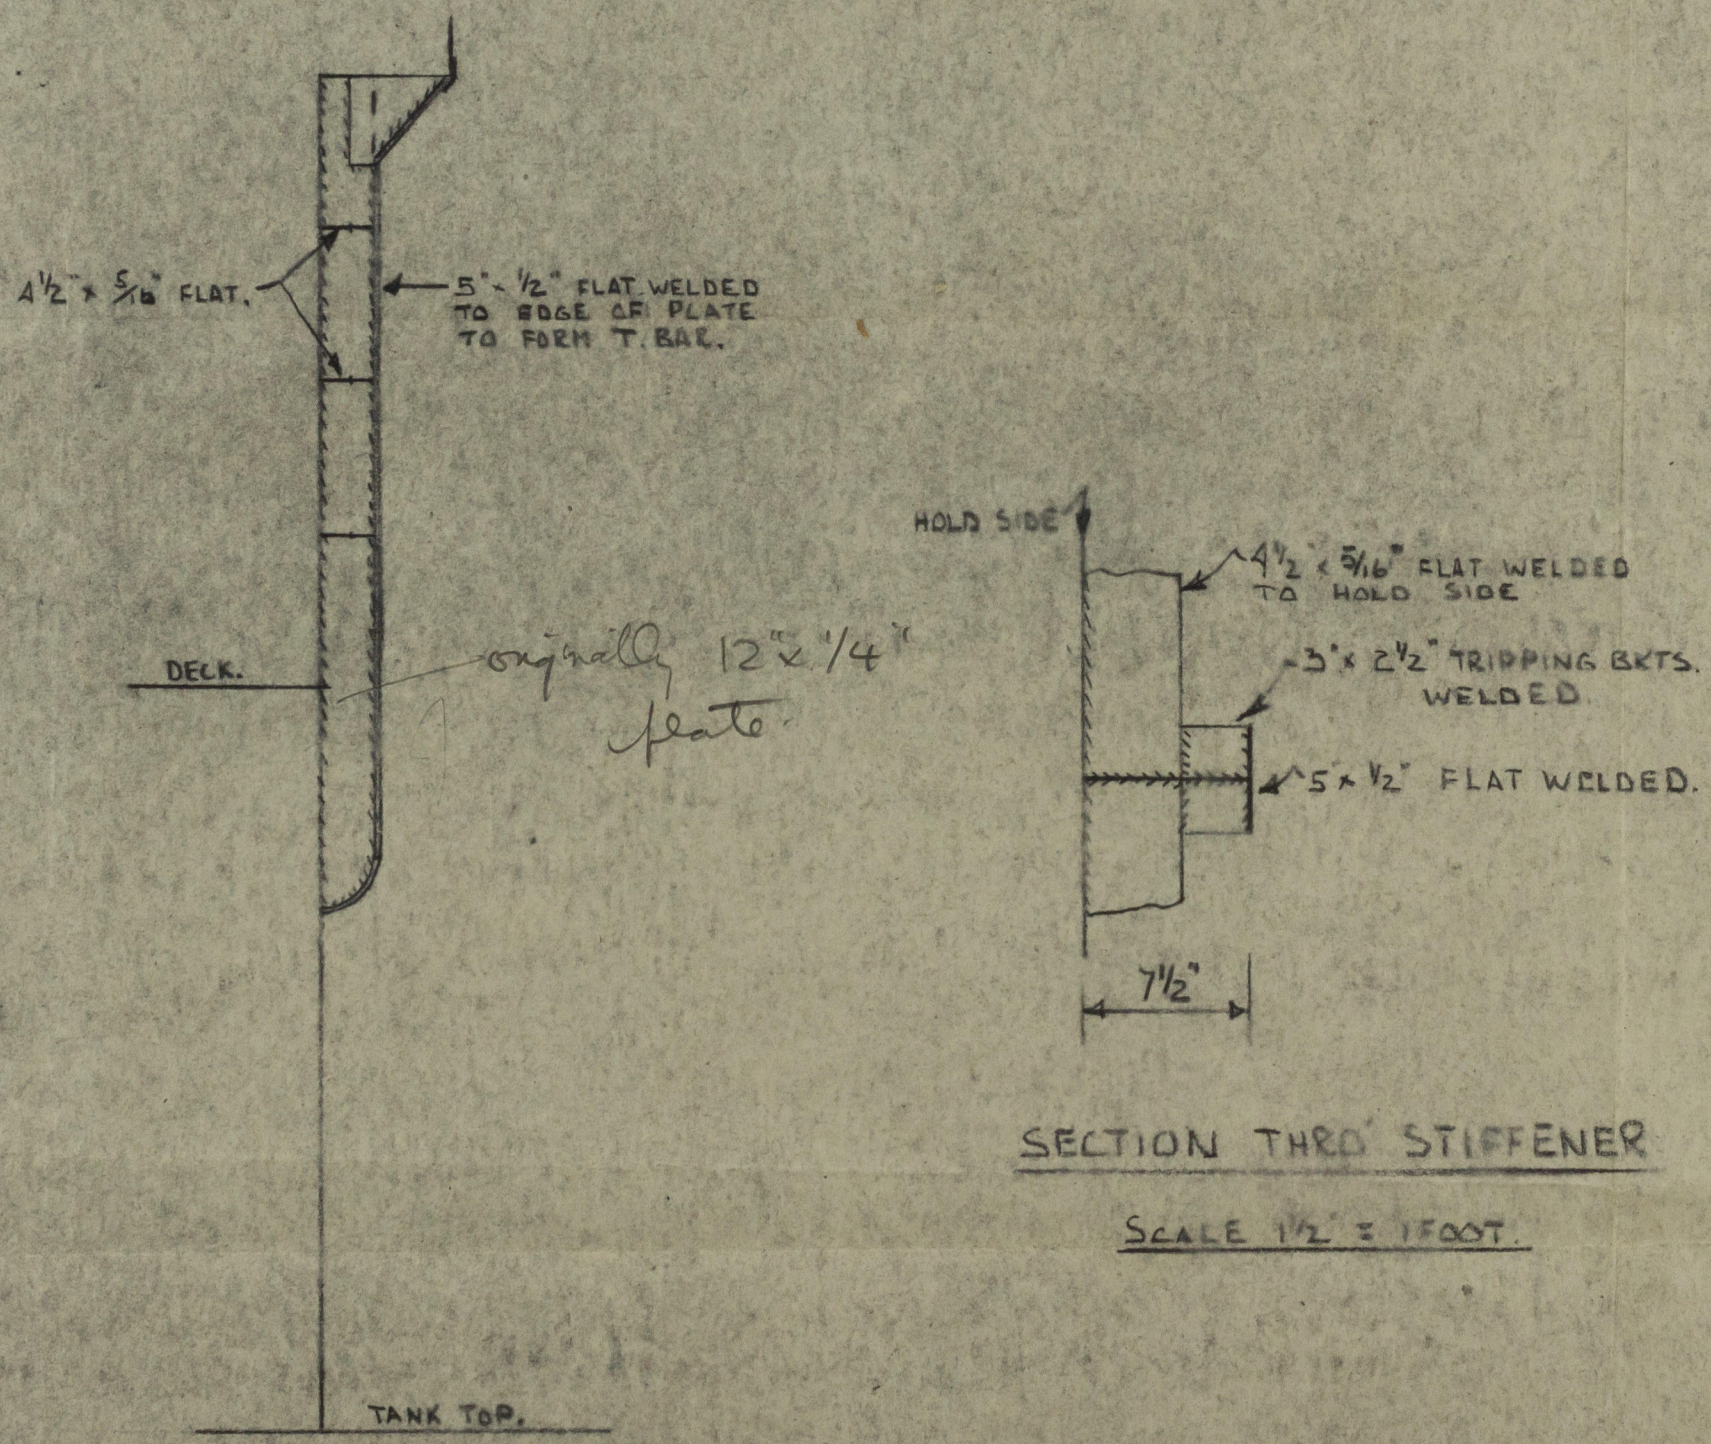

SECTION THRO STIFFENER

SCALE $\frac{1}{2}'' = 1 \text{ FOOT}$

LLOYDS

0198²/₂

DATE 23.6.49

5

Mod^r to Difference on Held Beamings

in HULLGATE

Hull 27.6.49

[Handwritten signature]

Hull 27 JUN 1949

in Hullgate

Held Beamings

Spec. mod. to Difference on

24 8610-003251-0198 24

