



APPROVED In Accordance  
WITH  
BRITISH CORPORATION RULES AND REGULATIONS

APPROVED  
LLOYD'S REGISTER OF SHIPPING  
UNITED WITH  
THE BRITISH CORPORATION REGISTER  
Date 4.6.49

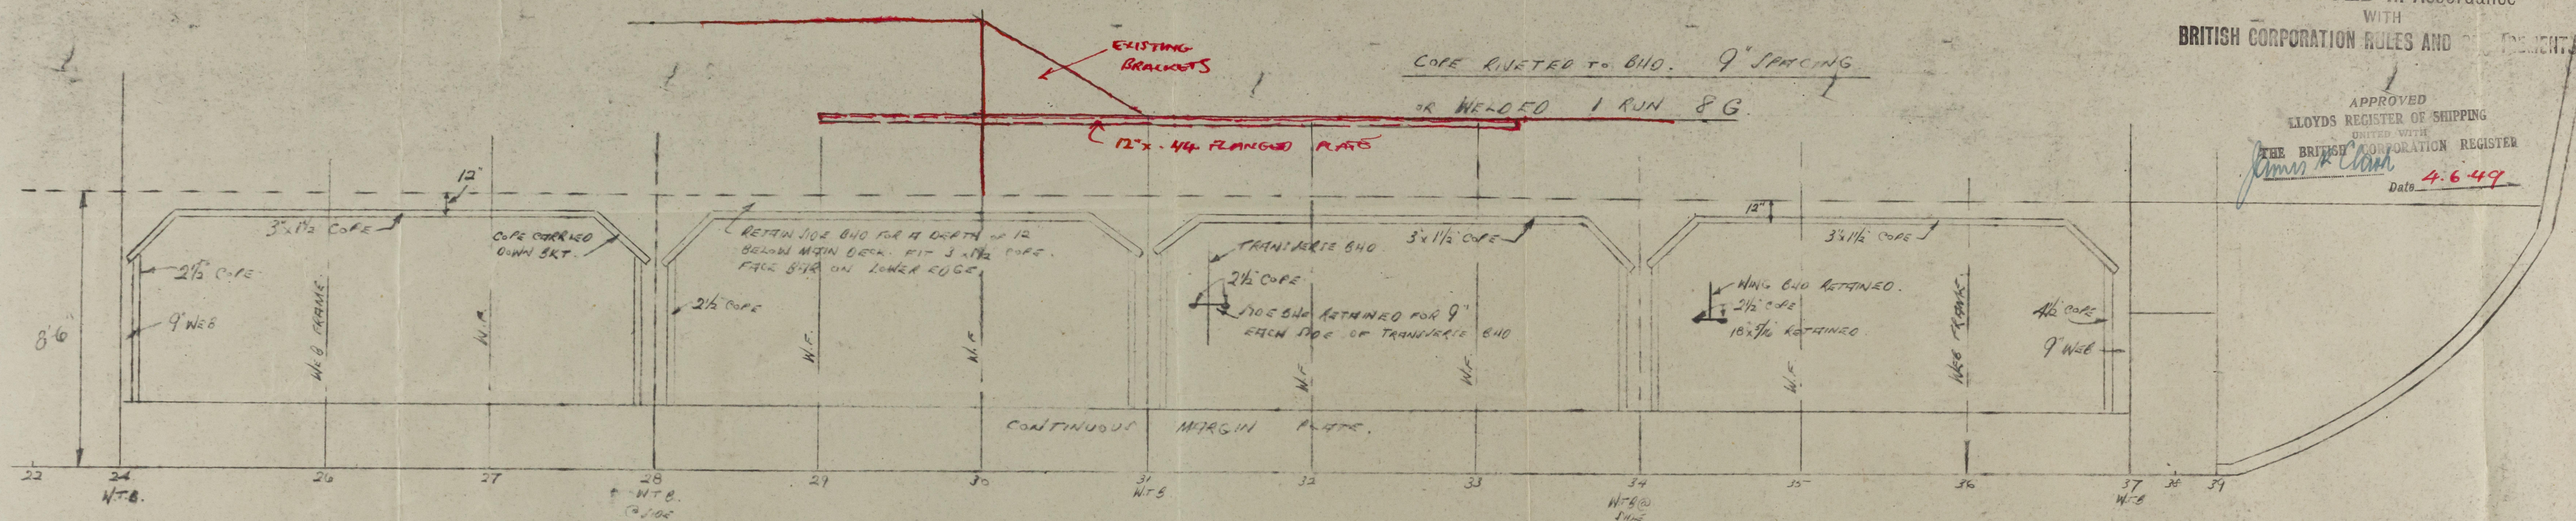


ELEVATION SHOWING EXTENT OF CHDS REMOVED AND  
PROVISIONS MADE FOR SUPPORT AND STRENGTH

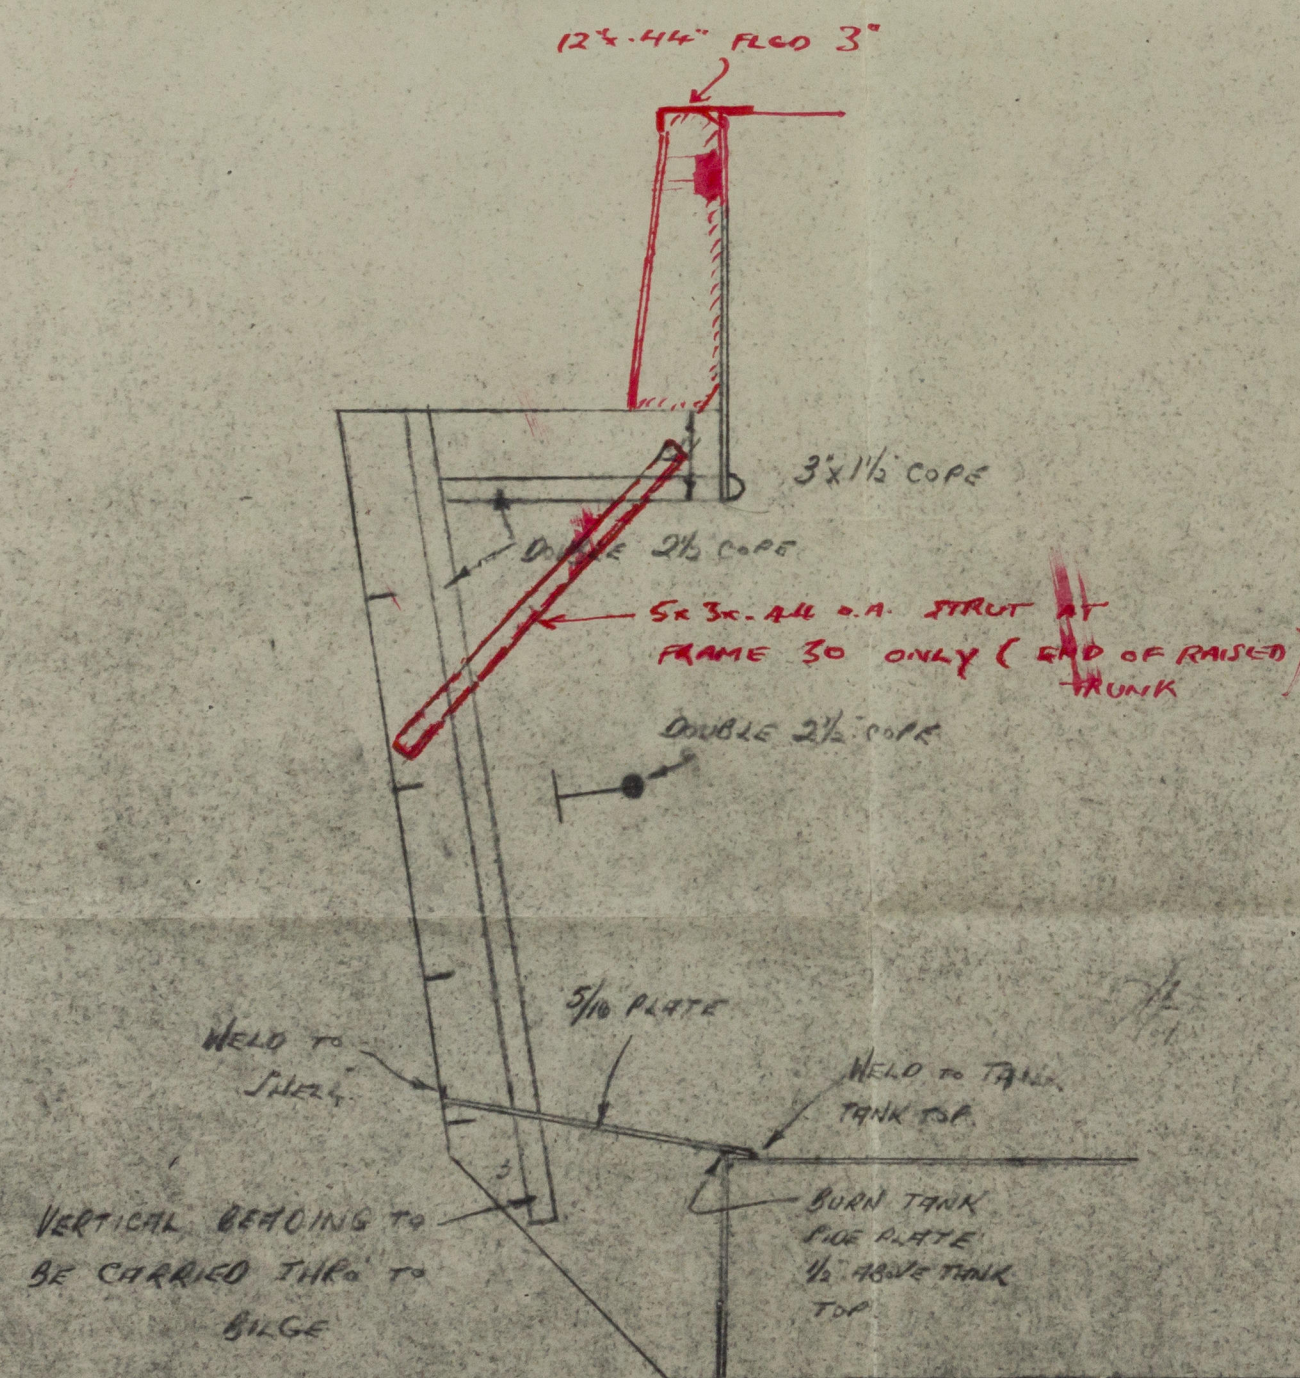

TYPICAL SECTION SHOWING WEB FRAME  
AND ARRANGEMENT OF NEW MARGIN PLATE

M.V. RULE GATEUSE

SKETCH SHOWING PROPOSED ALTERATION  
FOR STRUCTURAL ARRANGEMENTS OF  
LONG SIDE BHD.

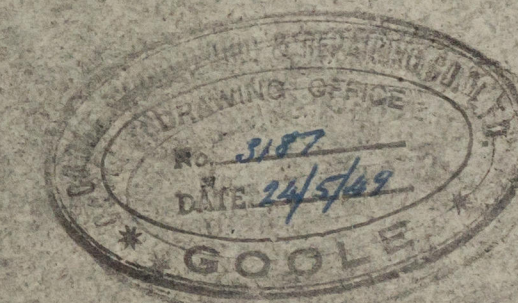

© 2020  
Lloyd's Register  
Foundation

003245-003251-0200



3

Altno Longtl. Side Bhd.

Sm Hullgate

Hull 27 MAY 1949

Altno for Longtl. Side

Longitudinal Bulkhead


Sm HULLGATE

Hull H.C. 1/9.

6

003245-003251-0200

003245-003251-0200

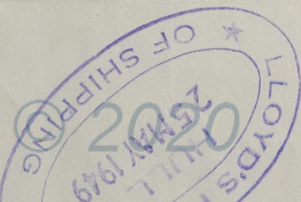

Lloyd's Register  
Foundation