

FABRIC


1 B & W

GOOLE SHIPBUILDING & REPAIRING COY.


EMPIRE FACET

SKETCH SHEWING SUGGESTED STRUCTURAL ARRANGEMENTS
RELATIVE TO PROPOSED REMOVAL OF SIDE LONG BHDS.


16-5-46

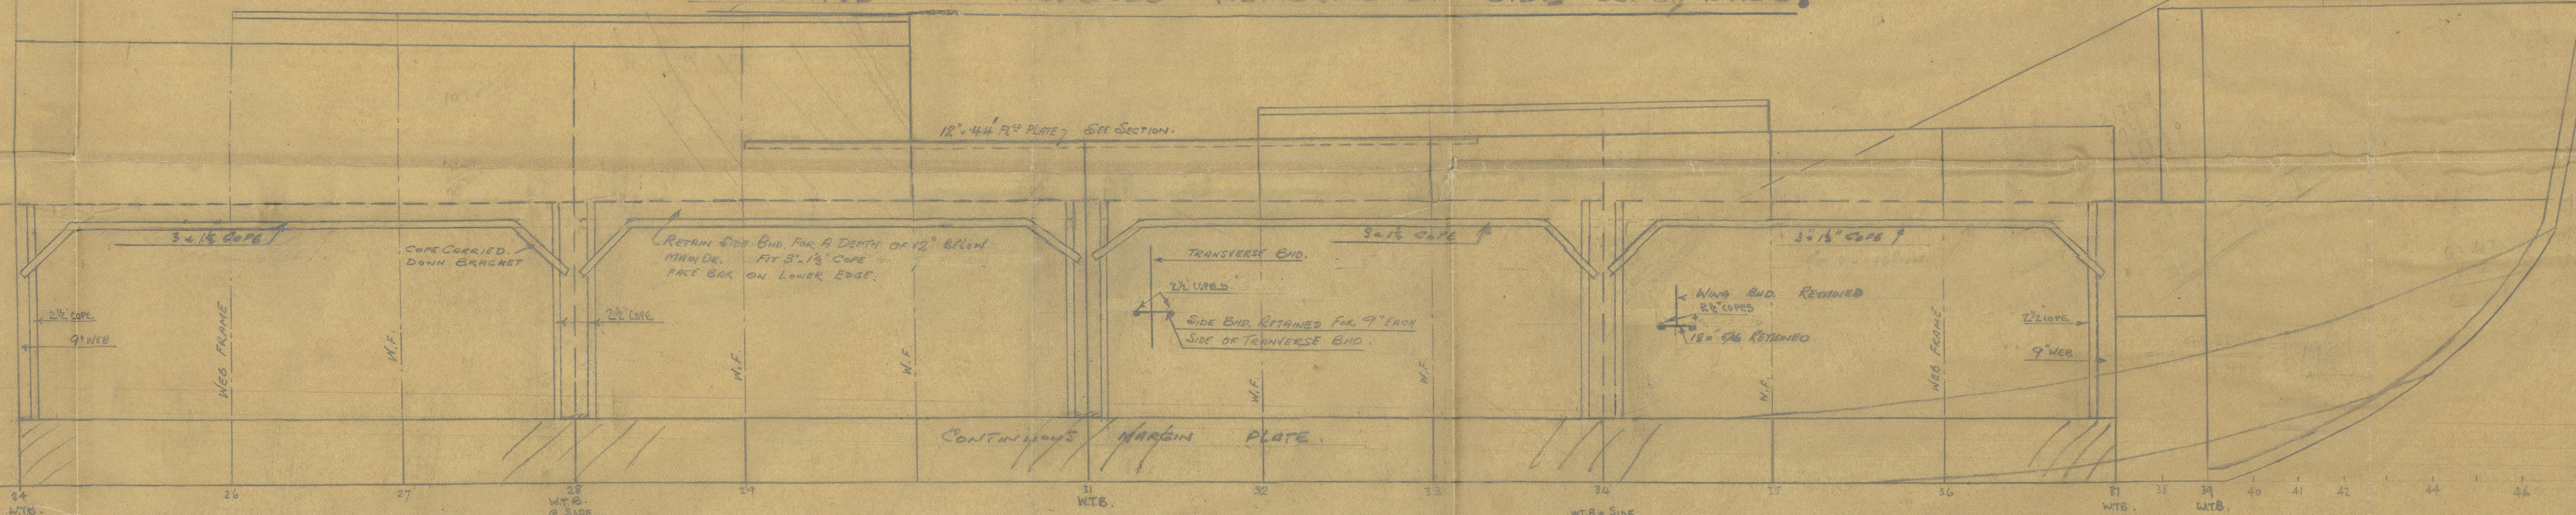

ELEVATION SHEWING EXTENT OF BHDS REMOVED AND
PROVISIONS MADE FOR DECK SUPPORT AND STRENGTH

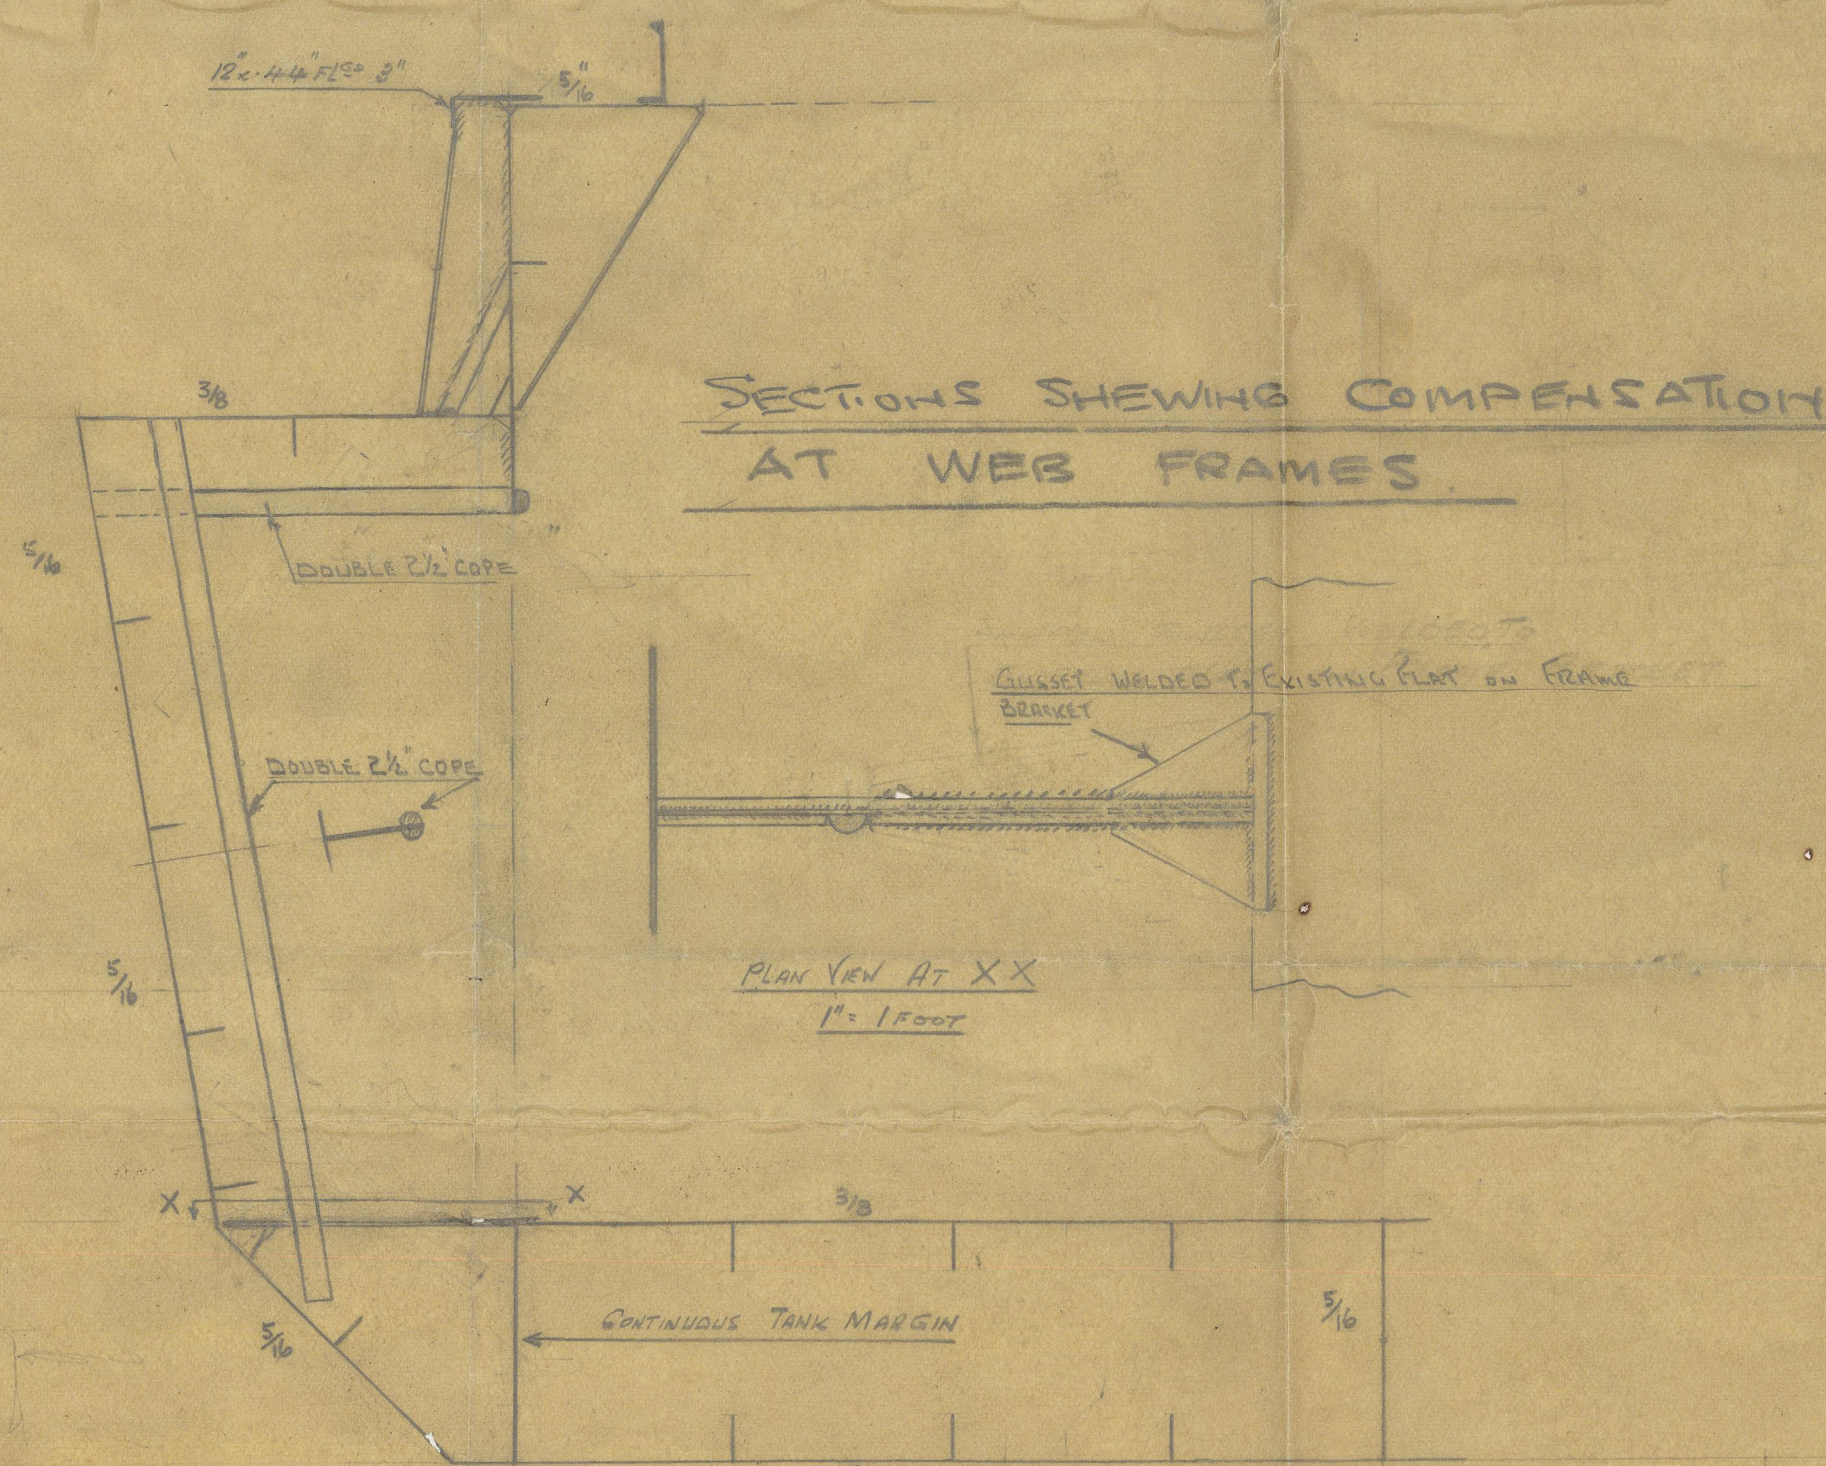

TYPICAL SECTION AT FRAME 33

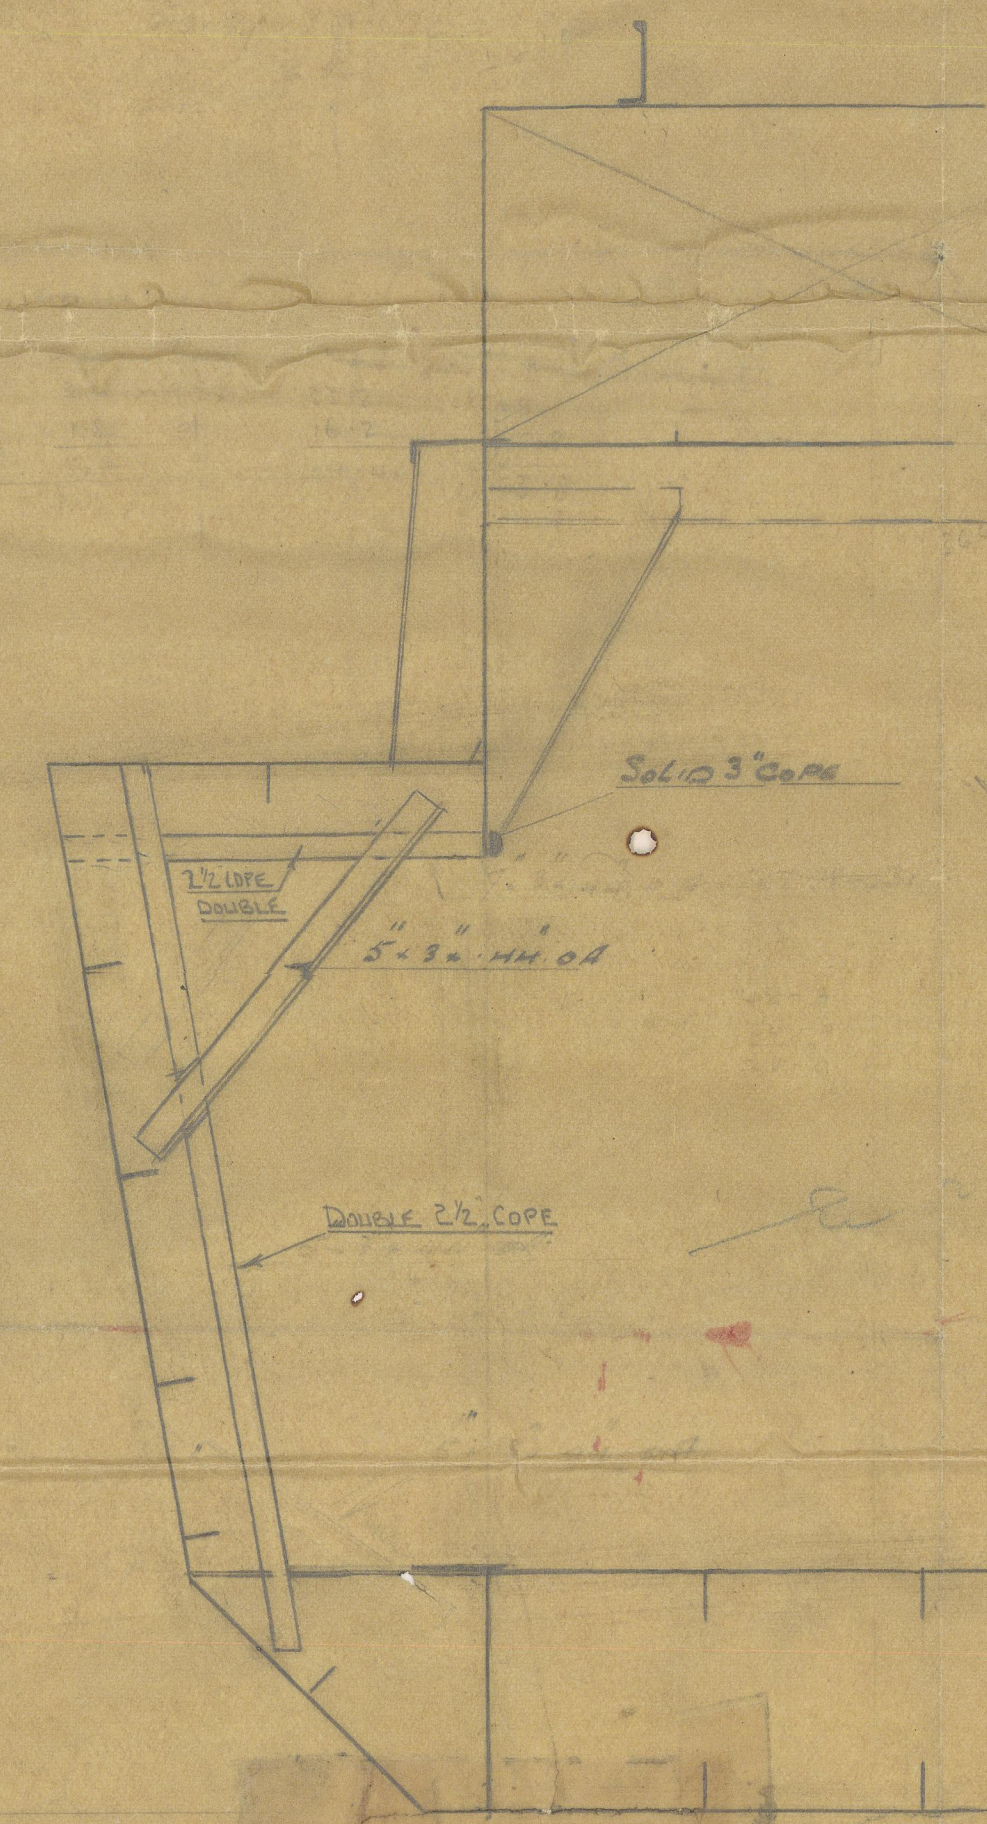

SECTION AT 30 FRAME (ONLY)

003245-003251-0201



© 2020
Lloyd's Register
Foundation

003245-003251-0201