


27 JUN 1949

Refer to Hull

M.V. HULLGATE


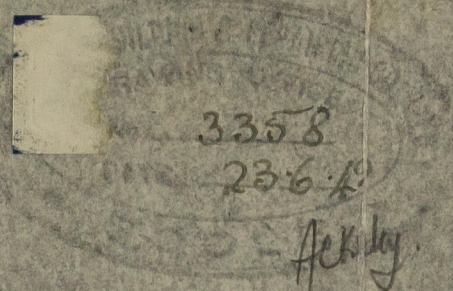


APPROVED
LLOYDS REGISTER OF SHIPPING
UNITED WITH
THE BRITISH CORPORATION REGISTER
SIGNED: JAMES R. CLARK.
Date 27.6.49.

APPROVED In Accordance
WITH
BRITISH CORPORATION RULES AND REQUIREMENTS

PROPOSED MODIFICATION TO
STIFFENERS ON HOLD COAMING.

SCALE $\frac{1}{2}" = 1 \text{ FOOT}$

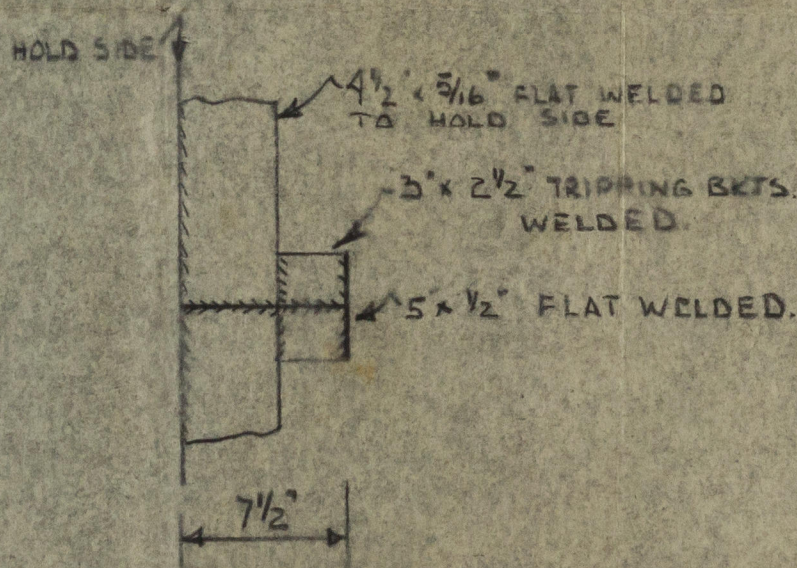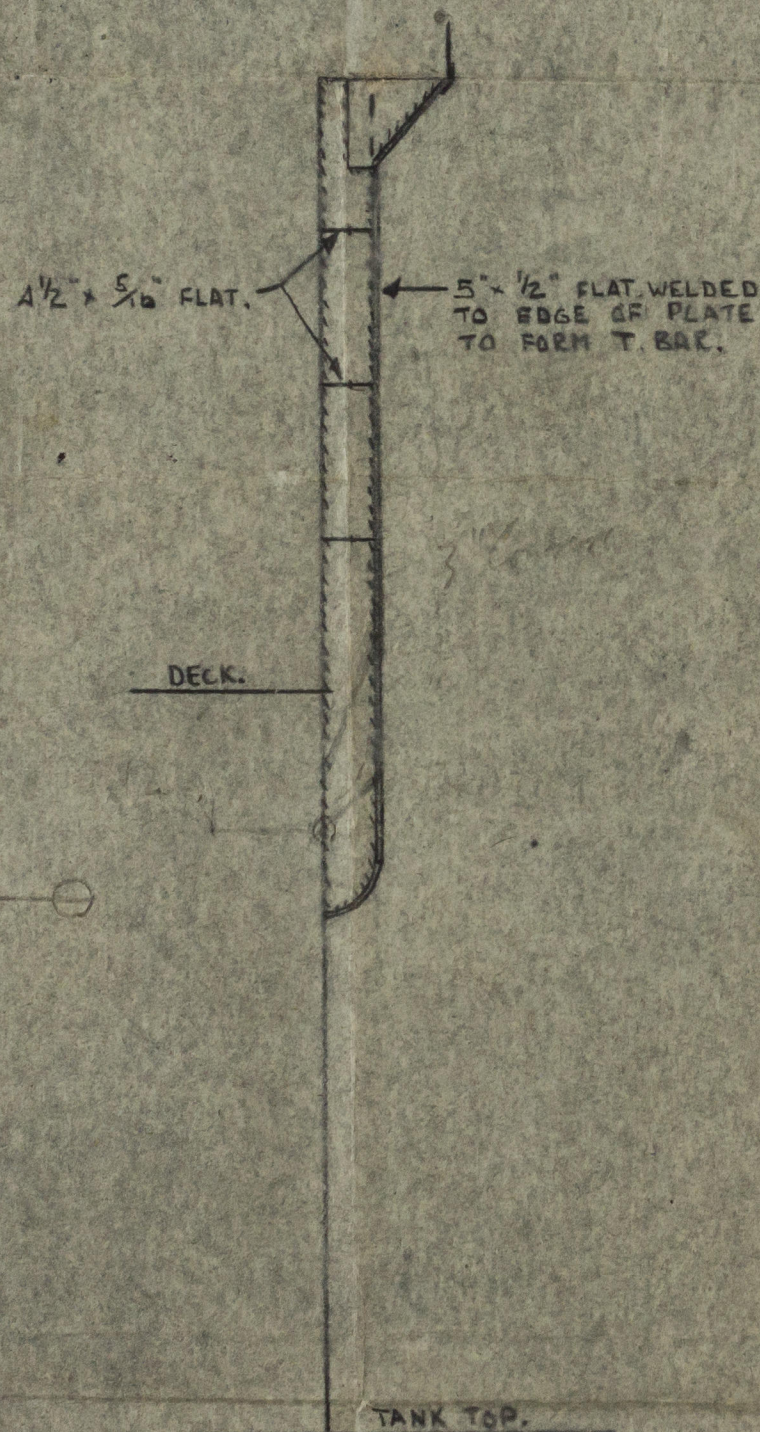

SECTION THRU STIFFENER

SCALE $\frac{1}{2}" = 1 \text{ FOOT}$

HULLGATE

AS FITTED.

M/V HULLGATE.

ALTERATIONS TO HOLDS

APP 27-6-49

Hull. 56165

003245-003251-0202

003245-003251-0202



© 2020

Lloyd's Register
Foundation