



APPROVED In Accordance  
WITH  
BRITISH CORPORATION RULES AND REGULATIONS

APPROVED  
LLOYDS REGISTER OF SHIPPING  
UNITED WITH  
THE BRITISH CORPORATION REGISTER  
SIGNED: JAMES R. CLARK.  
Date 4-6-49

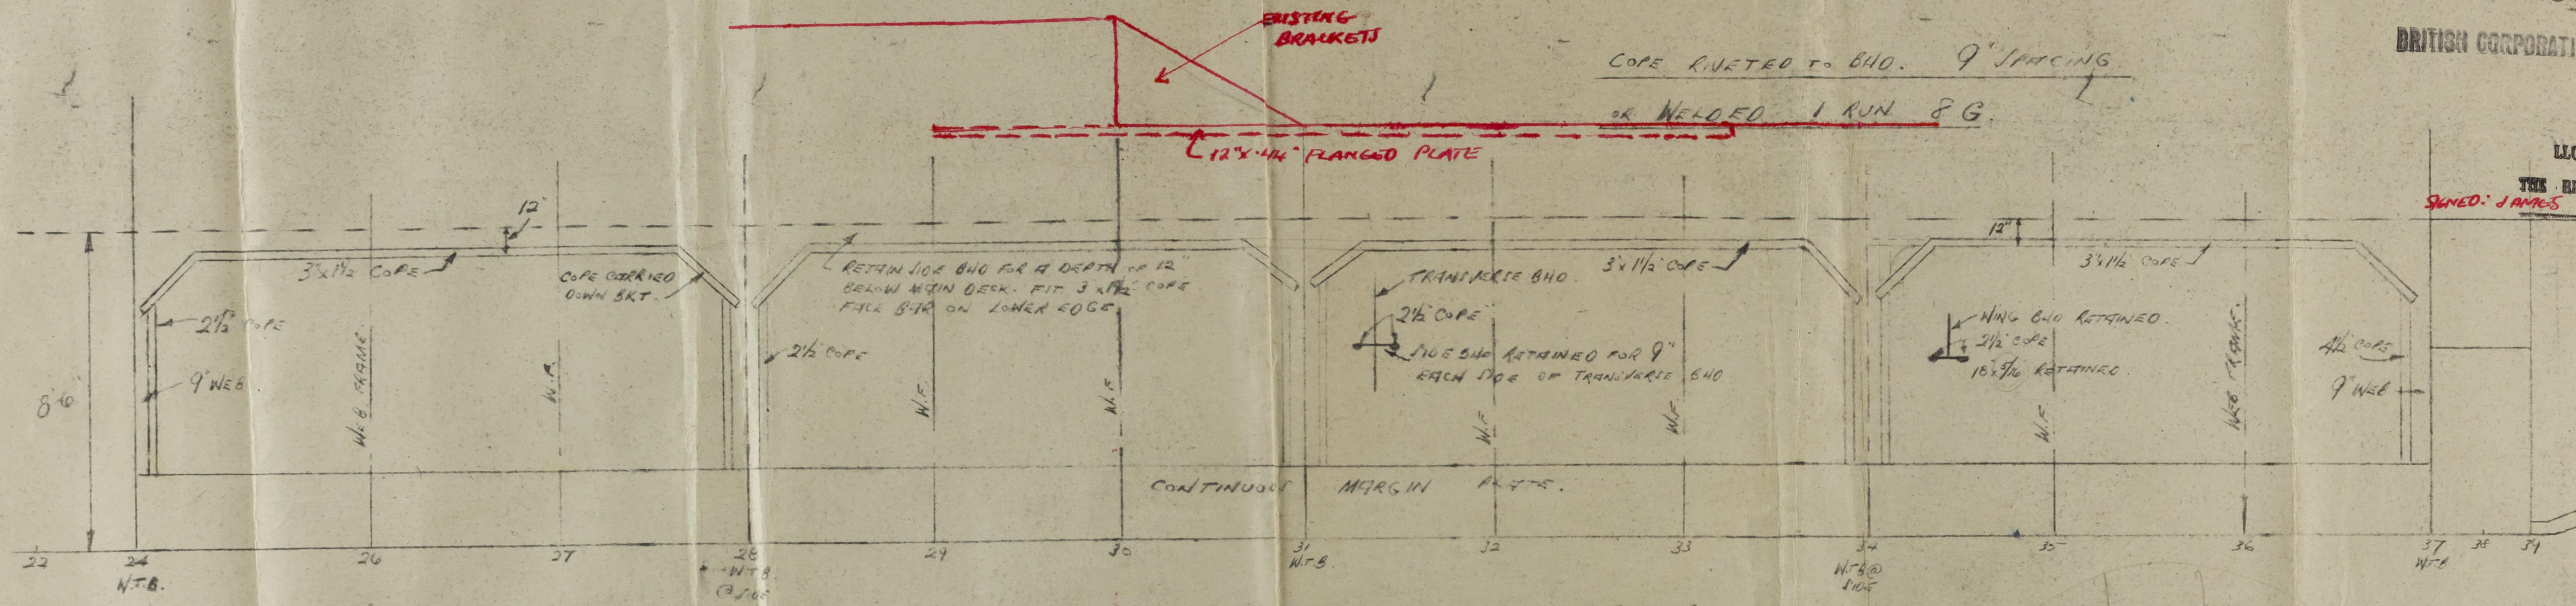

ELEVATION SHOWING EXTENT OF BHOS REMOVED AND PROVISIONS MADE FOR SUPPORT AND STRENGTH

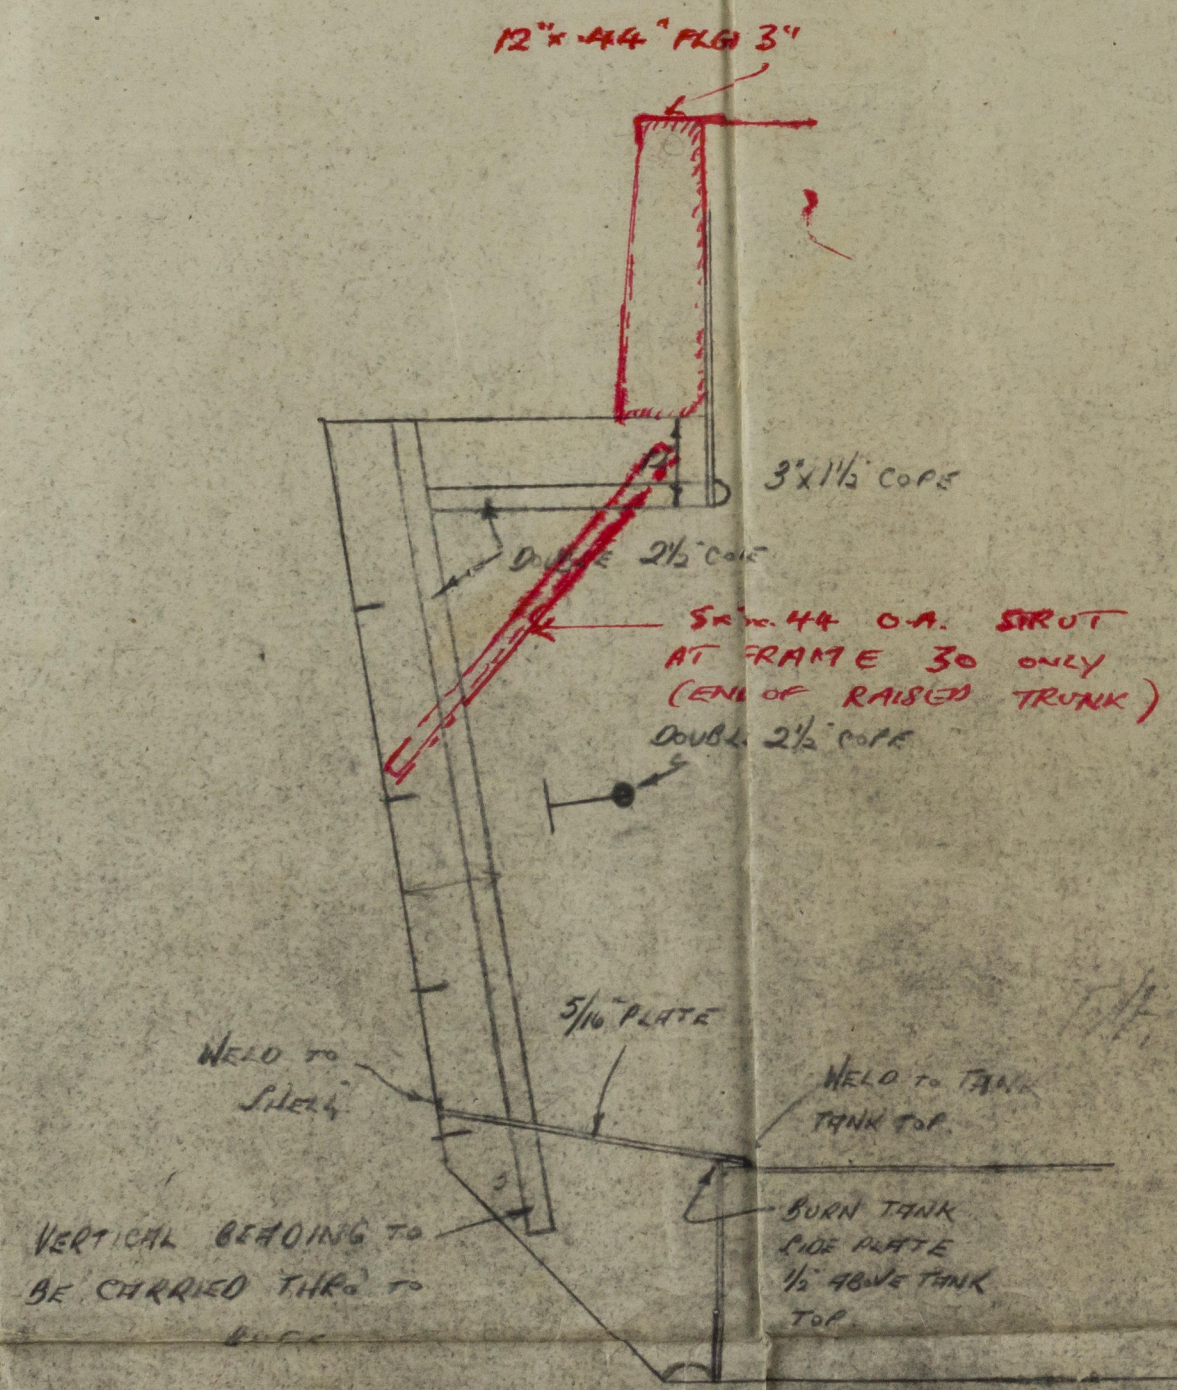

TYPICAL SECTION SHOWING WEB FRAME AND HRRGT & NEW MARGIN PLATE



M.V. HULL GATEWAY

SKETCH SHOWING PROPOSED ALTERATION FOR STRUCTURAL ARRANGEMENTS OF LONG<sup>TH</sup> SIDE BHO

Hullgate


AS FITTED.  
M/V HULLGATE.  
ALTERATIONS TO HOLDS  
BY  
REMOVAL OF SIDE TANKS.

APP 4-6-49

Hull. 56165

003245-003251-0203

003245-003251-0203

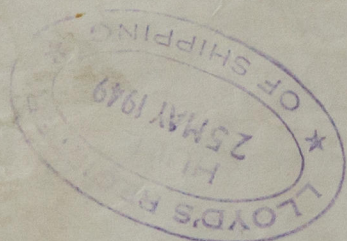

© 2020

Lloyd's Register  
Foundation