

REC'D NEW YORK JAN 29 1960

Index No. _____
(For London Office only.)


Lloyd's Register of Shipping.

SURVEYS FOR FREEBOARD.

(CONDITIONS OF ASSIGNMENT.)

Ship's Name "JONANCY" Port of Survey Newport News, Va.
 Official Number 376 Surveyor's Signature W.D. Wardle
 Nationality and Port of Registry Liberian, Monrovia Date of Survey Dec. 30th 1959, Jan. 4, 14 & 15th 1960.

Disposition and dimensions of superstructures, trunks, deckhouses and machinery casings to be inserted in the diagrams and tabular statement:—

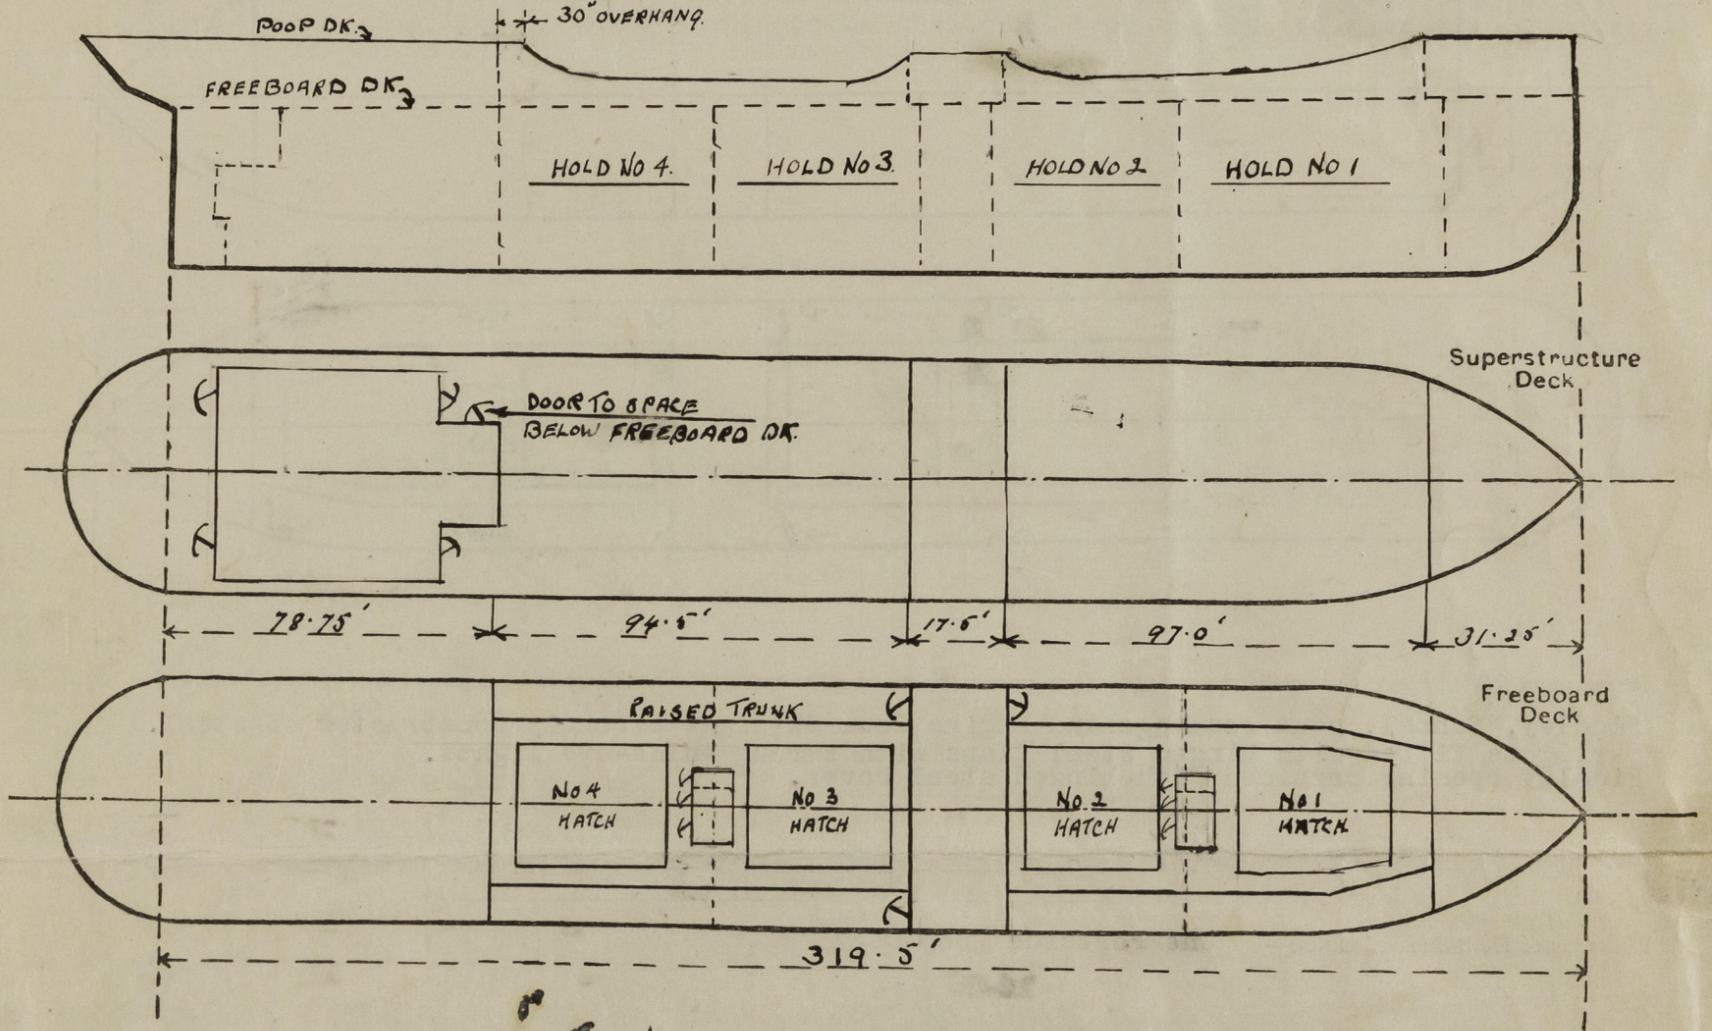

Particulars of Superstructures, Trunks, Casings, Deckhouses.


	Coaming	Plating	Stiffeners	Spacing	End Attachments of Stiffeners	Size of Openings	Height of Sills	Height of Casings
Poop Bulkhead ...		1/2"	7x3 1/2"x3/8"	28"	None	None	-	7'-6"
Raised Quarter Deck Bulkhead ...								
Bridge, After Bulkhead ...	1/2"	3/8"	7x3 1/2"x3/8"	28"	None	24" x 60"	18"	9'-6"
Bridge, Forward Bulkhead ...	1/2"	1/2"	7x3 1/2"x1/2"	27" & 32"	Brackets 15"x18"x1/2"	one P.S. 24" x 60"	18"	9'-6"
Forecastle Bulkhead ...	1/2"	3/8"	6x3 1/2"x3/8"	28"	None	25 1/2" x 63"	15 1/2"	8'-0"
Trunk, Aft ...								
Trunk, Forward ...								
Exposed Machinery Casings on Freeboard or Raised Quarter Decks ...	-	1/2"	7x3 1/2"x3/8"	28"	None	None		7'-6"
Exposed Machinery Casings on Superstructure Decks ...	1/2"	1/2"	7x3 1/2"x3/8"	28"	None	None	-	7'-3"
Machinery Casings within Superstructures not fitted with Class I Closing Appliances ...								
Deckhouses on Flush Deck Ships ...								

Particulars of Closing Appliances (state if capable of being manipulated from both sides).



Poop Bulkhead ...	None NO OPENINGS							
Raised Quarter Deck Bulkhead ...								
Bridge, After Bulkhead ...	2 hinged steel w.t. doors				Operated from both sides.			
Bridge, Forward Bulkhead ...	1	"	"	door (port side)	"	"	"	"
Forecastle Bulkhead ...	2 hinged " " doors							
Exposed Machinery Casings on Freeboard or Raised Quarter Decks ...								
Exposed Machinery Casings on Superstructure Decks ...	1	"	"	door (port side)	"	"	"	"
Machinery Casings within Superstructures not fitted with Class I Closing Appliances ...								
Deckhouses on Flush Deck Ships ...								

PARTICULARS OF PROTECTION TO OPENINGS, ETC.

HATCHWAYS ON FREEBOARD AND SUPERSTRUCTURE DECKS.						
Description of Hatchway	No. 1	No. 2	No. 3	No. 4		
Dimensions of Hatchway	see sketch below	30" x 28"	30" x 28"	30" x 28"		
COAMINGS	Height above Deck Trunk 24" above deck and coaming 12" above trunk. Thickness (Sides ... 10" x 3 1/2" x 1/2" ea. side for full length of trunk. Ends ... Stiffeners ... Brackets, Stays ...					
HATCH BEAMS	Number ... Spacing ... Scantling and Sketch ... None Bearing Surface ...					
FORE AND AFTERS	Number ... 11 Spacing ... 30"-0" Unsupported Lengths ... Scantling and Sketch ... Bearing Surface ...					
HATCH COVERS	Material ... Steel Thickness ... 3/8 How fitted ... Bearing Surface ...					
Spacing of Cleats	27"					
Number of Tarpaulins						
Spacing of 1" Dia. Securing Bolts 39" Fore and Aft. 39" Port and Starboard.						
*Are wood fore and afters steel shod at all bearing surfaces? None Are battens and wedges efficient and in good condition? Yes Are tarpaulins in good condition and in accordance with rule requirements? None Are lashings provided in accordance with rule requirements? "						

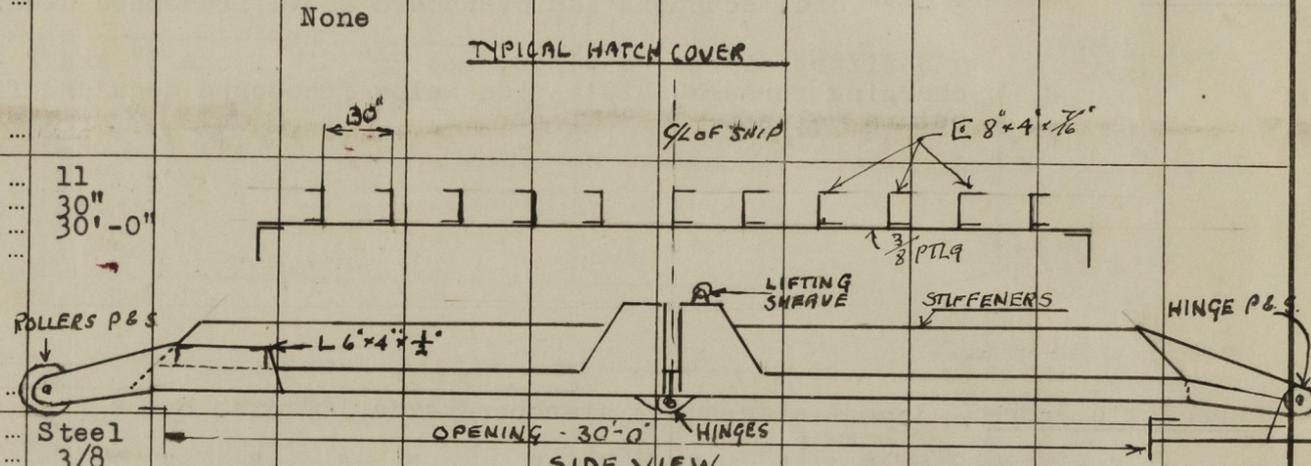

Particulars of any special features:—

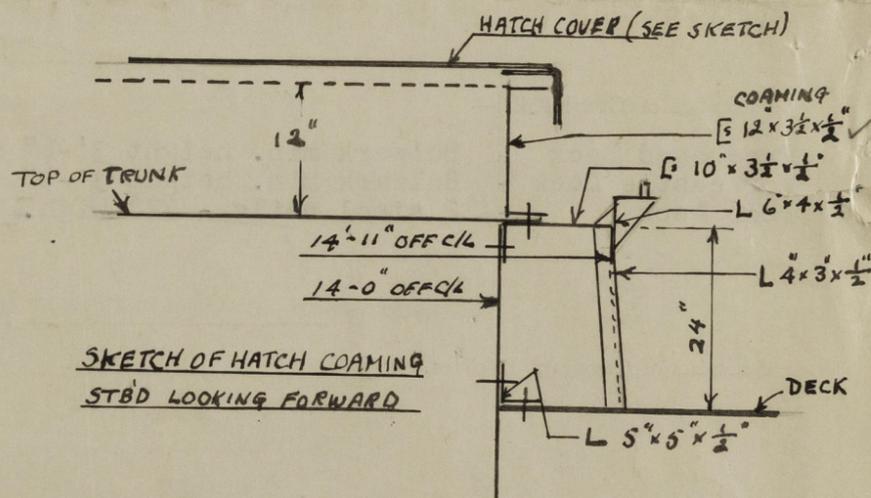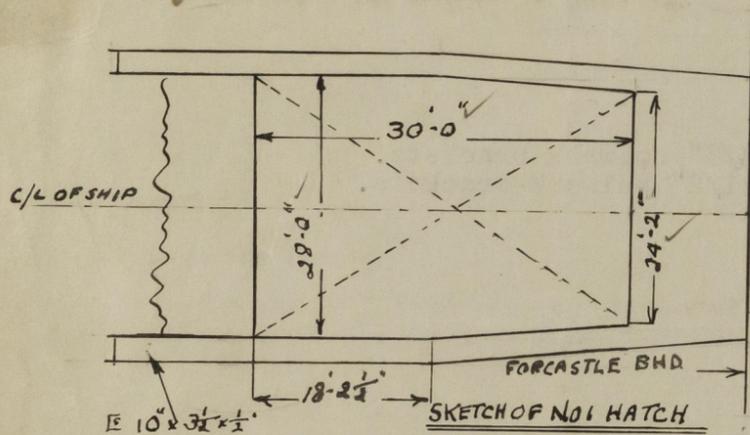

Endorsement at first survey and at surveys for renewal of Certificate:—

The fittings and appliances are in accordance with the particulars shown on this form (or as now modified) and are in good condition.