



SCALE 1" = 1'-0"

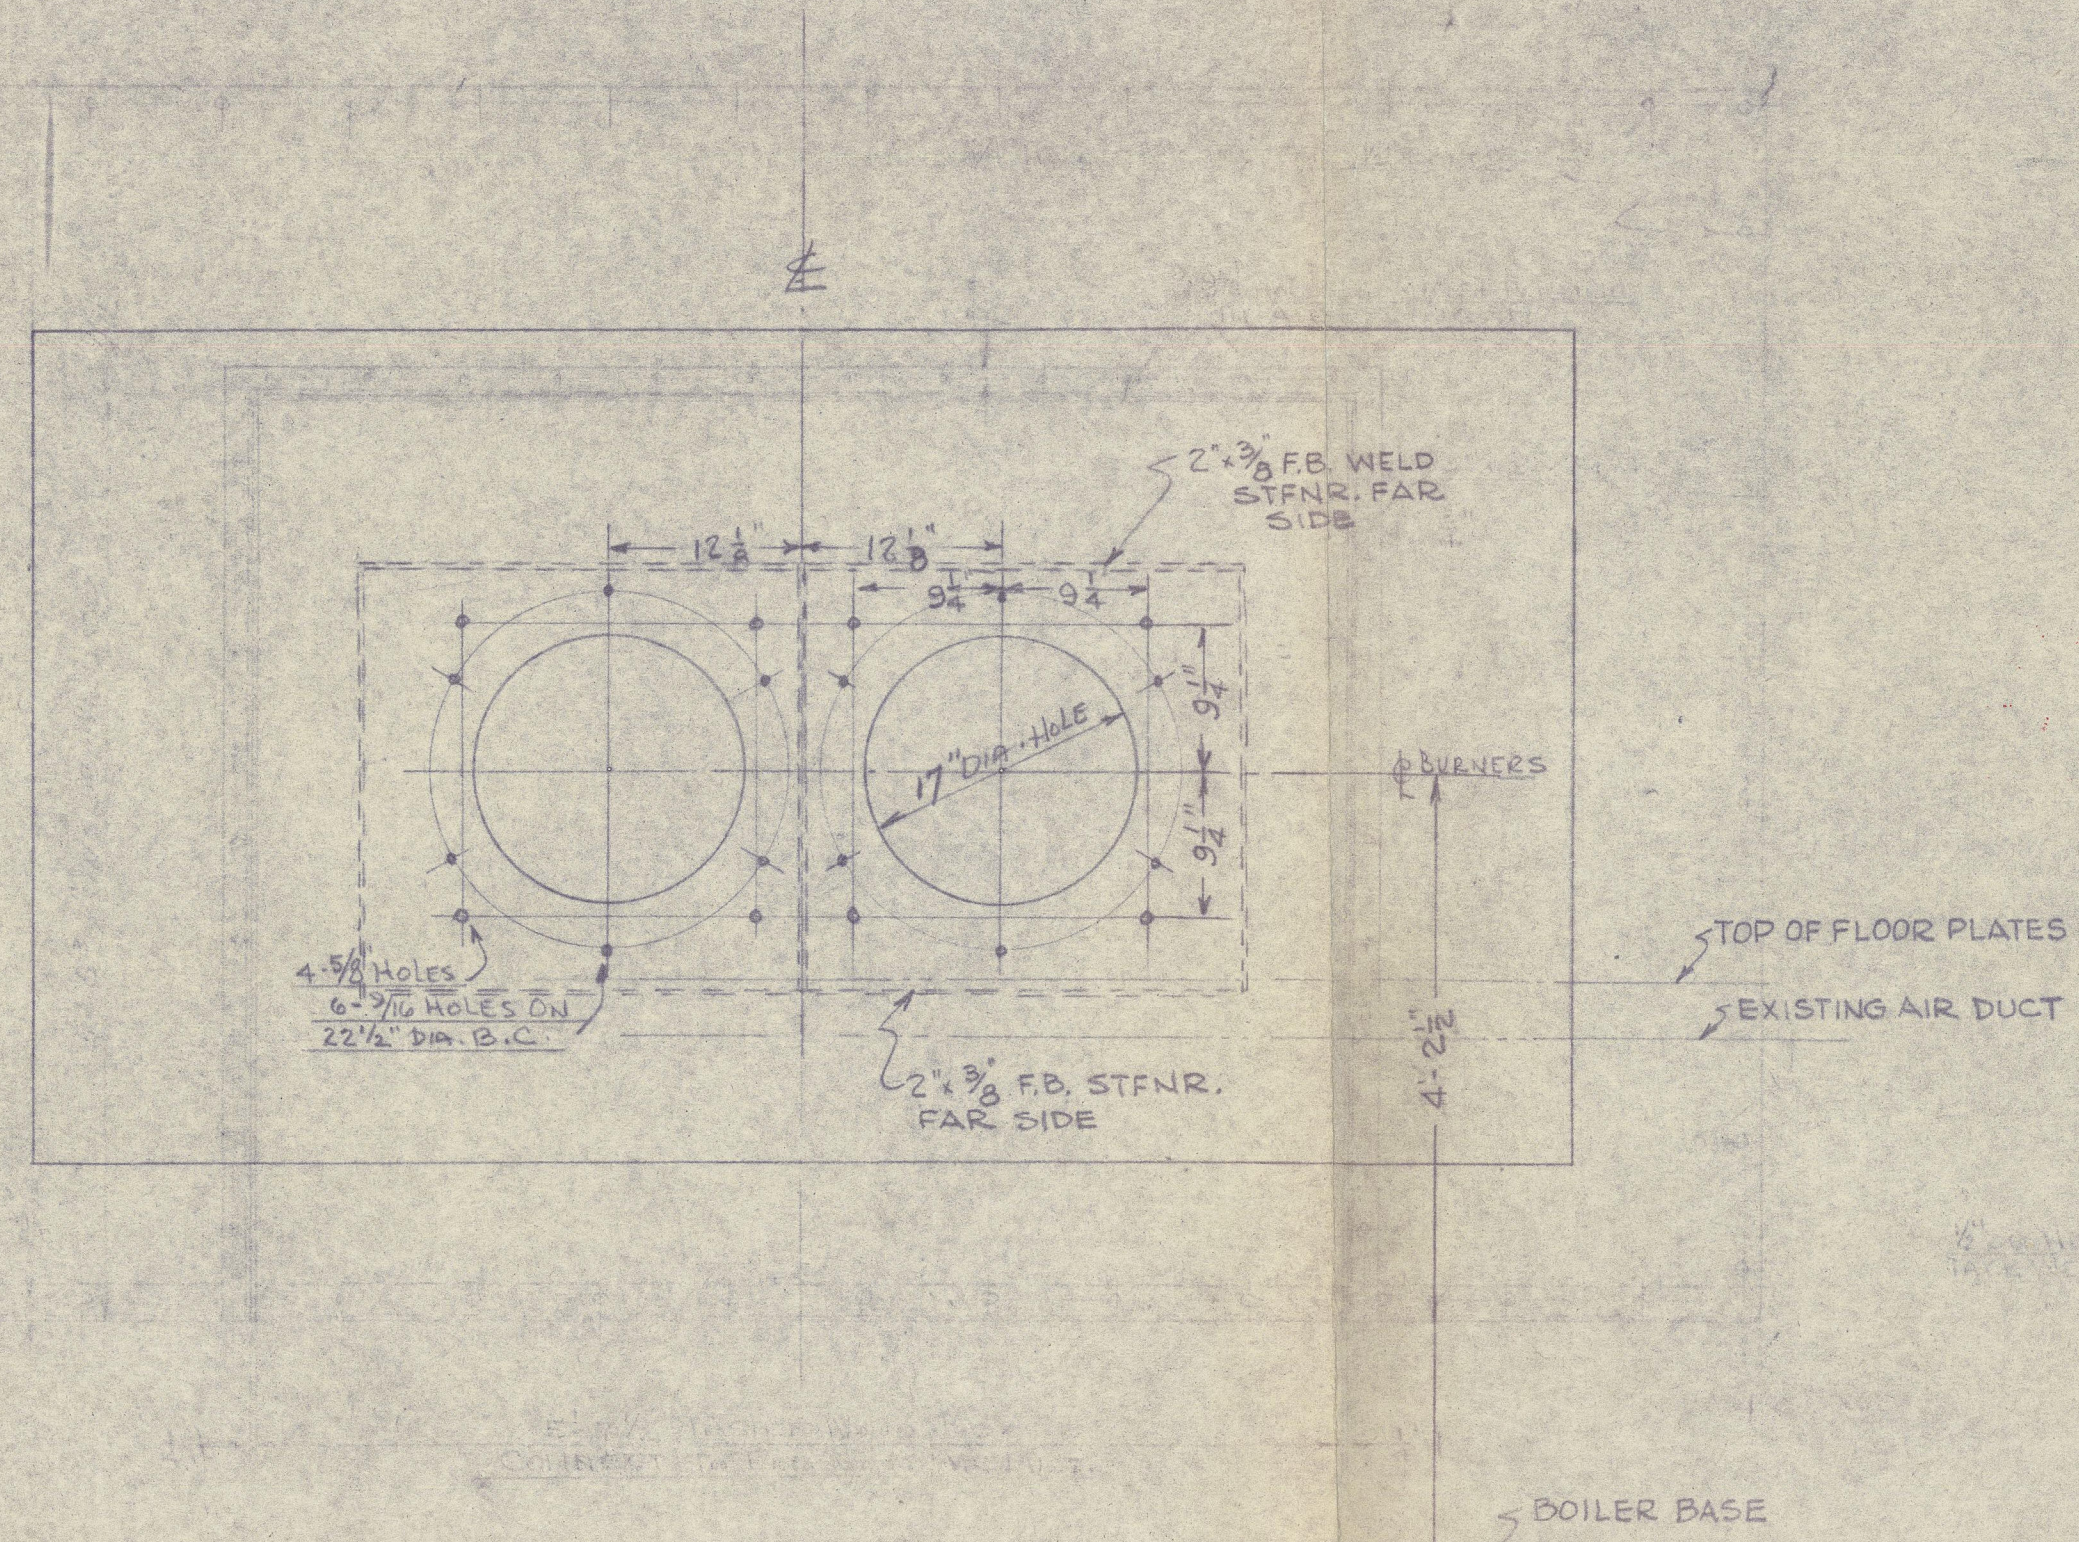


1/4" FRONT PLATE - EXISTING
LESS AIR CASING PLATE

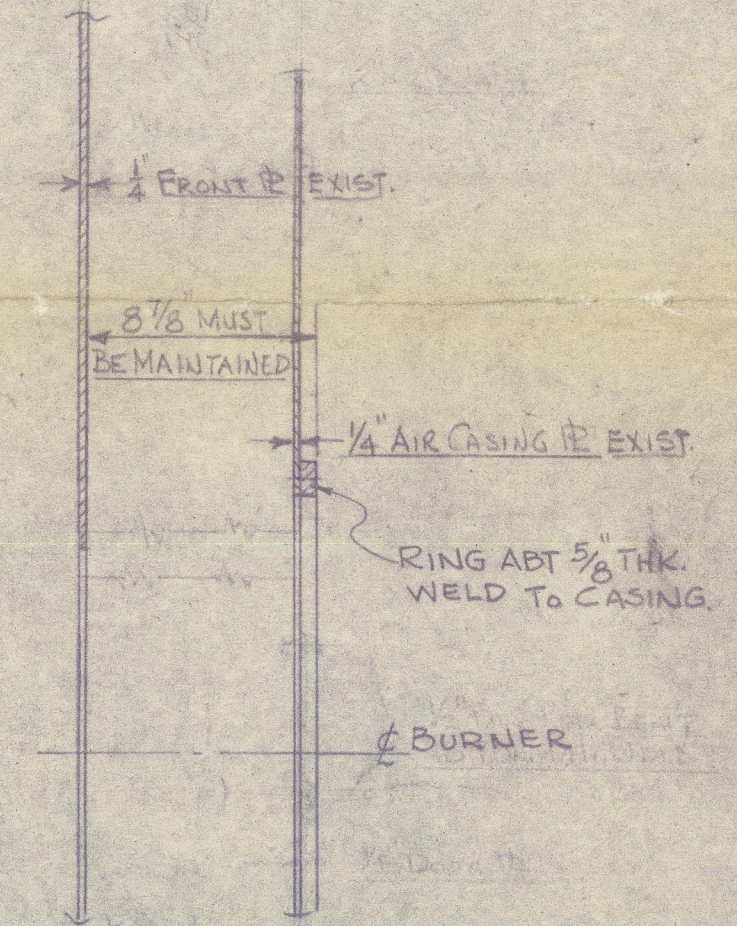

SECTION THRU WIND BOX
SCALE 1 1/2" = 1'-0"


APPROVED
JUL 23 1952
LLOYD'S REGISTER OF SHIPPING
NEW YORK

noted
END
2/8/52

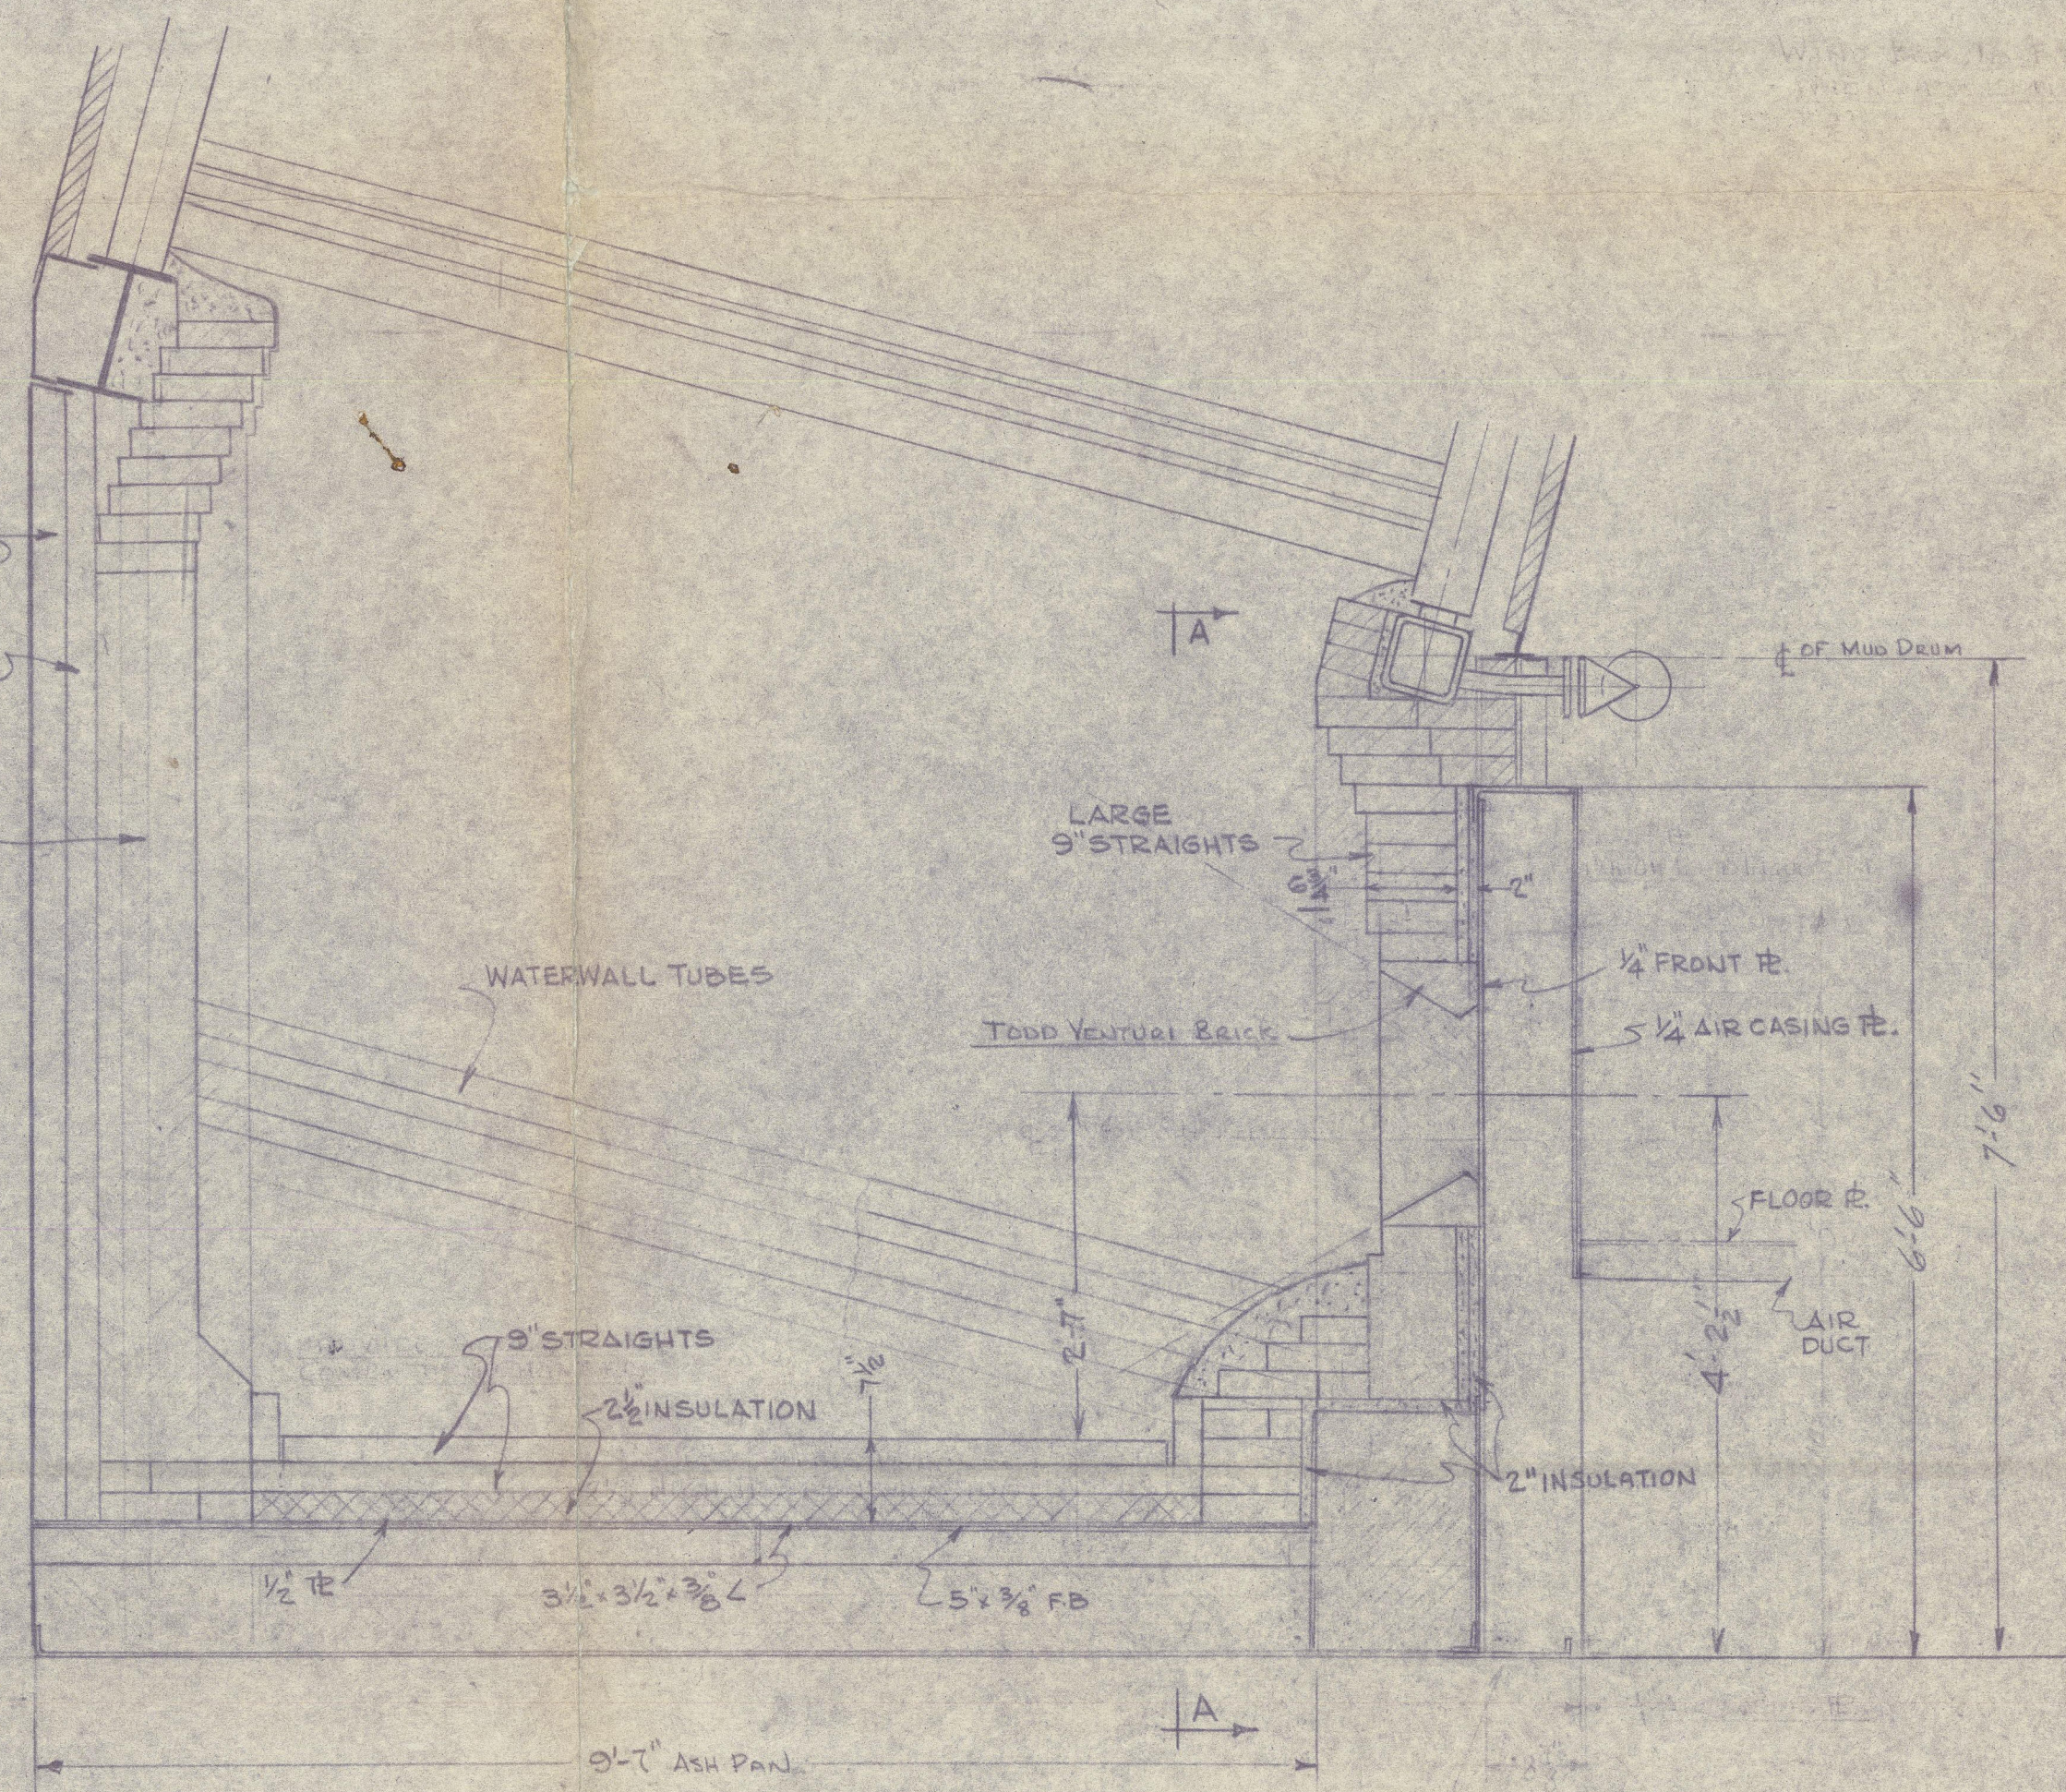

LONGITUDINAL SECTION

SCALE 3/4" = 1'-0"

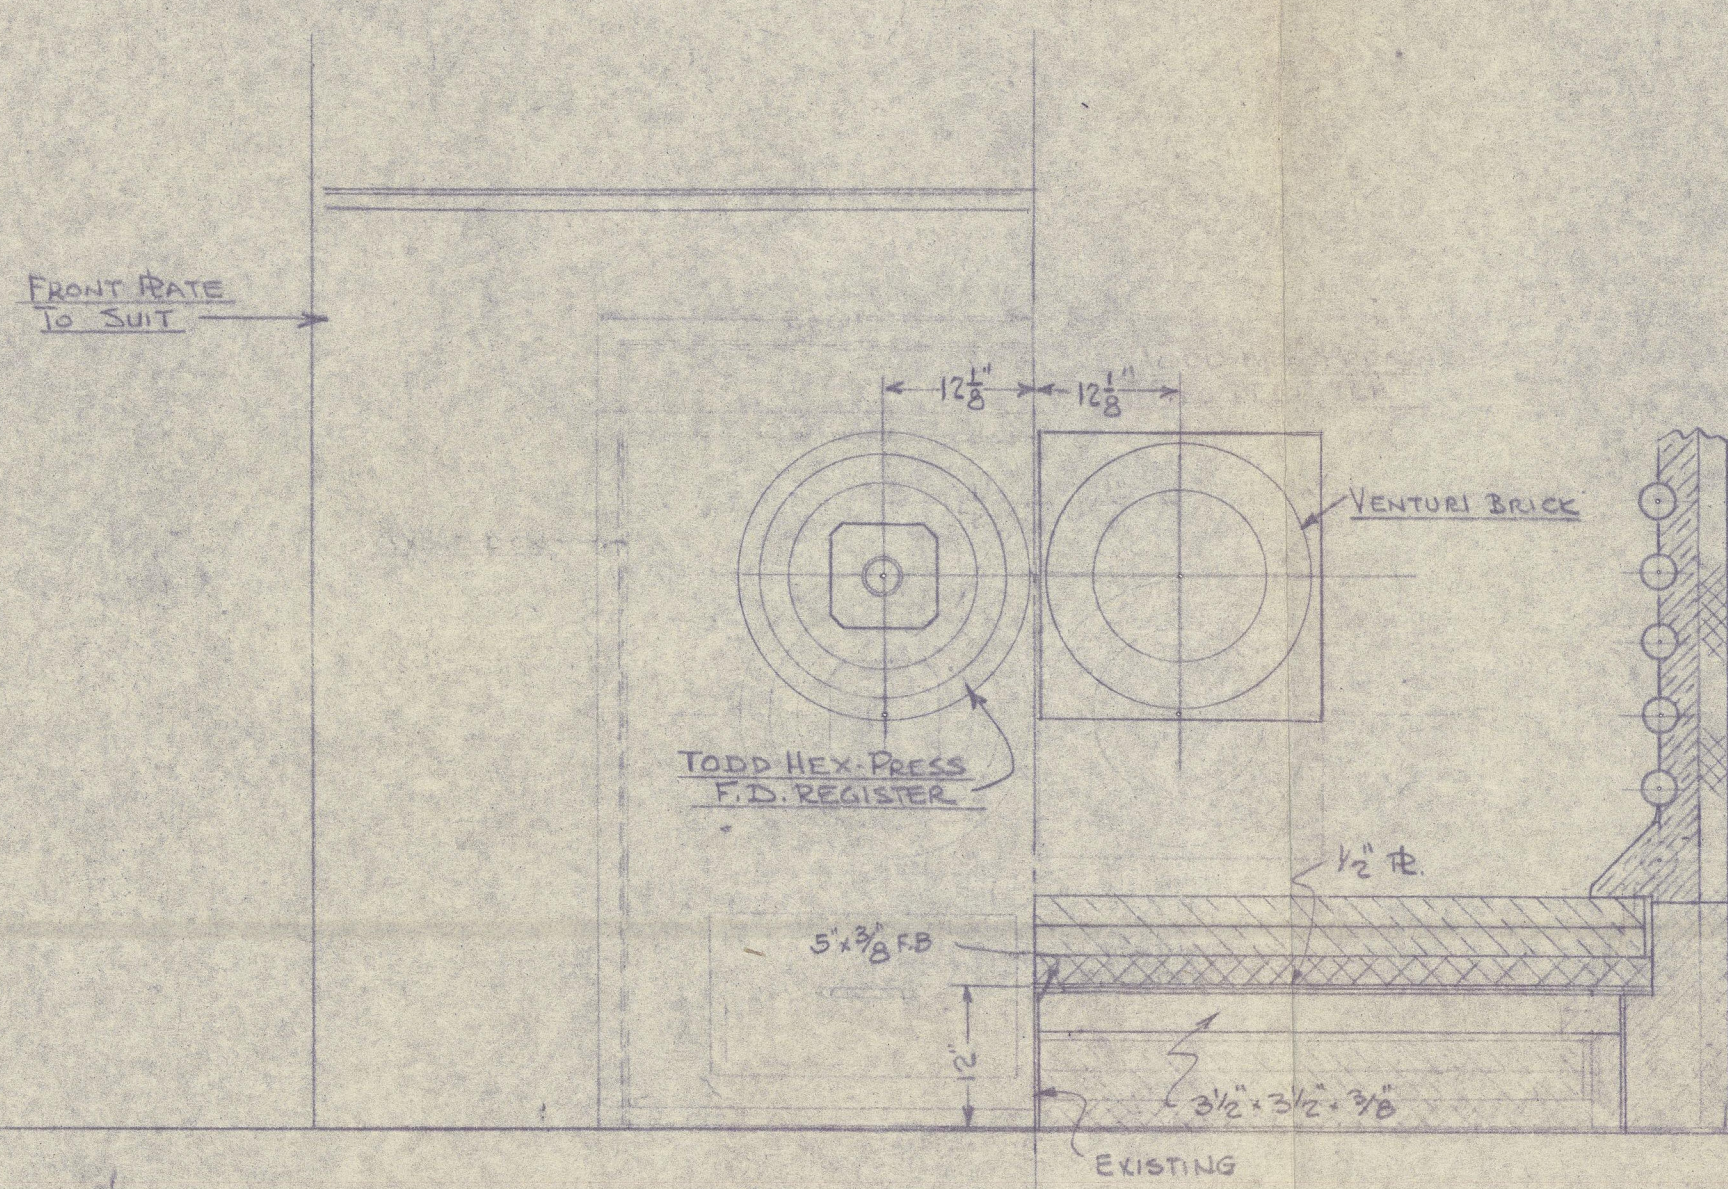

HALF FRONT ELEVATION — HALF SECTION A-A —

1 ALTERED TO SUIT VESSEL.

JOB NO. A2712A
PROPOSAL NO.

TODD SHIPYARDS CORPORATION
COMBUSTION EQUIPMENT DIVISION
81-16 45TH (LAUREL HILL BLVD) AVE.
ELMHURST, QUEENS, N. Y.

FURNACE ARRGT & WIND BOX
DETAILS FOR MARINE TYPE B&W
BOILER 40 T.H.P. FIRED WITH 2
TODD HEX PRESS F.D. REGISTERS
— 5/5 JONAN 0020 —

DRAWN J.A.K. APPROVED
CHECKED DATE 6-18-52
SCALE AS NOTED