


3 ANCHORS INCL. STOCK 8 1/2 - CWT
1 STREAM ANCHOR " 9.69 CWT
1 KEDGE " 5.31 CWT

240 FTH. STUDCHAIN CABLE 1 10/16" φ
145 FTH. STUDCHAIN CABLE 1" φ
90 " STEELWIRE 3/8" CIRCUMF.

2 X 90 " HEMP 6" " "
2 X 90 " 5" " "

EDGE LIPS MAINDECK AND POOPDECK SINGLE
BUTT " DECKPL. DOUBLE FOR 1/2 L. SINGLE STENDS
" " STRINGER TREBLE " " DOUBLE " "

EDGES INNER BOTTOM PLATING DOUBLE
BUTTS " " " "
" CENTRE GIRDER TREBLE

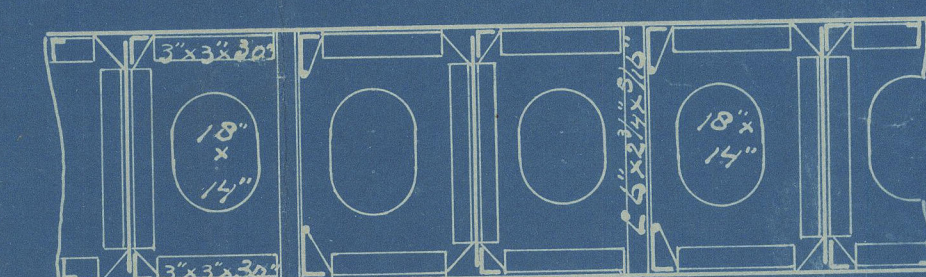

Mixsh. Section for Lloyd's approval.

P. Smit 316-7

Gen Box 3122

S.S. "Argo"

Pol. 11690.

PLANS TRANSFERRED
TO SISTER VESSEL

Pjarnu Lns 53/

WILL

10 Coldenham

EXHIBITION

Lloyd's Register
Foundation

003252-003262-0157