
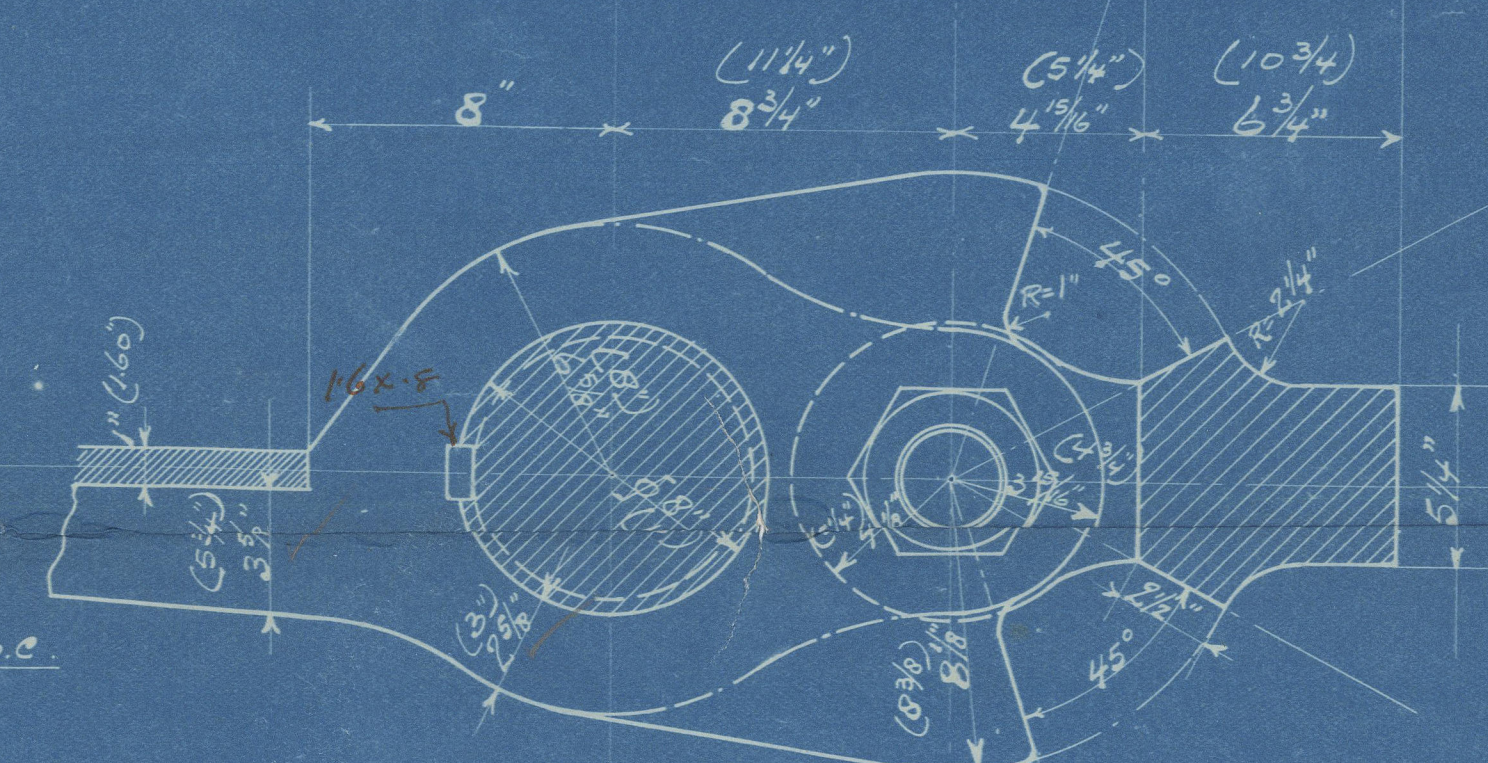
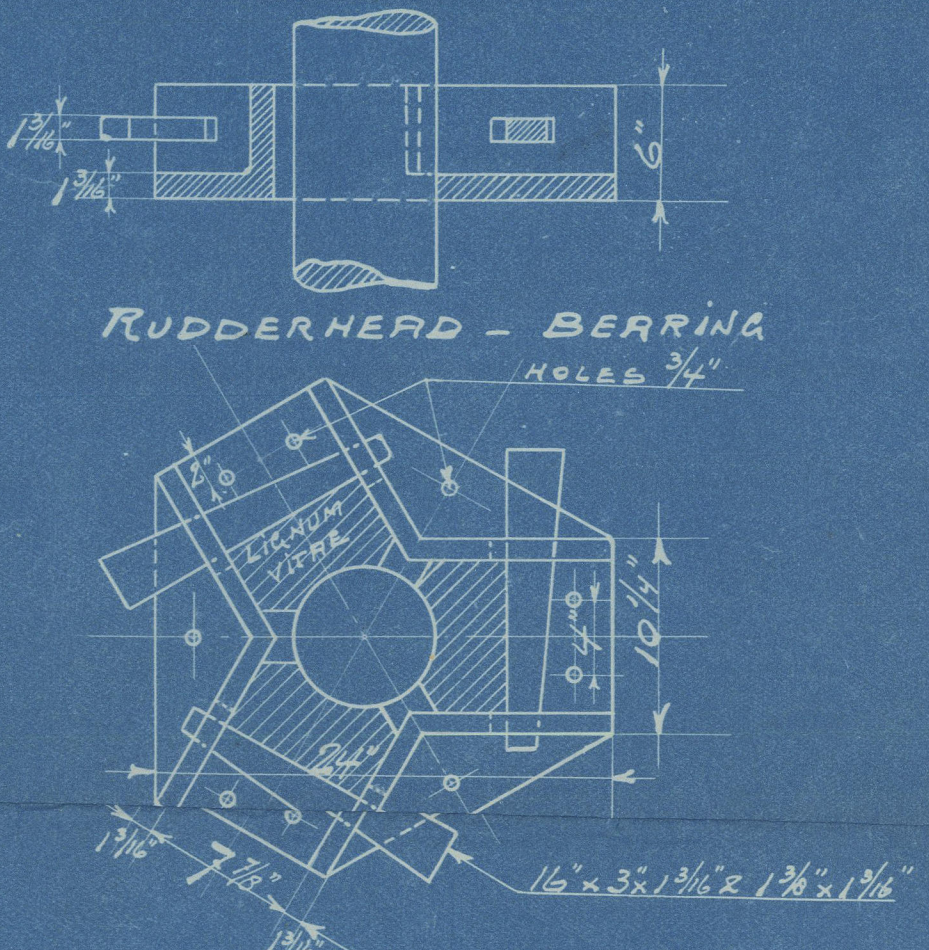
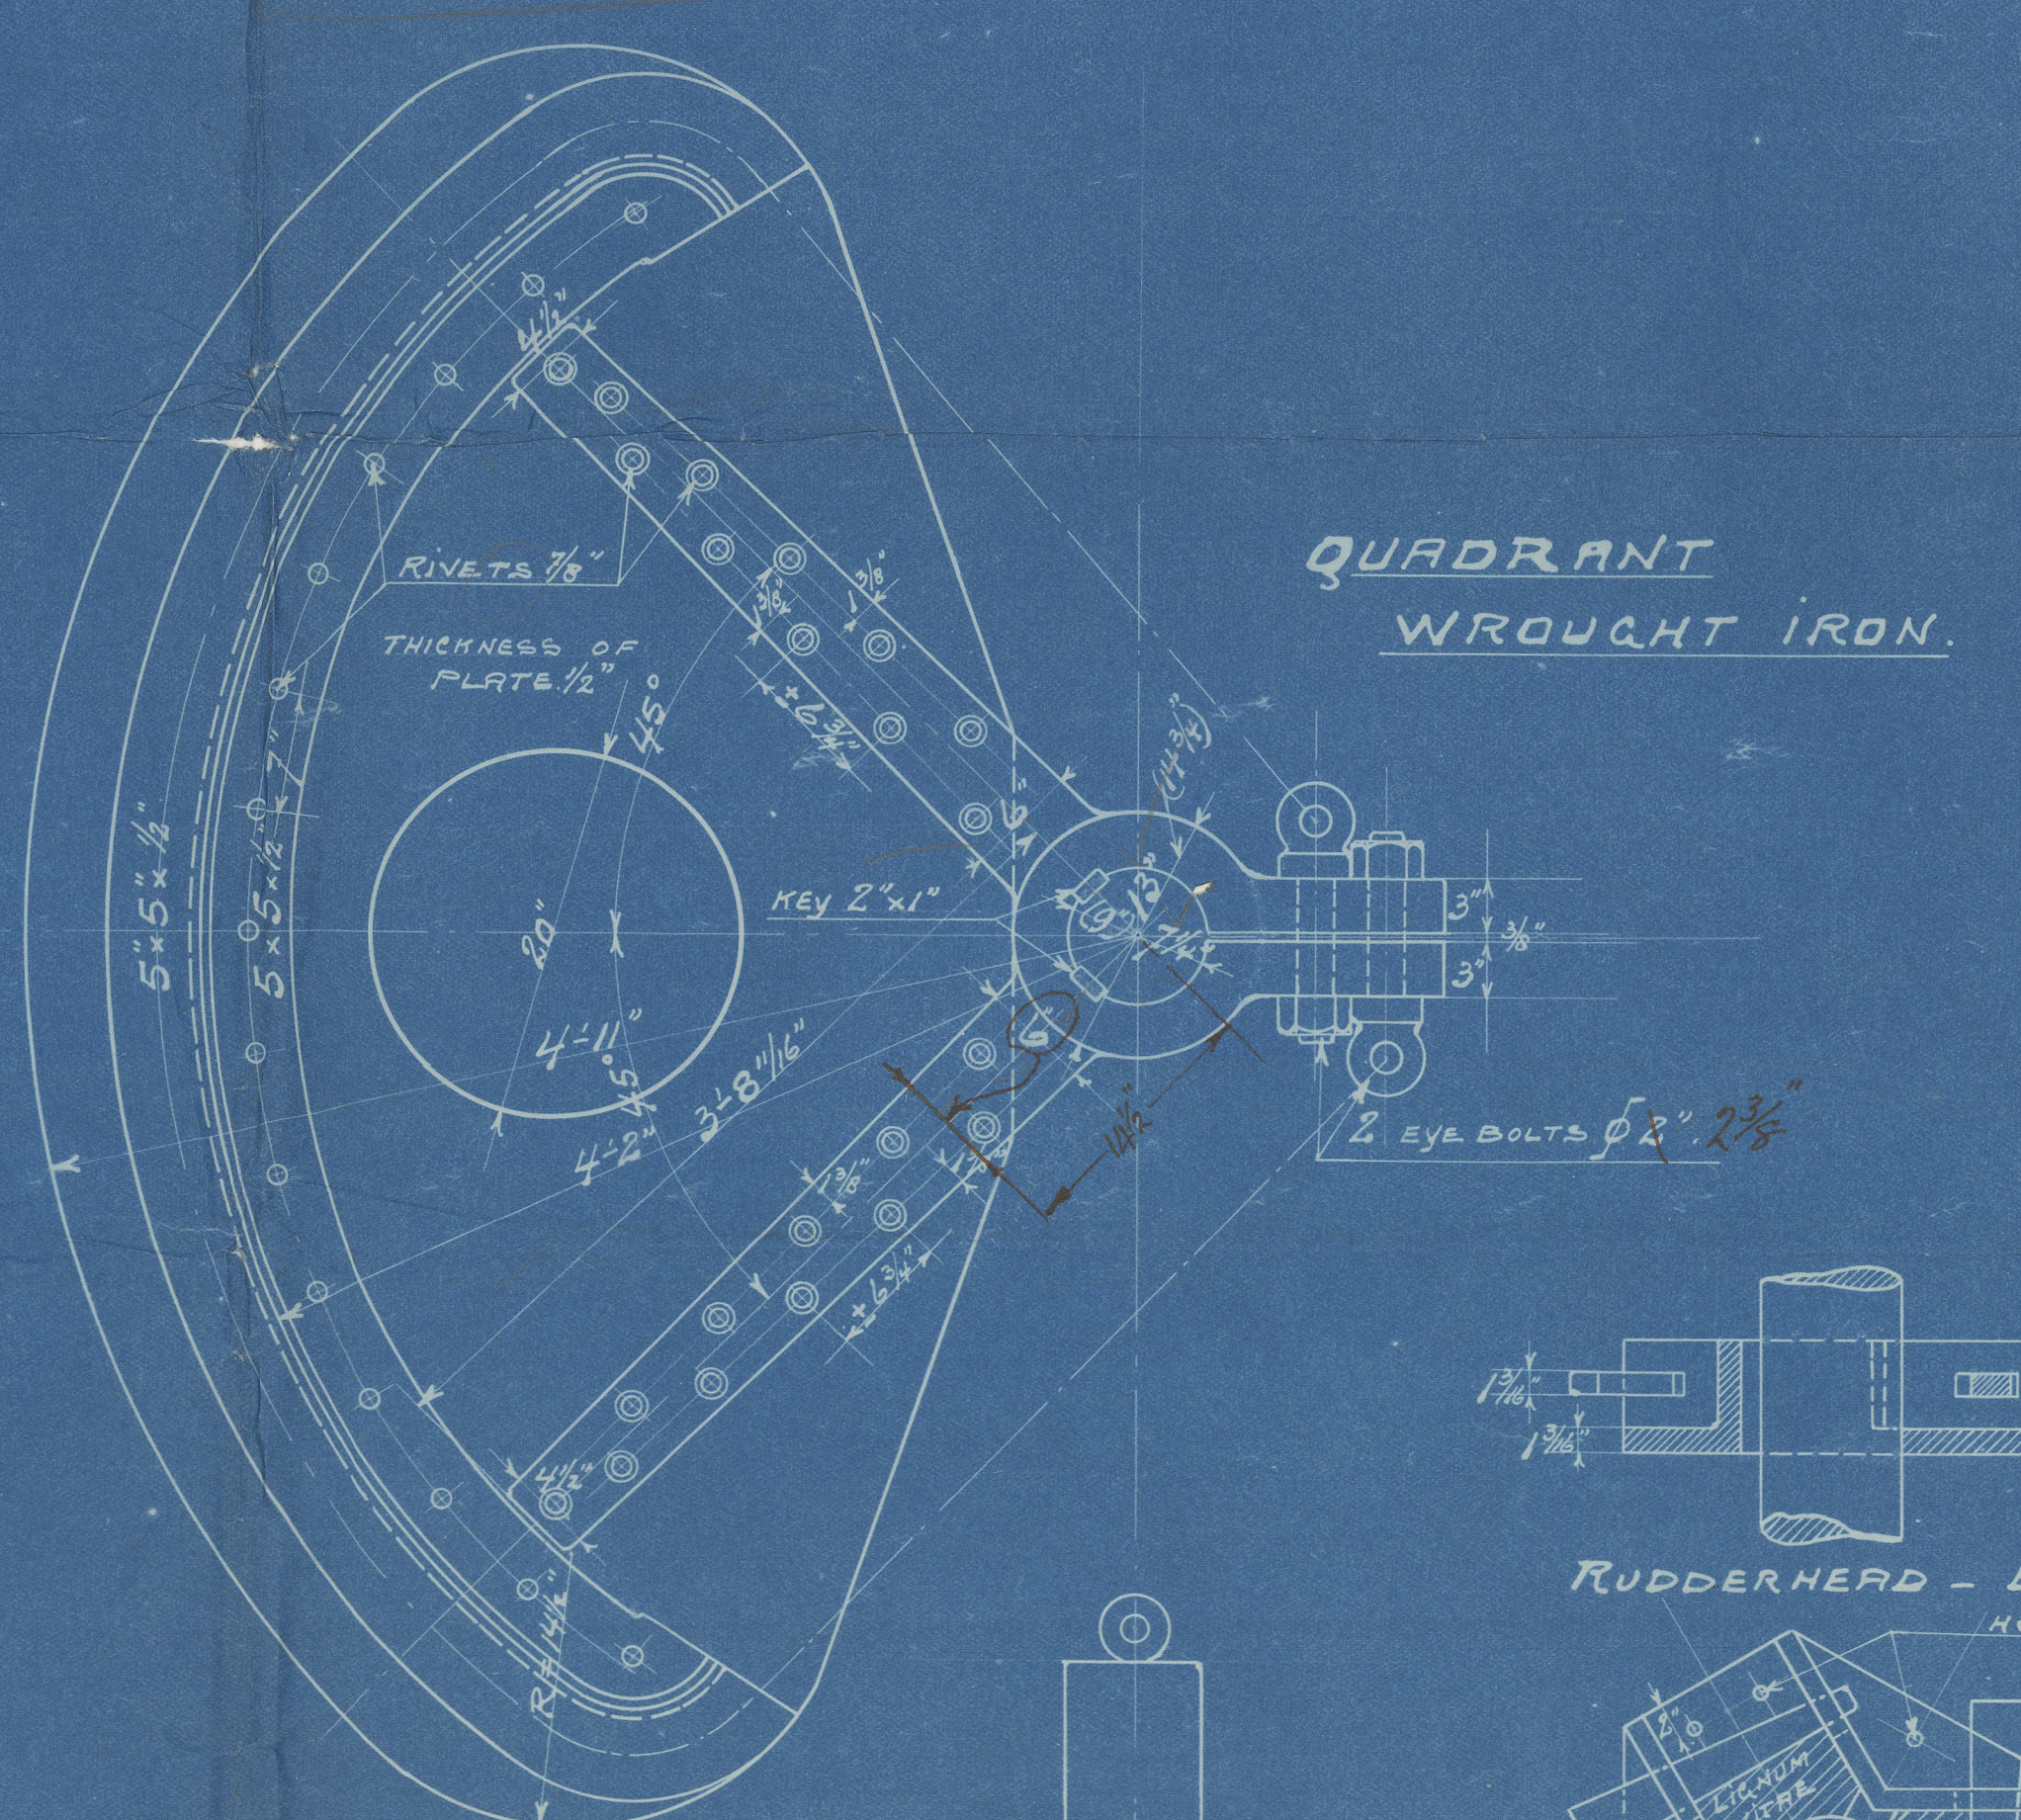
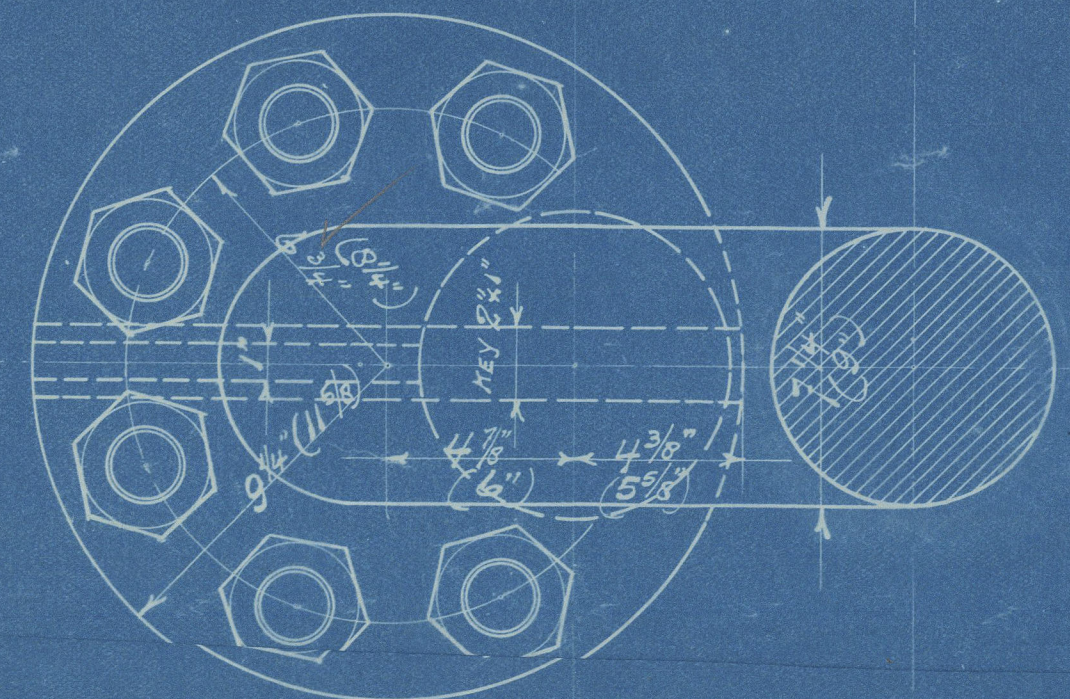


REMARK DIMENSIONS BETWEEN () ARE FOR ICE STRENGTHENING.

Hand Bars to be fitted or spar tiller supplied. Double ended.

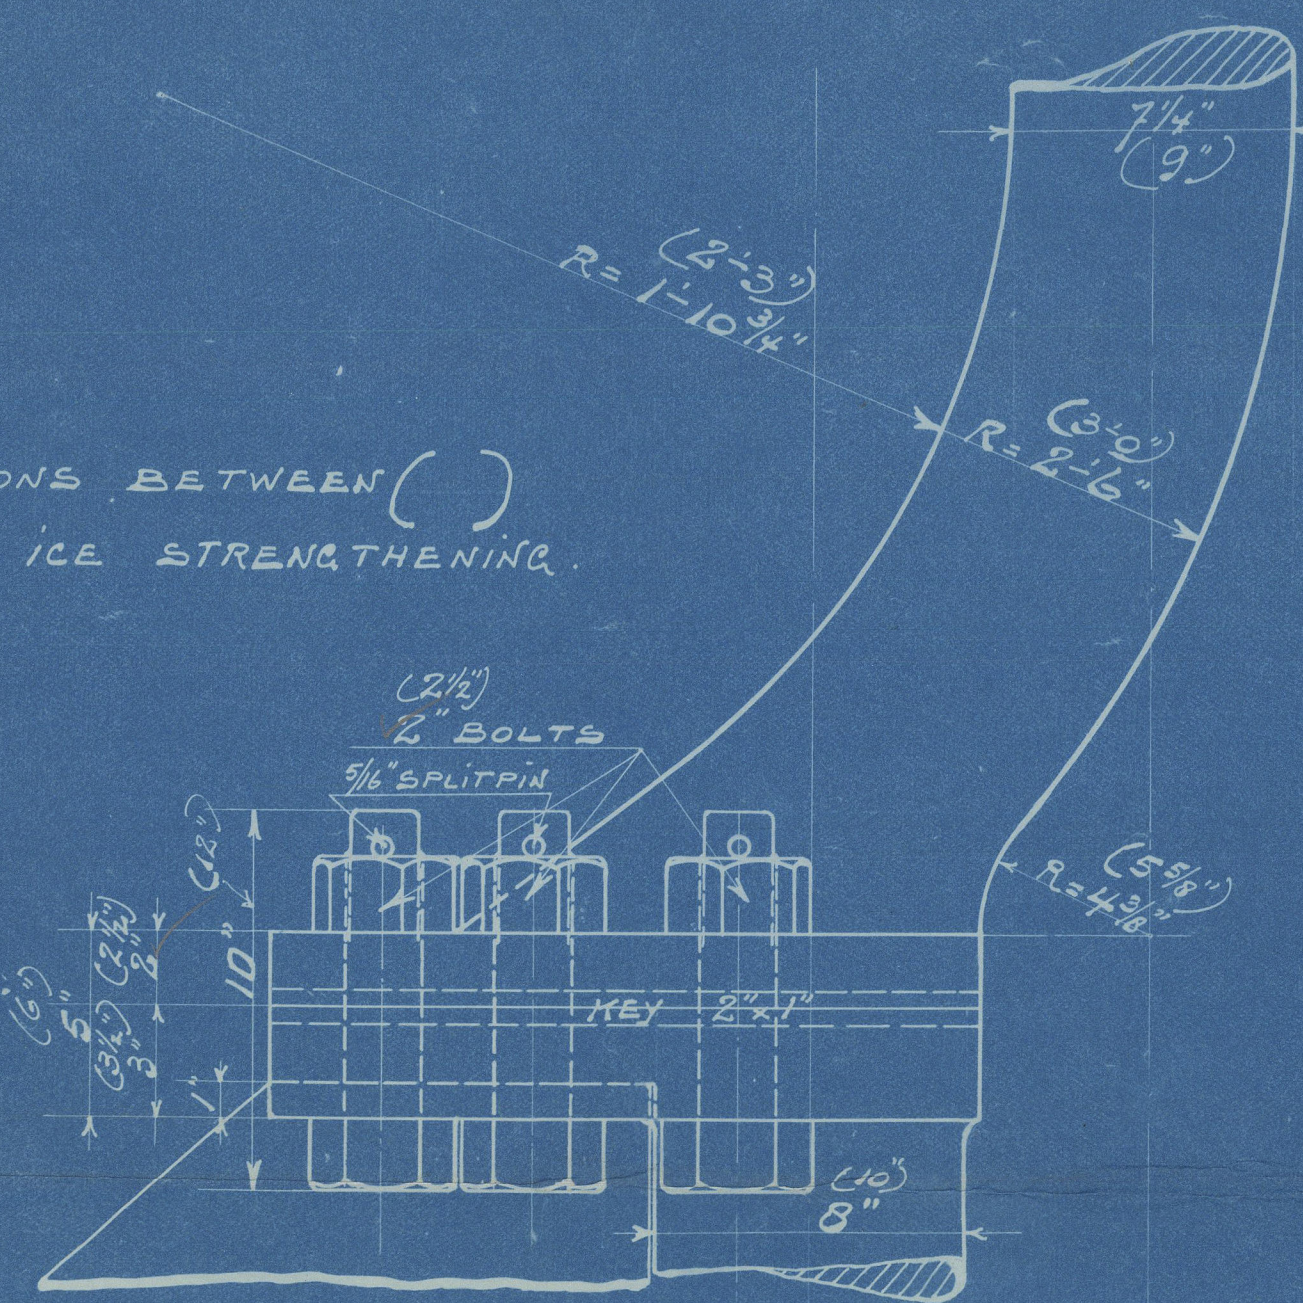

NAAMLOOZE VENNOOTSCHAP
MACHINEBANK EN SCHEEPSWERF
VAN P. SMIT JR.
ROTTERDAM.

S.S. B.N. 316-317.
STERNFRAME CAST STEEL
OR WROUGHT IRON
AND RUDDER.
SCALE 1=10 & 1=5.

SPEED OF VESSEL 10 1/4 KNOTS PER HOUR.

Amey 23.3.20.

316.30
KL 108
10/3/1920. K.W.

Van P. Smit Jr.
316-7.

Stern Frames & Rudder

~~316-7~~

S.S. "Argo"
Reg. 11690.

PLANS TRANSFERRED
TO SISTER VESSEL

Pjarnu

003252-003262-0158



© 2020

Lloyd's Register
Foundation