

"Ocean" Type Ship.


Where built:- Richmond

5/5 "CLAN KENNEDY" ex "Ocean Viscount"

Date of Build:- 1942/6

1. Hull 19109- 6/50. Deflections as noted under.  
6" x 3" x 1/2" Ls fitted P & S at 6' 9", 16' 4" 19' from Q in No. 3 D.B. tank.  
2. Sls 80978 - 10/53 'A' plates 6-12 p & s set up more 7/8

~ PART BOTTOM SHELL EXPANSION. ~

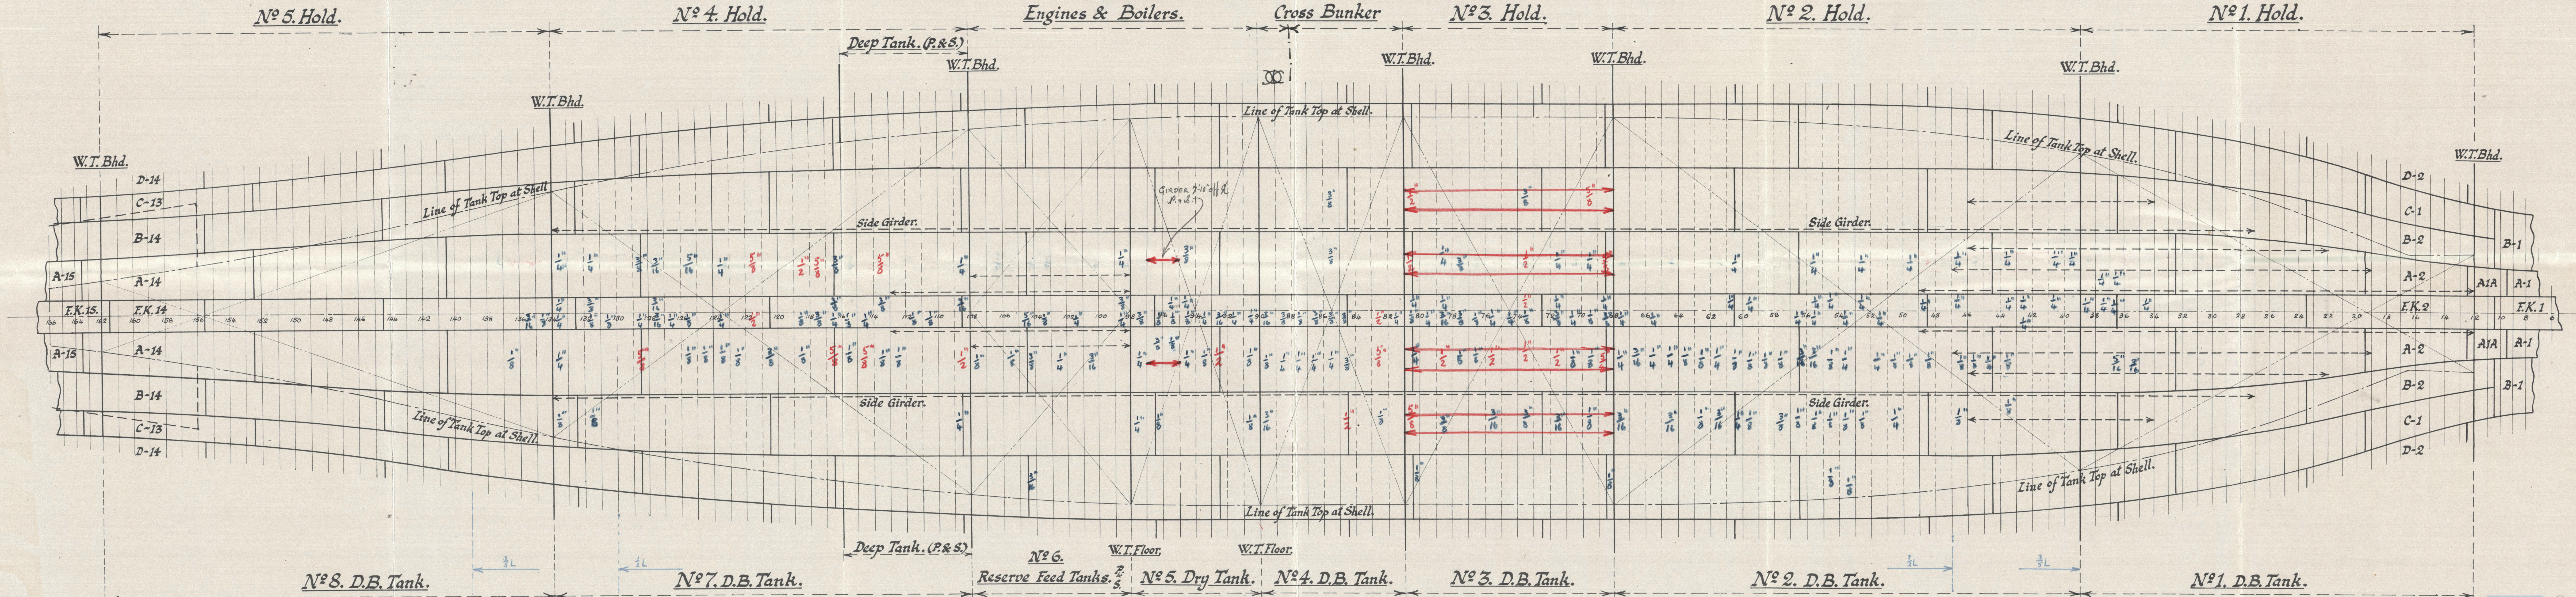

~ Scale 1/8" = 1Foot. ~

R.23

OCEAN VISCOUNT

M.H.

"CLAN KENNEDY"



© 2020

Lloyd's Register  
Foundation

003290-003297-0031