
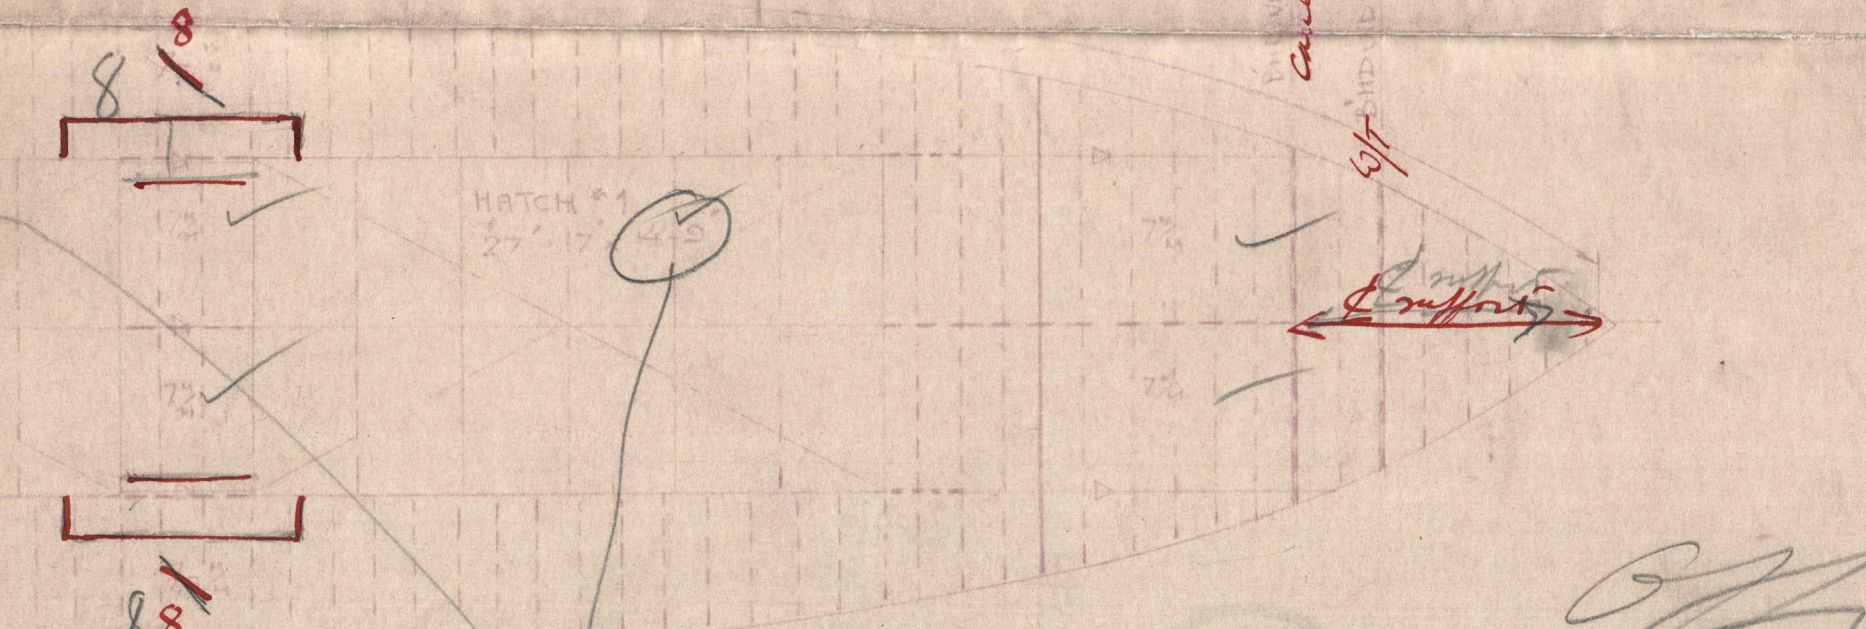
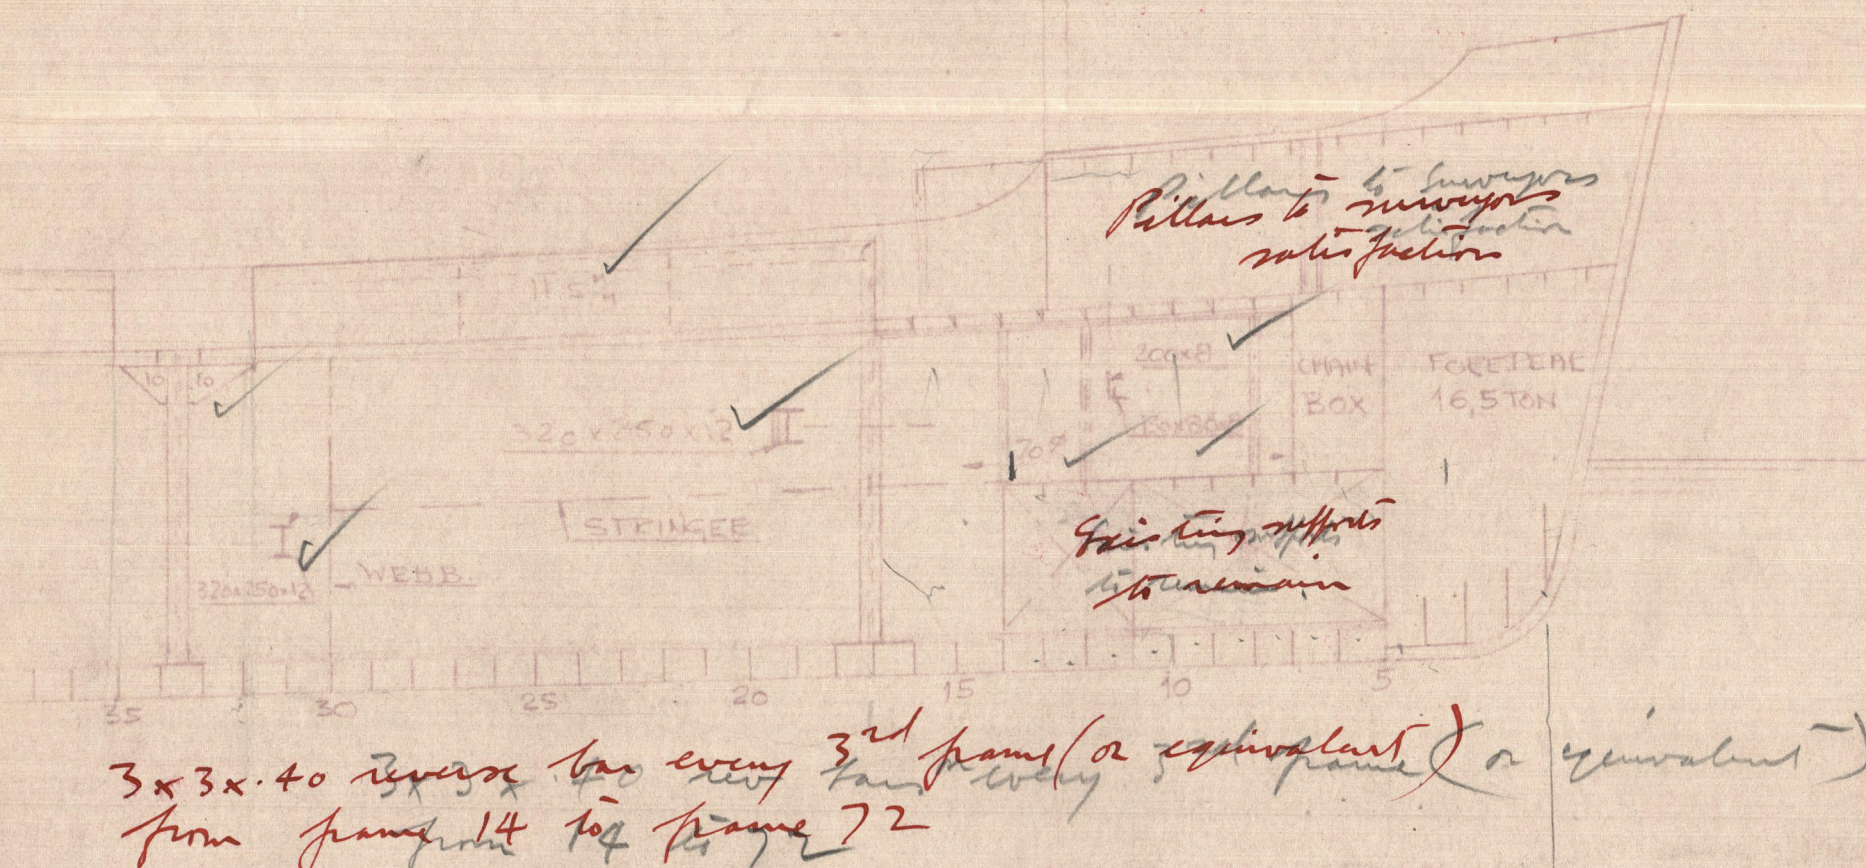
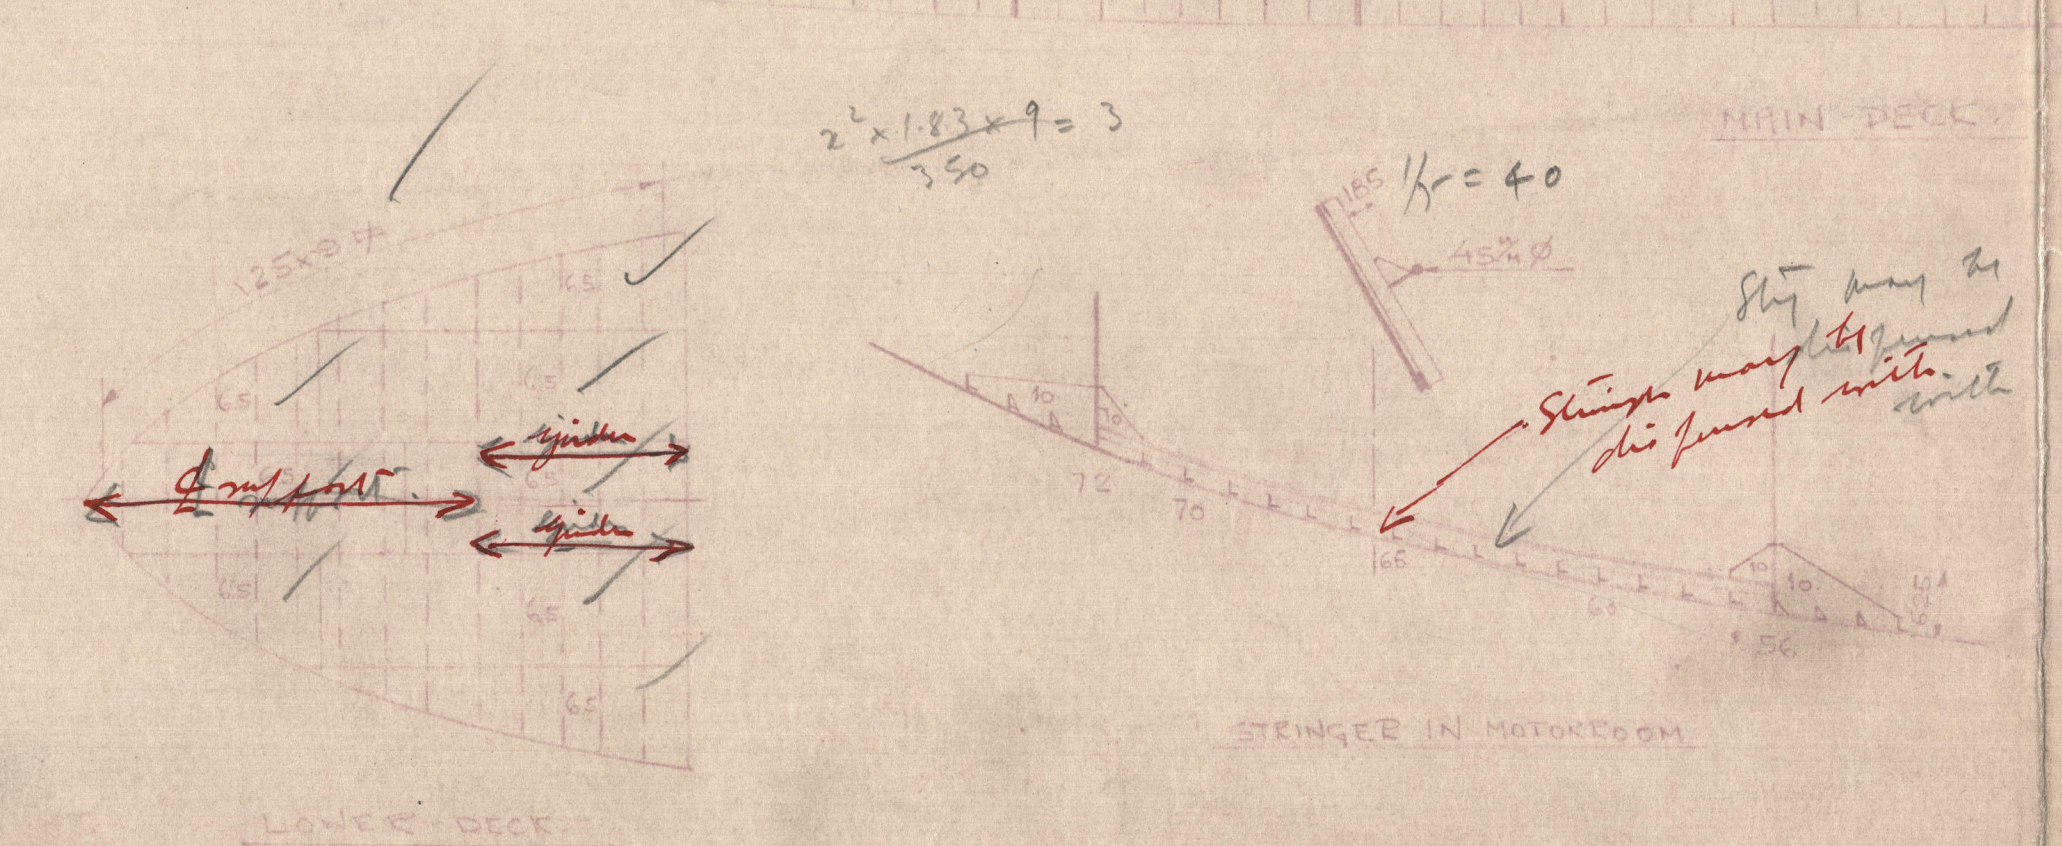
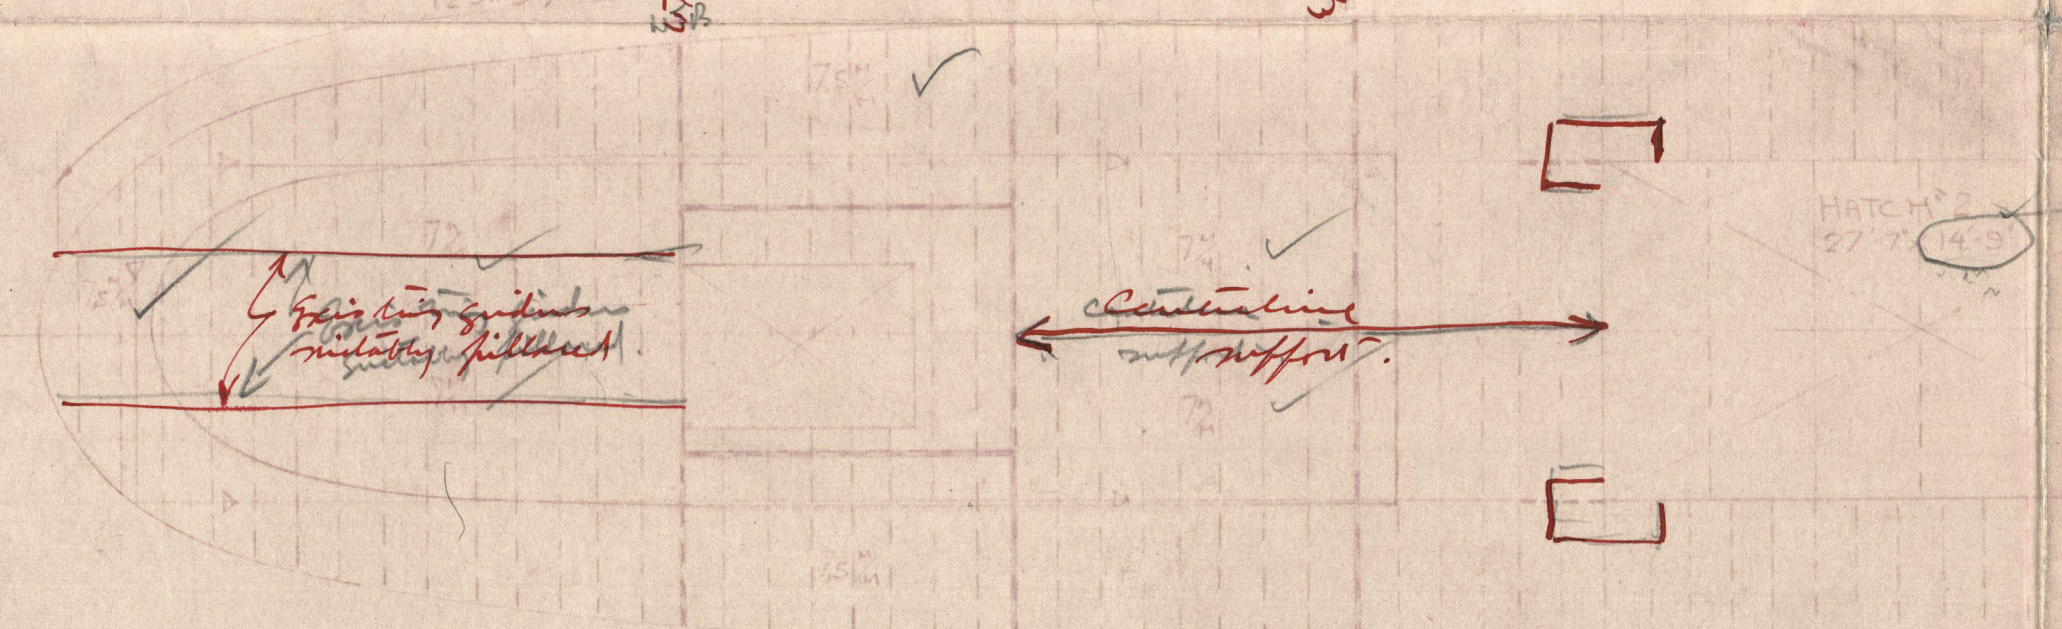


With tips as shown not frame regd every 5th
 Str regd 30-47
 Wels $\frac{1}{8} = \frac{15\frac{1}{2} \times 13\frac{1}{2} \times 12}{8 \times 4\frac{3}{4}} = 66$

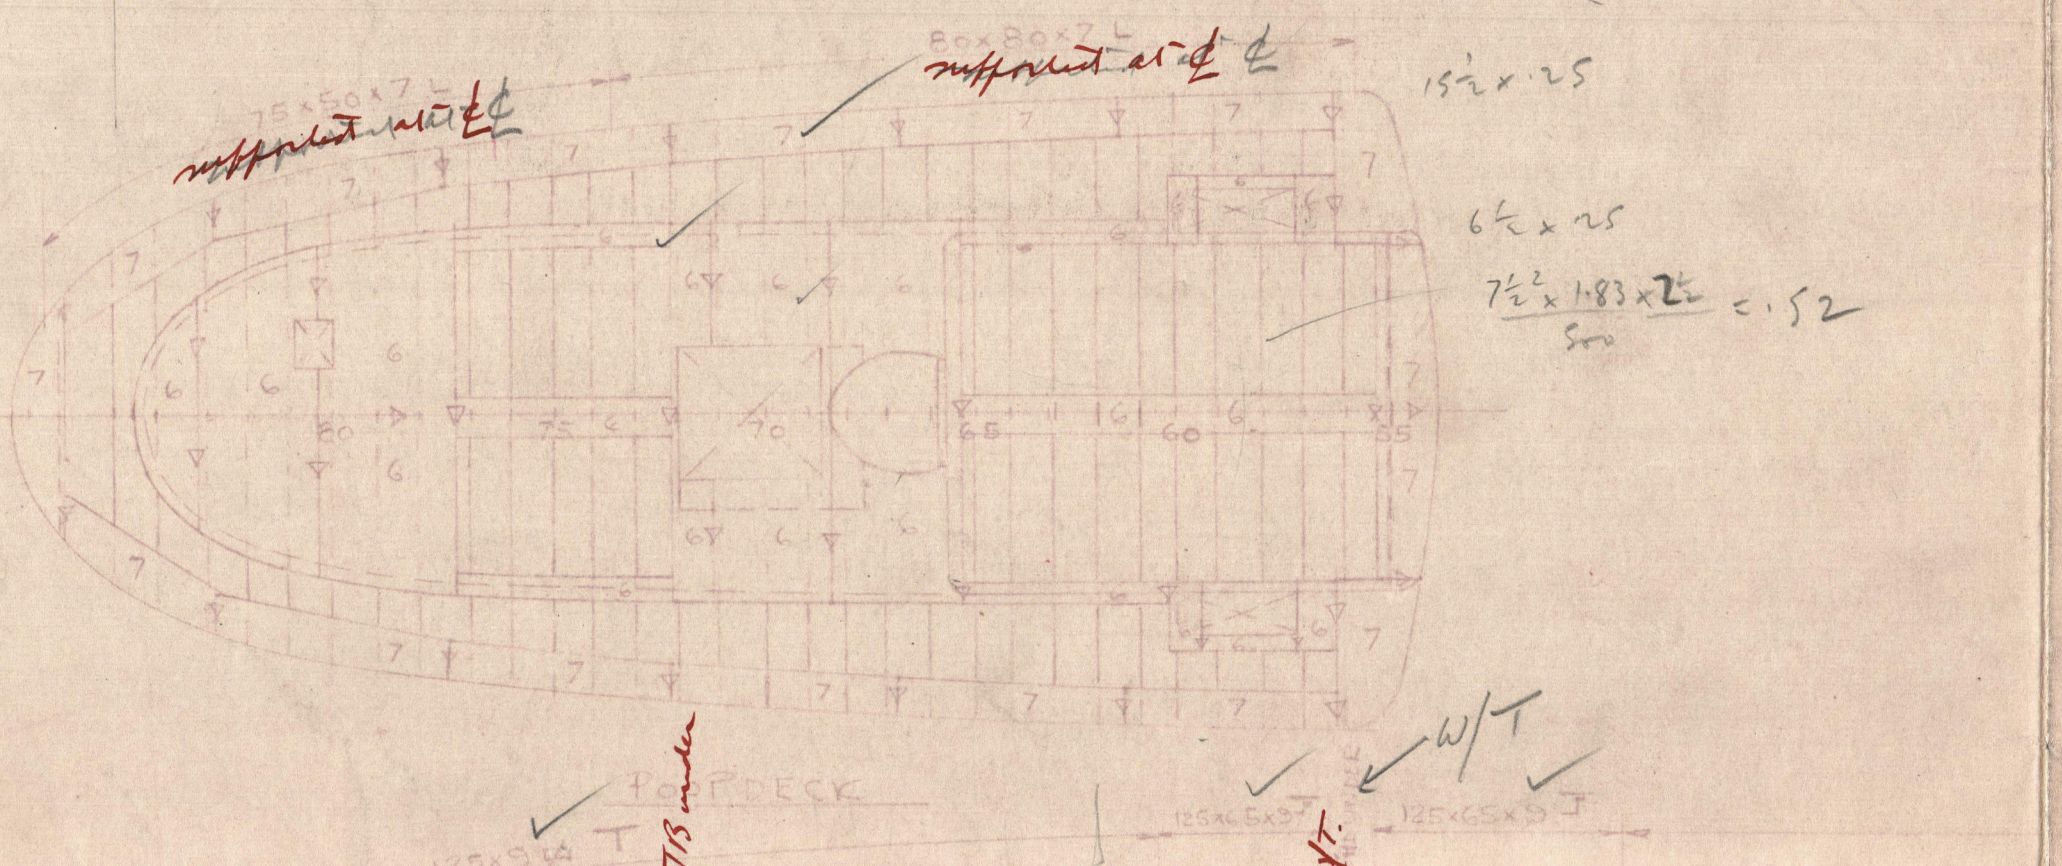

Shown 4000 mm
on tetraphane

$$\frac{x^2 \times 6 \frac{1}{2} \times 9}{35 \times 4 \frac{1}{4}} = 40$$

over of Jan 10-6'

TuROY ex
IRONBOUND

$$\begin{aligned} & \frac{5.25 \times 13.5 \times 5 + 13.79 \times 10.25 \times 5}{100} = 10.62 \\ & \frac{5.75 \times 13.5 \times 5 + 27.58 \times 10.25 \times 5}{100} = 17.98 \\ & \frac{287 \times 13.5 \times 5 + 13.79 \times 10.25 \times 5}{100} = 9.03 \end{aligned}$$

Wm. H. H. H.

22-10-47

SECTION END PLANS © 2020

DATUM. 1307 RITAY
 SKALA. 1:100 GODAN
 Lloyd's Register
 Foundation

003290-003297-0092

"TUROY" ★

KORSO *

Profile & decks

RECORDS DEPT.,
LONDON



003290-003291-0092



© 2020

Lloyd's Register
Foundation