

AS FINNBODA VARF
STOCKHOLM

Steel Masts for "1/2" KORSÖ

SCRS No. 3-1955

AVD.: XF

STÅLMÄSTER TILL M/S KORSÖ

SCALE 1:50


DATO: 210155

UTF. AV PL

GRANSK.

Most drillings as per Plan D2803 of the Rules

Office

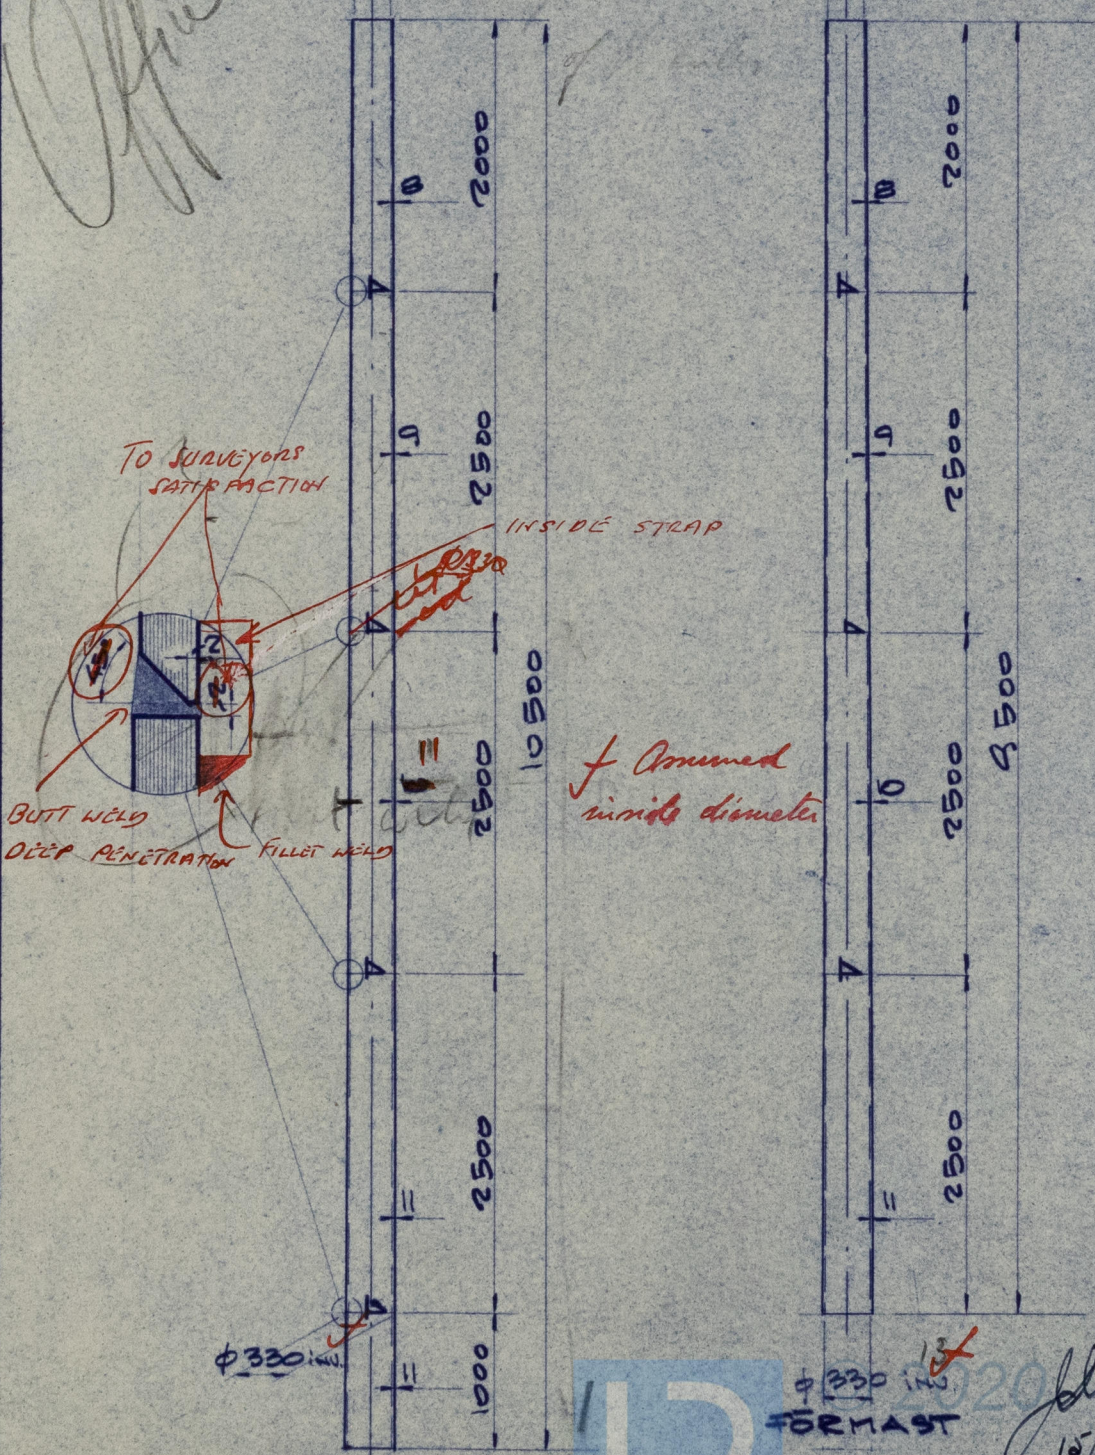

AFTERMAST
aft mast

FOREMAST

Fore mast

003290-003297-0110