AB FINNBODA VARF
STOCKHOLM

AVD.: XF

DATO: 25 01 55

FÖRMAST

M/S "KORSÖ"

Ritn No.	5-1955
SKALA	1:100
UTF. AV	P.L
GRANSK.	

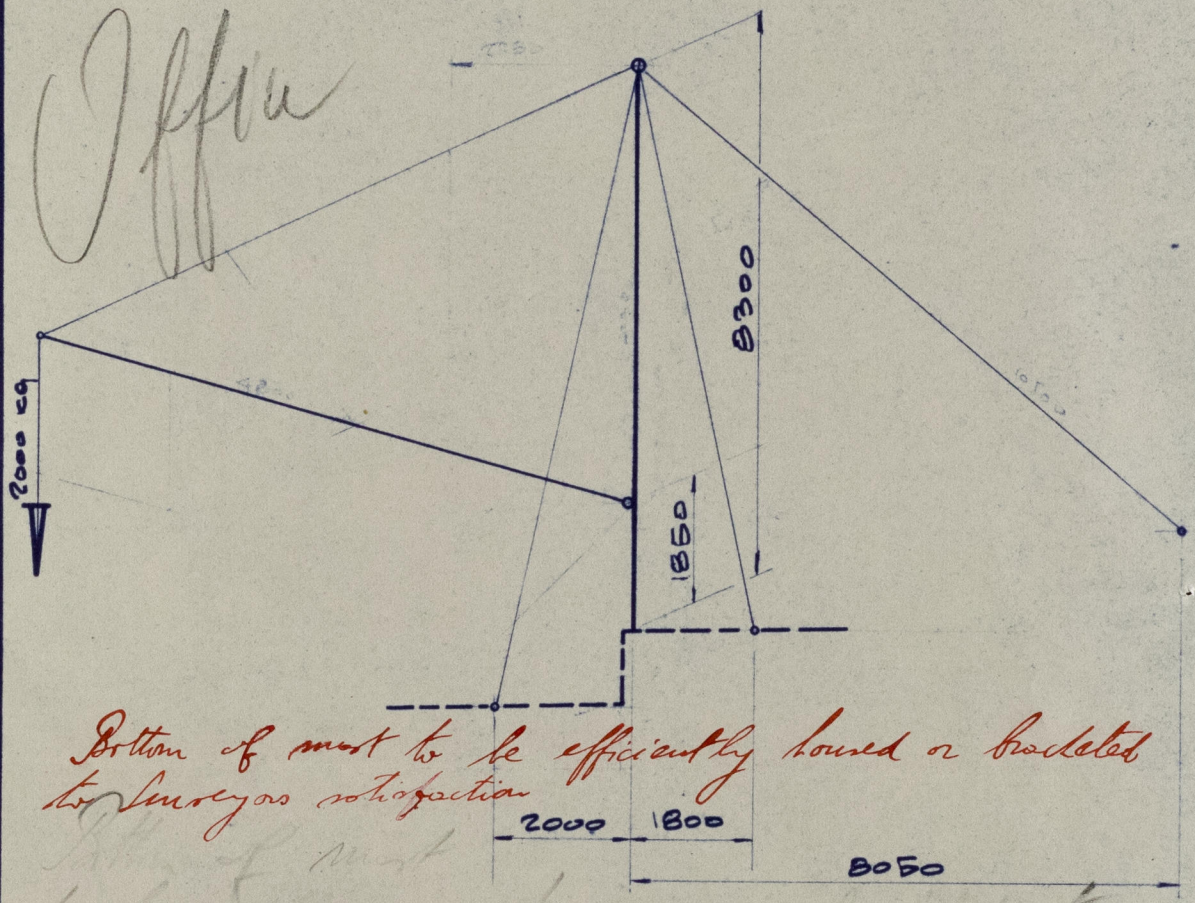

Bottom of mast to be efficiently housed or bracketed to Surveyors satisfaction

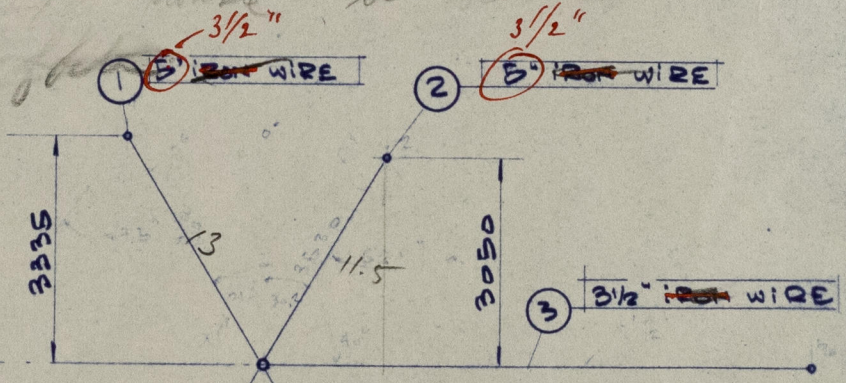

Shrouds to be of 6/12 or 6/19 construction ~~galvanized~~ steel wire rope.

15/3/55

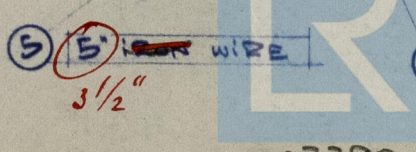

© 2020 Lloyd's Register Foundation

003290-003297-011