

DATE: 2501 55

Exiss No. 6-1955



SCALA 1:100

UTF. AV	D. L.
---------	-------

GRANSK.

AKTER HAST

M/S "KORSO"

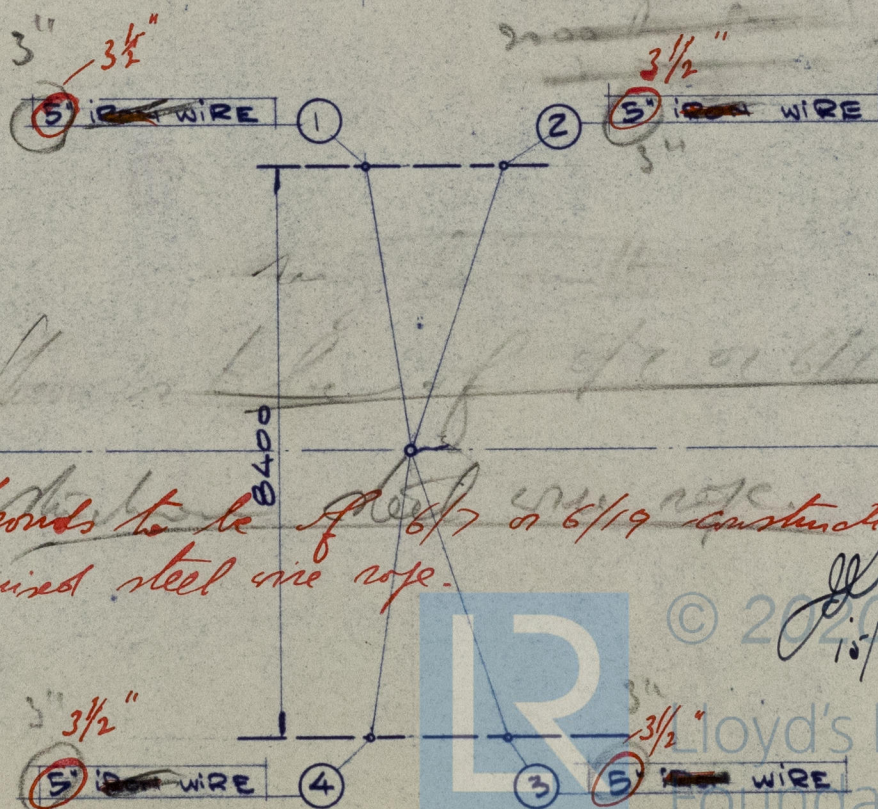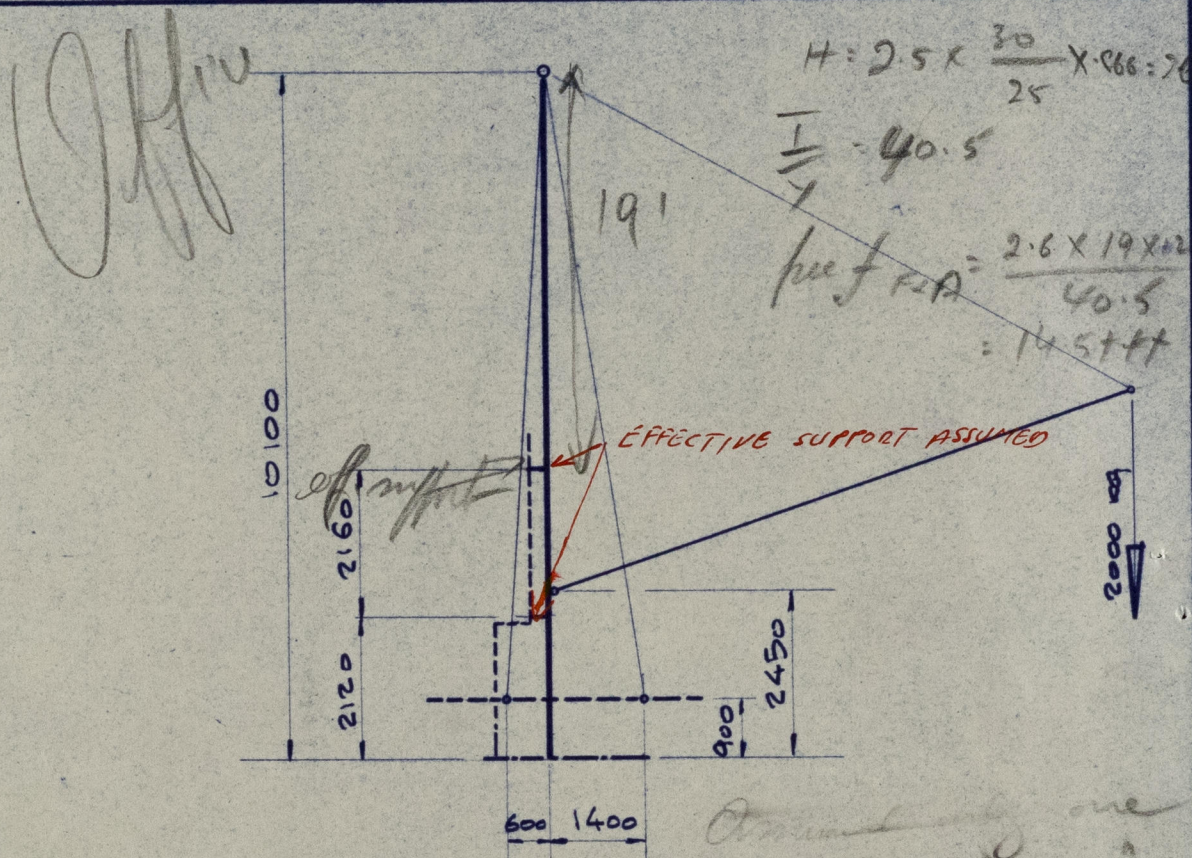

34
 Should be of 6/7 or 6/19 construction
 galvanized steel wire rope. *ll*

15/3/55