





Messrs John Readhead & Sons

N<sup>os</sup> 460 and ~~462~~


SHIP SECTION



WED MAR. 24 1920

S.S. "RONDA" KRA GUJEVAC.

NEWCASTLE ON TYNE. \*

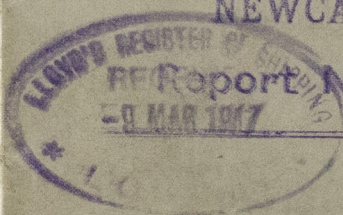

© 2020

Lloyd's Register  
Foundation

003290-003297-0203