


—Dimensions as per Rule.

- CLASS 100 A.I. ☒ -

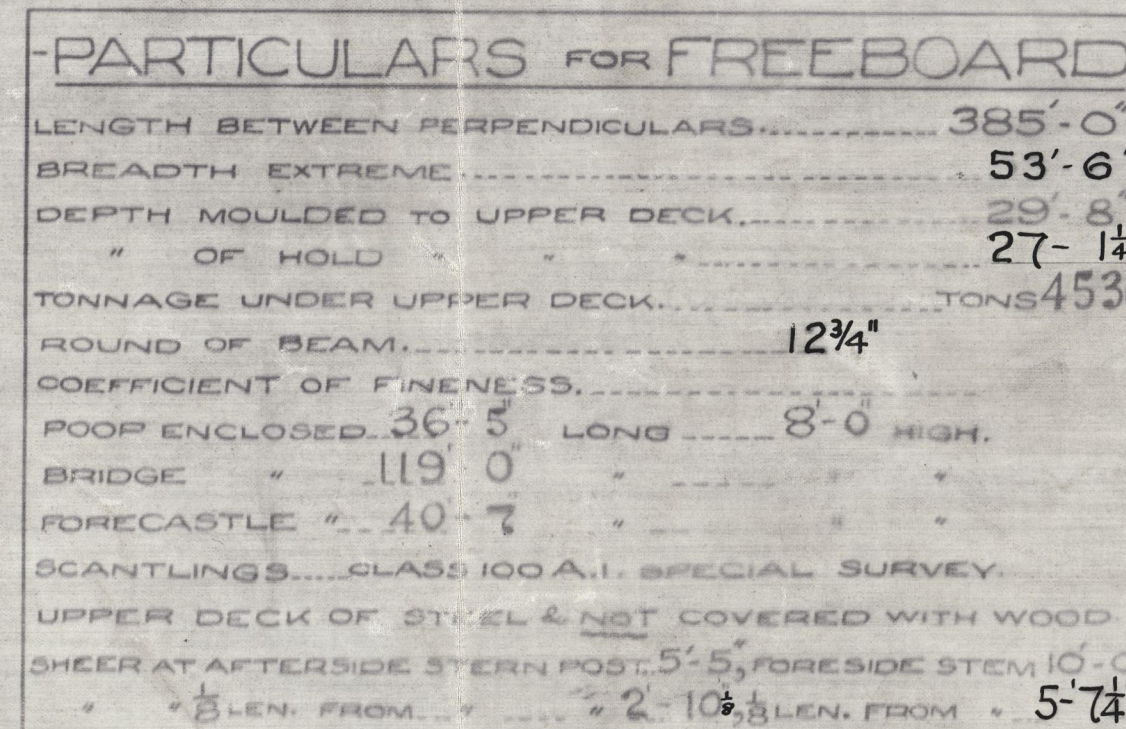


ITEMS IN BLUE REPRESENT ADDITIONS  
REQUIRED PER OWNERS SPECIFICATION.

— JOHN READHEAD & SONS, LD.  
SHIPBUILDERS & S.  
SOUTH SHIELDS.





003290-003297-0204

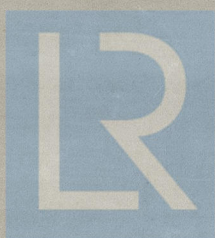

© 2020

Lloyd's Register  
Foundation



Messrs John Readhead & Co

N<sup>os</sup> 460 and 462

Profile and deck Plans



WED. MAR. 24 1920.

S.S. "RONDA" KRAG UTEVAC  
NEWCASTLE ON TYNE. \*

Report No. 73026.

now "Joan Topic"



© 2020

Lloyd's Register  
Foundation

003290-003290-0204