

Lloyd's Register of Shipping.


SURVEYS FOR FREEBOARD.

(CONDITIONS OF ASSIGNMENT.)

GLASGOW REPORT No. 67758.

Ship's Name **"NERITINA"** Port of Survey **GLASGOW.**
 Official Number **169634** Surveyor's Signature *H. J. Pyle*
 Nationality and Port of Registry **BRITISH - LONDON.** Date of Survey **WHILST BUILDING.**

Disposition and dimensions of superstructures, trunks, deckhouses and machinery casings to be inserted in the diagrams and tabular statement: -

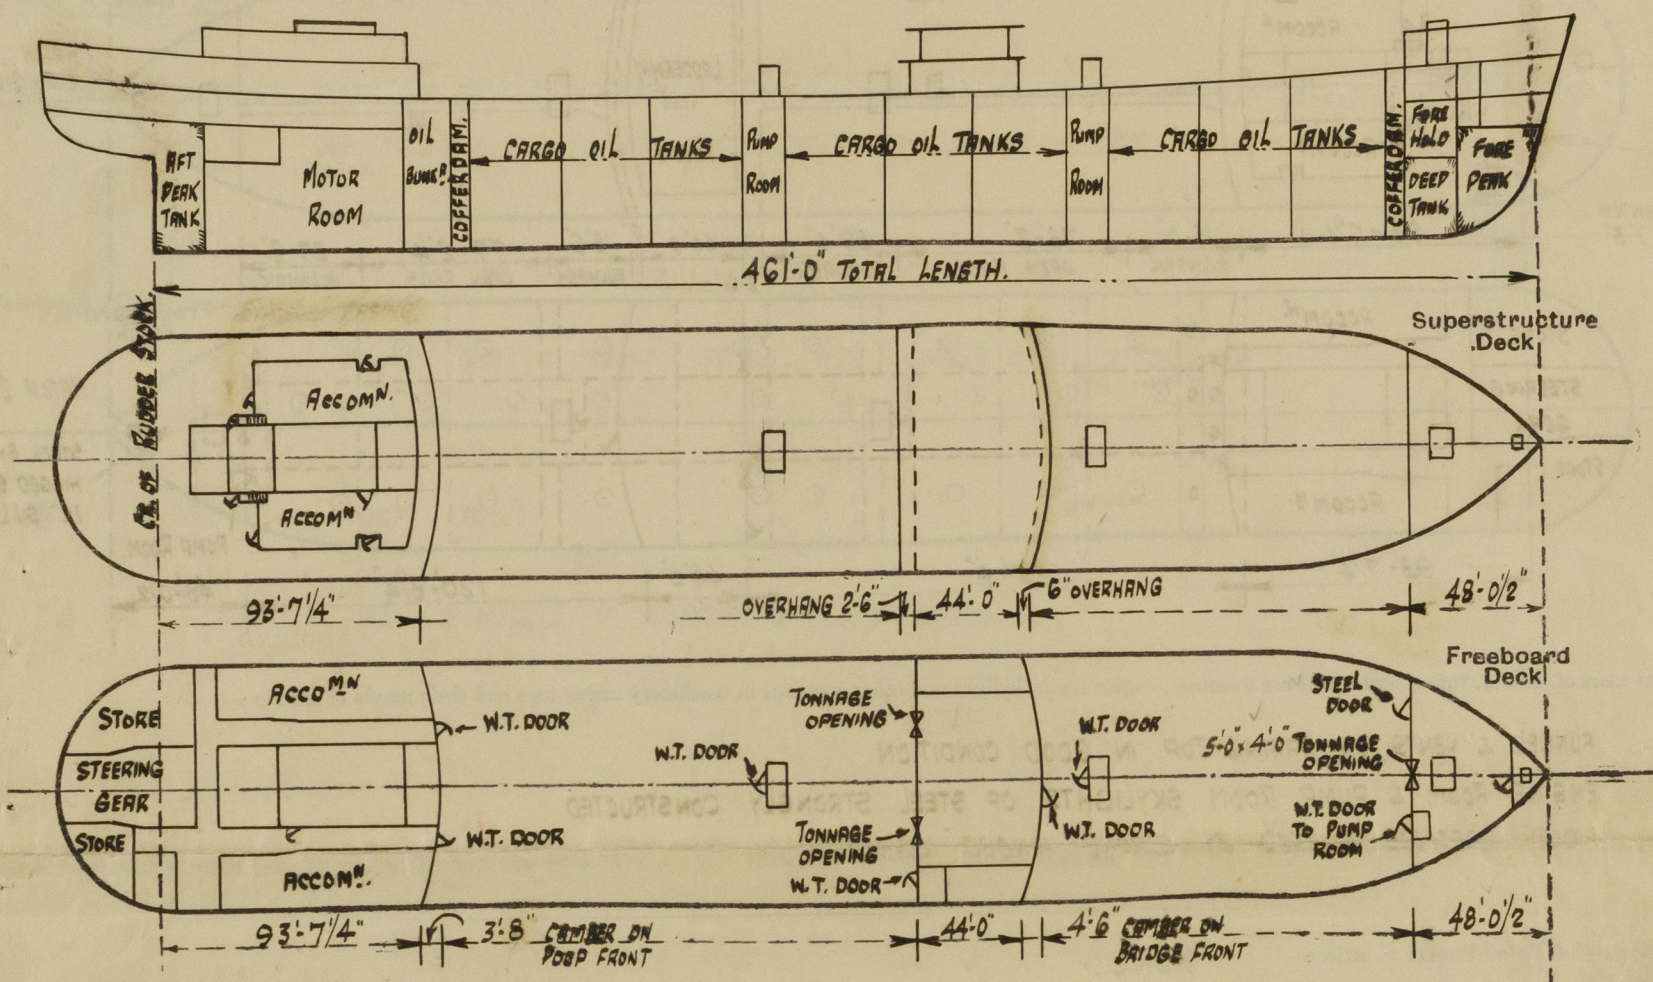

Particulars of Superstructures, Trunks, Casings, Deckhouses.

	Coaming	Plating	Stiffeners	Spacing	End Attachments of Stiffeners	Size of Openings	Height of Sills	Height of Casings
Poop Bulkhead		44"	8 x 4 x .50 A WELDED TOE ON.	24" - 30"	WELDED TOP AND BOTTOM	2 @ 5'-0" x 2'-6"	18"	7'-6"
Raised Quarter Deck Bulkhead ...								
Bridge, After Bulkhead		30"	5 x 3/16 FLATS WELDED EDGE ON & 6 x 3/2 x 1/16 BA.	26" - 29"	WELDED TOP AND BOTTOM	2 @ 5'-3" x 3'-0 1/2"	18"	7'-6"
Bridge, Forward Bulkhead		44"	8 x 4 x .50 A, WELD TOE ON AND 9 x 3/2 x 1/16 BA	26" - 30"	WELDED TOP AND BOTTOM	1 @ 5'-0" x 2'-6"	18"	7'-6"
Forecastle Bulkhead		30"	5 x 3/16 FLATS WELDED EDGE ON	24" - 27 1/2"	NONE	1 @ 5'-0" x 4'-0"	18"	7'-6"
Trunk, Aft								
2 PUMP ROOMS.								
Trunk, Forward		40"	5 x 3/8 FLATS. WELDED EDGE ON	26" - 34"	WELDED TOP AND BOTTOM.	1 @ 4'-9" x 2'-6"	18"	7'-6"
Exposed Machinery Casings on Freeboard or Raised Quarter Decks ...								
Exposed Machinery Casings on Superstructure Decks								
Machinery Casings within Superstructures not fitted with Class I Closing Appliances								
Deckhouses on Flush Deck Ships ...								

PROTECTED BY STEEL DECKHOUSE AND COMPANIONWAYS.

Particulars of Closing Appliances (state if capable of being manipulated from both sides).

Poop Bulkhead	2 HINGED W.T. DOORS MANIPULATED FROM BOTH SIDES.
Raised Quarter Deck Bulkhead ...	(CLOSED FROM BOTH SIDES)
Bridge, After Bulkhead	2 TONNAGE OPENINGS CLOSED BY PORTABLE PLATES SECURED BY HOOK BOLTS NOT PASSING THRO' BHD, 1 HINGED W.T. DOOR
Bridge, Forward Bulkhead	1 HINGED W.T. DOOR CLOSED FROM BOTH SIDES.
Forecastle Bulkhead	1 TONNAGE OPENING CLOSED BY PORTABLE PLATES SECURED BY HOOK BOLTS NOT PASSING THRO' BHD, 1 HINGED W.T. DOOR AND
Exposed Machinery Casings on Freeboard or Raised Quarter Decks ...	(1 HINGED STEEL DOOR CLOSED FROM BOTH SIDES.)
Exposed Machinery Casings on Superstructure Decks	
Machinery Casings within Superstructures not fitted with Class I Closing Appliances	
MAIN PUMP ROOMS.	
Deckhouses on Flush Deck Ships ...	2 HINGED W.T. DOORS (ONE EACH HOUSE) CLOSED FROM BOTH SIDES.

PARTICULARS OF PROTECTION TO OPENINGS, ETC.

HATCHWAYS ON FREEBOARD AND SUPERSTRUCTURE DECKS.									
← FREEBOARD DECK. →					← SUPERSTRUCTURE DECK. →				
Description of Hatchway	27 OIL HATCHES	MANHOLES TO COFFERDAMS	MANHOLES TO OIL FUEL BUNKER	HATCH IN FORECASTLE	HATCH ON FORE DECK TO FORE HOLD.	HATCH ON FORE DECK	2 HATCHES ON POOP DECK	2 CIRCULAR HATCHES ON POOP DECK.	
Dimensions of Hatchway	4'-0" DIAB.	6 @ 23"x18"	2 @ 23"x18"	2'-6" x 2'-6"	8'-1" x 8'-1"	2'-6" x 2'-6"	3'-3" x 3'-3"	12" DIA.	
COAMINGS	Height above Deck ... 10" x 3/4" TH. Thickness ... Sides Stiffeners ... Ends Brackets, Stays ...	7" x 3/2" x .50" ANGLE WELDED TO DK. TO FORM 7" CHANNEL.		9 x 3/2 x .44 B.A.	30/2" .44" .44"	9" x 3/2" x .44" B.A.		9 x 3 x 7/16 B.A.	
HATCH BEAMS	Number ... Spacing ... Scantling and Sketch ...				HATCHWAY TRUNKED TO UPPER DK .32" PLATING WITH 3 x 2 1/2 x 5/16 B.A. STIFFERS. 24"				
FORE AND AFTERS	Number ... Spacing ... Unsupported Lengths Scantling* and Sketch ...				APART CARRIED UP HATCH COAMING.				
HATCH COVERS	Material ... Thickness ... How fitted ... Bearing Surface ...	STEEL PLATE .40" HINGED WITH TOGGLES	STEEL PLATES .50" BOLTED W.T. PITCH.	W.T. COVER STEEL .44" WITH TOGGLES	W.T. STEEL COVER .44" HINGED WITH 3-6 x 3/8 B.A. STIFFERS. ON COVER WITH TOGGLES 26" APART	W.T. STEEL COVER .44" HINGED WITH TOGGLES 15" - 22" APART.		FLANGED W.T. STEEL COVER .38" SECURED BY SPINDLE, STRONG BACK & BUTTERFLY ON UNDERSIDE.	
Spacing of Cleats		20		16" - 22"					
Number of Tarpaulins		APART		APART.					
<p>*Are wood fore and afters steel shod at all bearing surfaces ? Are battens and wedges efficient and in good condition ? Are tarpaulins in good condition and in accordance with rule requirements ? Are lashings provided in accordance with rule requirements ?</p> <p>✓</p>									

Particulars of any special features :—

Endorsement at first survey and at surveys for renewal of Certificate :—

The fittings and appliances are in accordance with the particulars shown on this form (or as now modified) and are in good condition.



© 2020

Lloyd's Register Foundation