




27 OCT. 1923

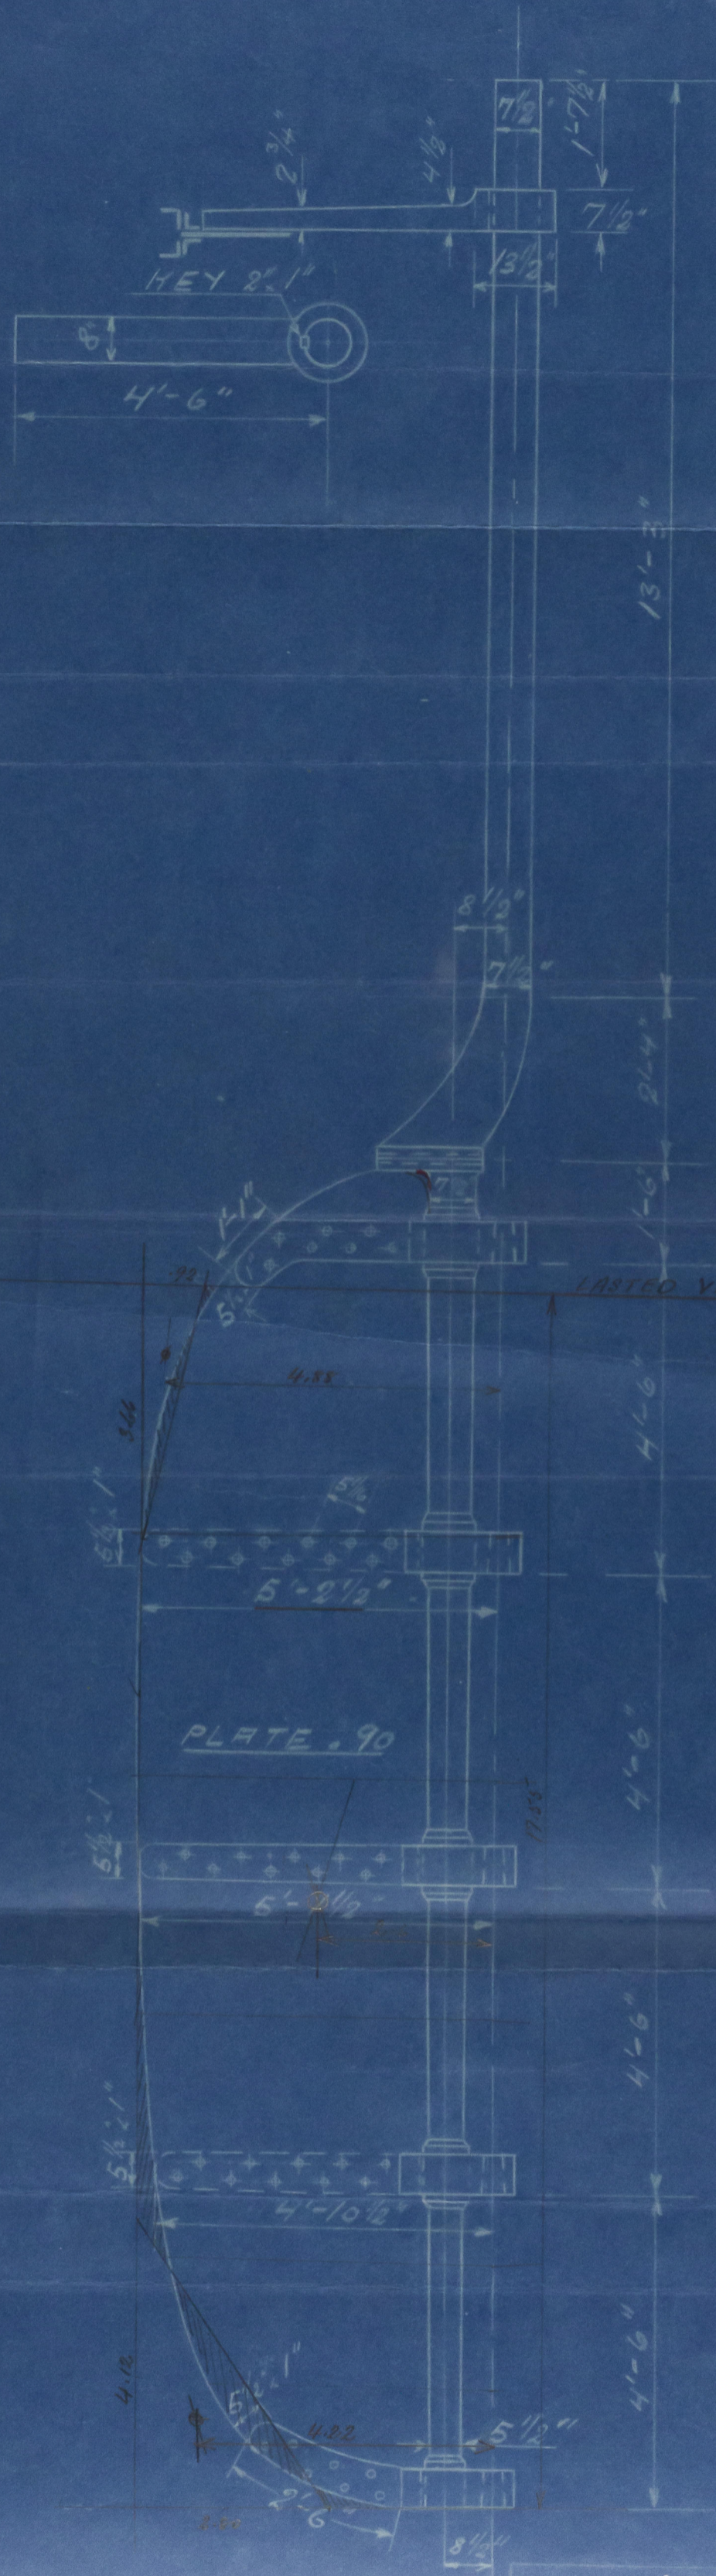

*Approved*  
*26 Oct 1923*  
*of original area of 91.3 sq ft*  
*found to be 10.4 sq ft*

AKTIESELSKABET AALBORG SKIBSVÆRFT SKIBS-TEGNESTUEN		
<u>RUDDER.</u>		
TEGNET AF <i>P. SENG.</i>	SKALA $\frac{1}{2}'' = 1'$	TEGNING NR.
REVIDERET AF <i>[Signature]</i>	DATO <i>18-10-23</i>	<i>10300.</i>
ARKIV:	NR. <b>24.</b>	



© 2020  
Lloyd's Register  
Foundation

603321-003327-0034

20

Ludder Glan.

Akt. Aalborg, Skibs.

N<sup>o</sup> 28.

Reference.

$\frac{2}{3}$  "P. MADSEN"



© 2020

Lloyd's Register  
Foundation

003321-003327-0034


bag.

Aalborg N<sup>o</sup> 27

Rudder Plan.

S/S P. MADSEN.

N<sup>o</sup> 20

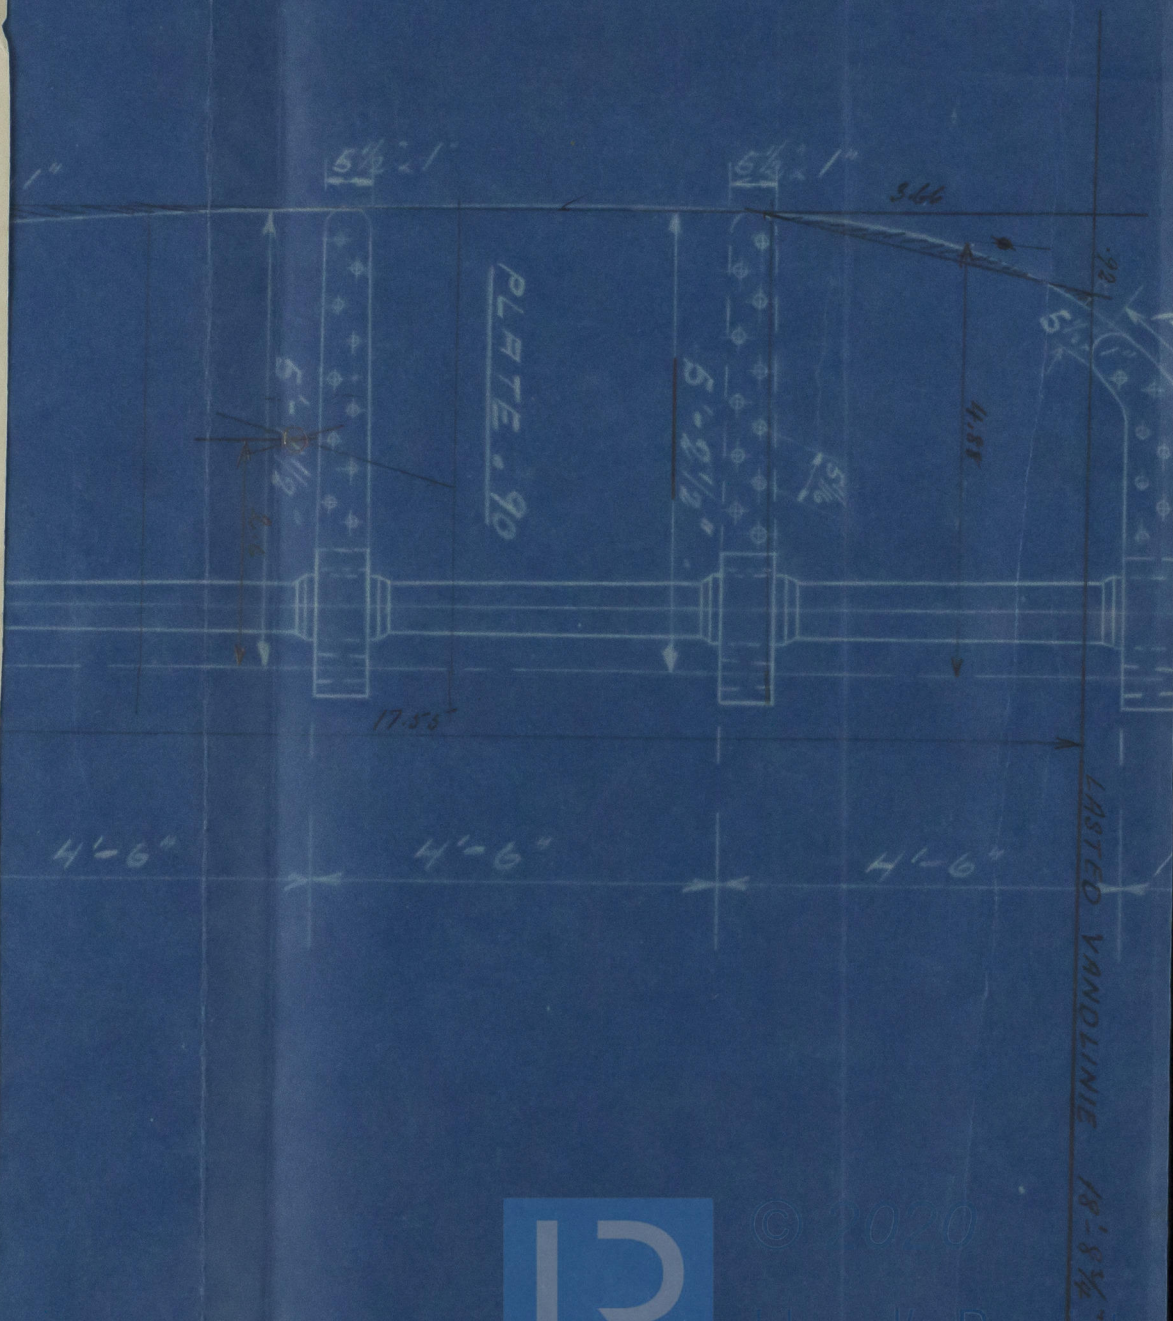

© 2020

Lloyd's Register  
Foundation