



BRODEKSLUGE NR. 2.

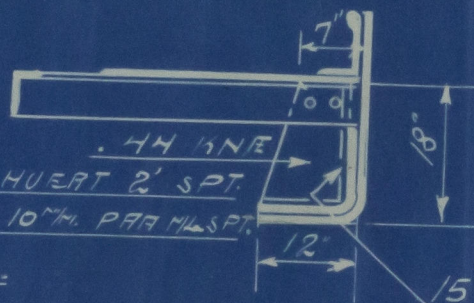


HOVEDDEKSLUGE NR. 2

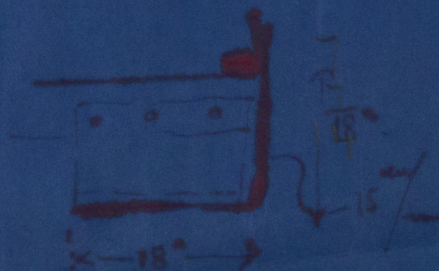

Alternative Recommendation

26 JULY 1923

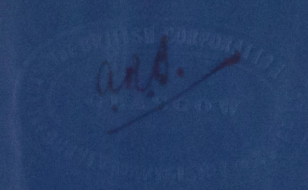

Handwritten signature and date: 17/7-23

SKITSE AF BRO-OG HOVEDDEKSLUGER NR. 2

TEGNER  
REVISOR  
KONTROLLER

P.BANG  
C. JENSEN

14-7-23. 11/86.

21 & 24.



650

60

How.

Aalborg

21 + 34

Strengthening of  
No 2 Hatch

24. 4 83

21 LARS KRUSE

24. P. MADSEN.



© 2020

Lloyd's Register  
Foundation