


29 AUG 1923

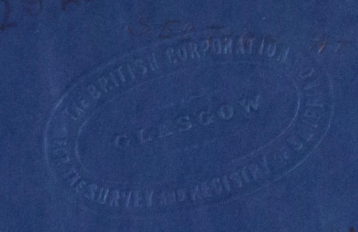

Handwritten:
4th June 1923
E. L. 1923



FOR OTHER DIMENSIONS SEE MIDSHIP SECTION.

ANTJESELSKABET
AALBORG SKIBSVÆRFT
SKITSE AF LUGEENDEBÆLKER
LUGE NO 2
REV. 23-8-23 11189
NR. 20



Lloyd's Register
Foundation






003321-003327-0039

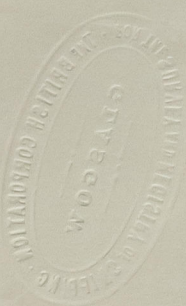

© 2020

Lloyd's Register
Foundation