


North of Ireland S.B. Co.









Nº 58 A

Midship Section (amended)

S.S. Keynote

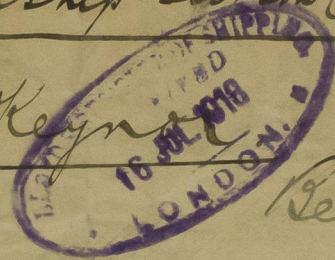

Ref 7599.

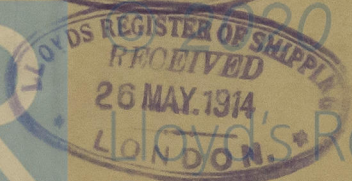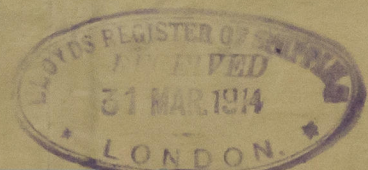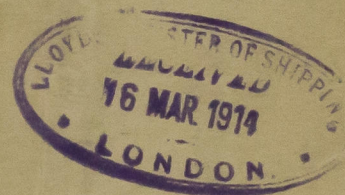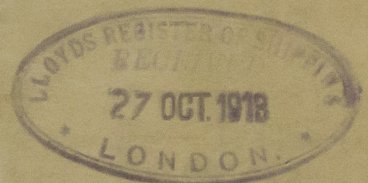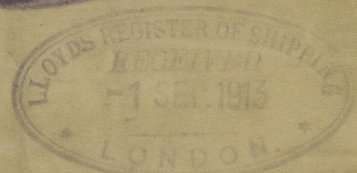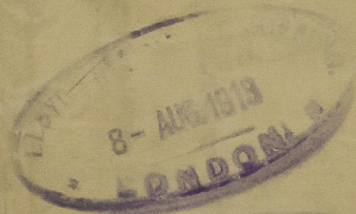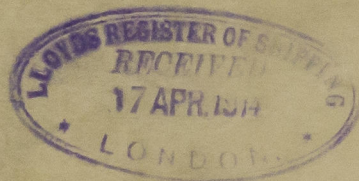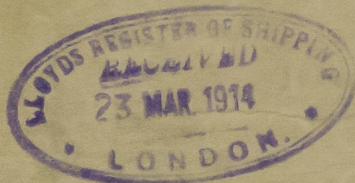

Lloyd's Register
Foundation