



**BULB ANGLES
1924 STANDARD**

 

APPROVED
LLOYD'S REGISTER OF SHIPPING
A. Dickenson
DATE 28.11.32

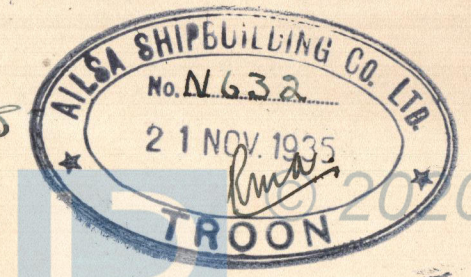

Lloyd's Register
3321-003327-0204

Messrs. Milne & B Co Ltd

Yard No 421/2


Stem Construction and
Aft End Framing Sections

No. 421:- "THE PRESIDENT."

GLASGOW REPORT No. 56986

No. 422:- "THE EARL."

GLASGOW REPORT No. 57137

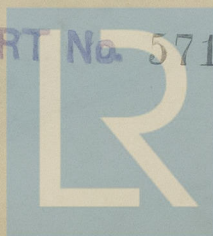

© 2020

Lloyd's Register
Foundation