

S.S. No. 421-2

LONGITUDINAL SECTION & DECK PLANS.

SCALE 1/8" = 1 FOOT.

TO CLASS LLOYDS 100. A1.


DIMENSIONS: 199'6" x 32'0" x 14'6" TO UPPER DK. 18'6" TO QUARTER DK.

No. 421- "THE PRESIDENT"

LLOYDS NUMERALS:

L	199.5
B	32.0
D	14.5
d TO UPPER DECK.	12.0
d " QUARTER "	16.0
d " " " B SPACE	17.0
d " " " E SPACE	13.5 APPROX.
1/2 TO UPPER DECK.	13.76
1/2 " QUARTER "	10.79
L x D	2892.75
L x (B + D)	9216.75

(Windlass, Winches, Masts, etc.
supported to surveyor's satisfaction)

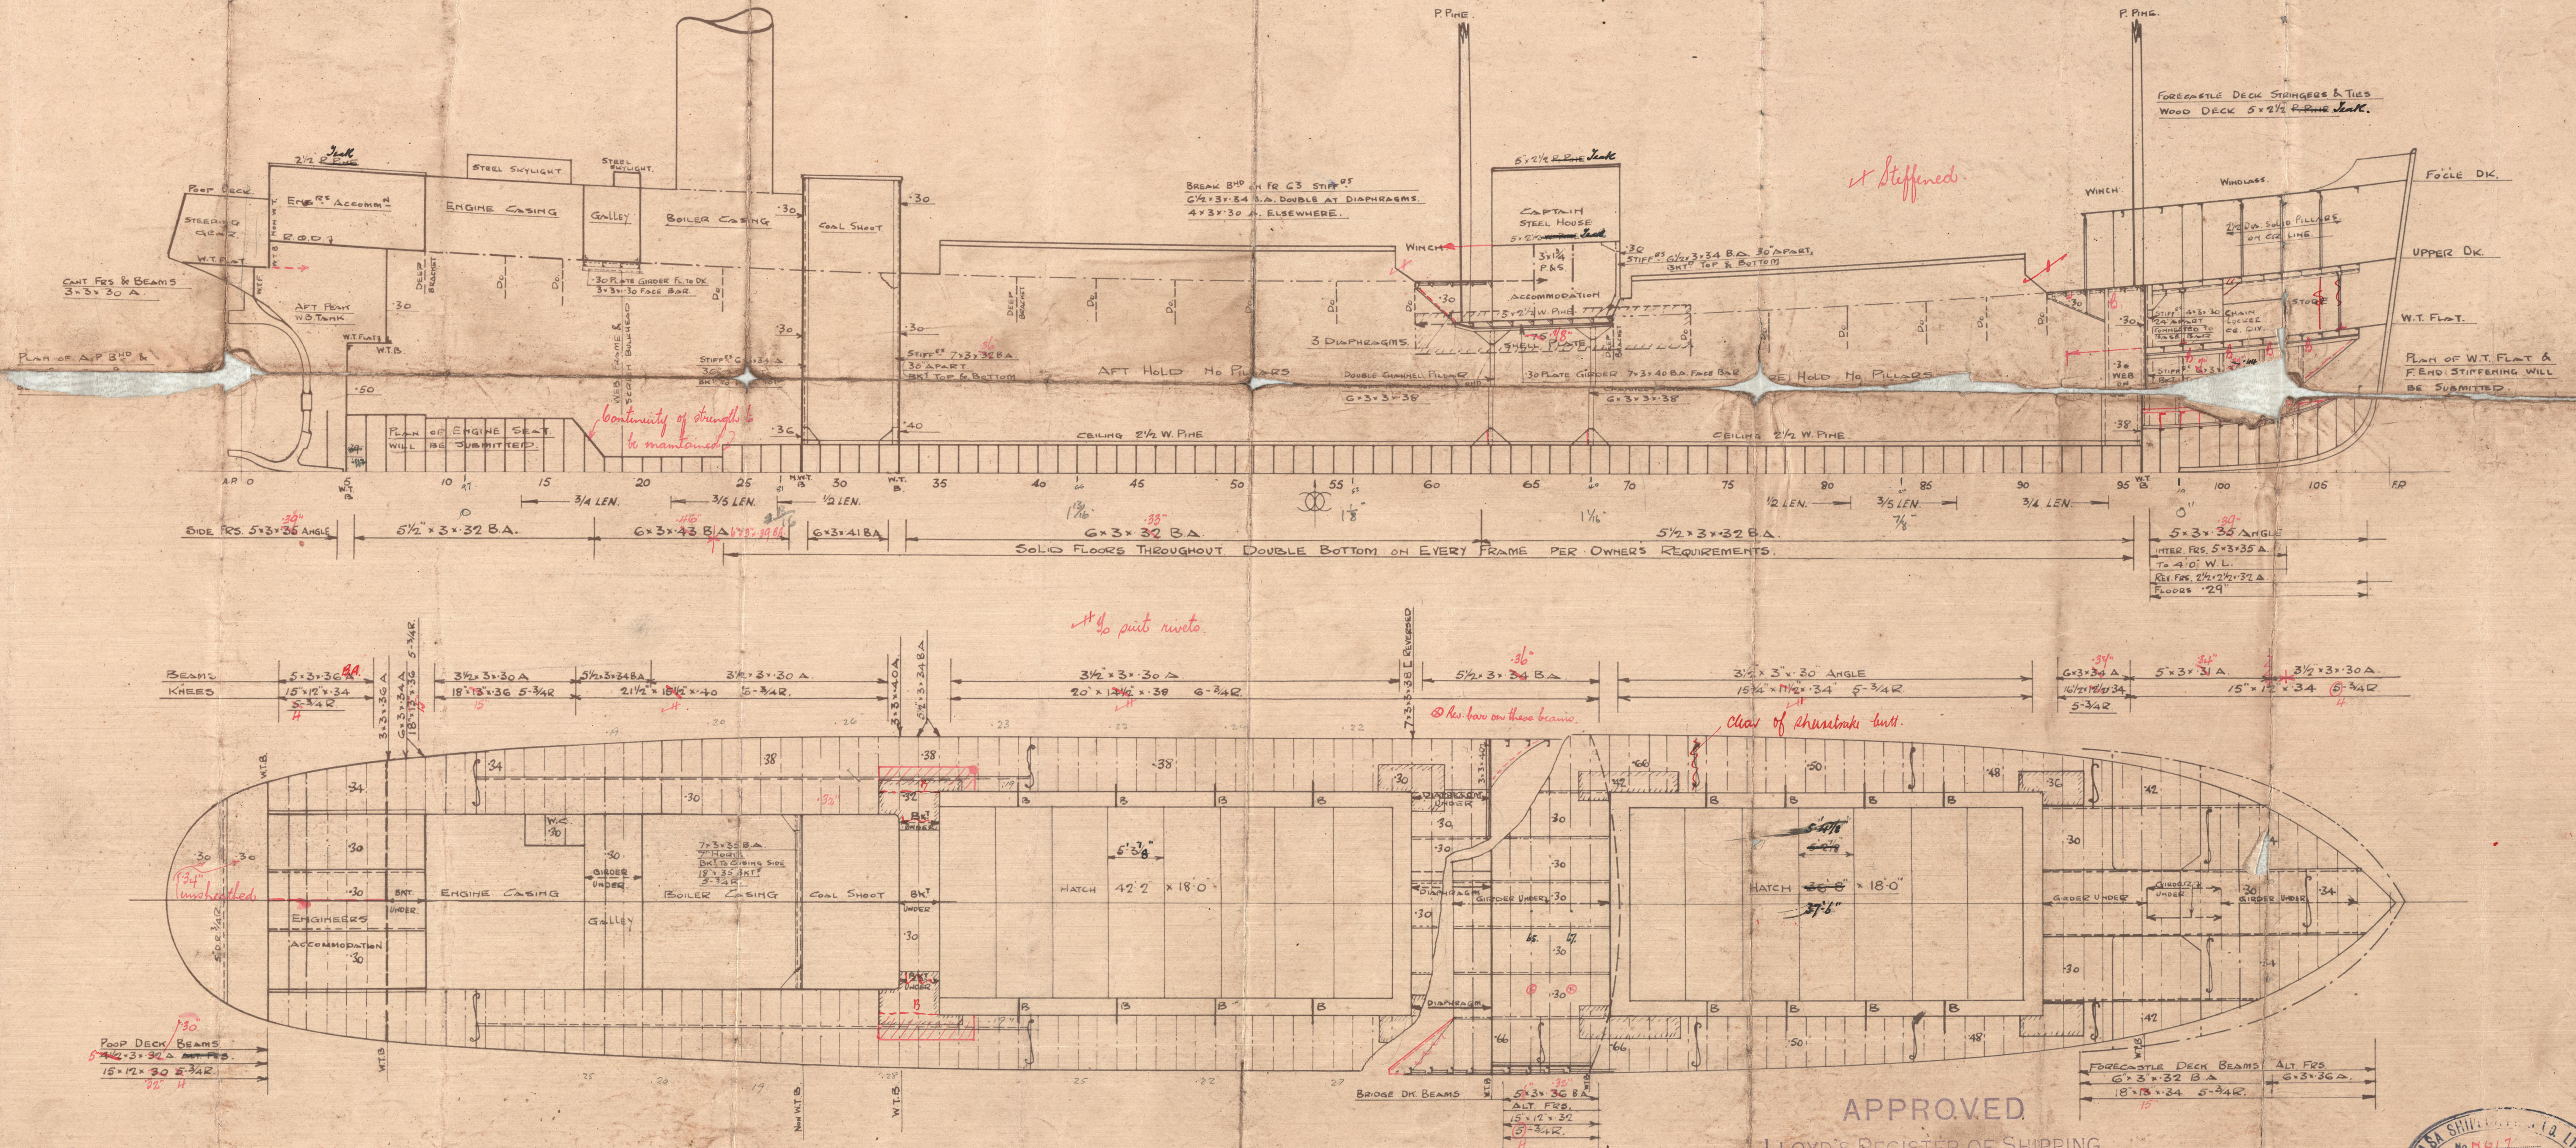

APPROVED
LLOYD'S REGISTER OF SHIPPING
H. J. HARRISON
DATE 30.10.35



Messrs. A. & S. B. Co. Ltd.

Yard No. 42 1/2.

Profile & Becks.

Primary Freeboard
GLASGOW REPORT No. 56454

Yld
GLASGOW REPORT No. 56918

No. 421:- "THE PRESIDENT."

No. 422:- "THE EARL."

GLASGOW REPORT No. 56986

Yld
GLASGOW REPORT No. 57099
(422)
GLASGOW REPORT No. 57137

003321-003327-0210