

SS RIVER GLENELG


B.H.P. Co. ^{Yard} 1, No 3

MIDSHIP SECTION

AS BUILT

Whyalla F.E. Rpt No 24

RET

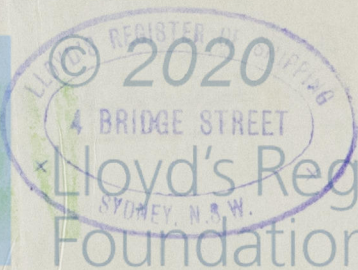

Lloyd's Register
Foundation

003377-003384-0048