


— M.V. "PAUA" —
 (RE-CONSTRUCTION)
 — SHELL EXPANSION —
 — IN WAY OF OIL COMPARTMENTS —
 — SCALE $\frac{1}{4}" = 1 \text{ FOOT}$ —

THE ANGLO-SAXON PETROLEUM CO. LTD

Chesee
MARINE SUPERINTENDENT (C. ZULVER)
NOVEMBER 1938.

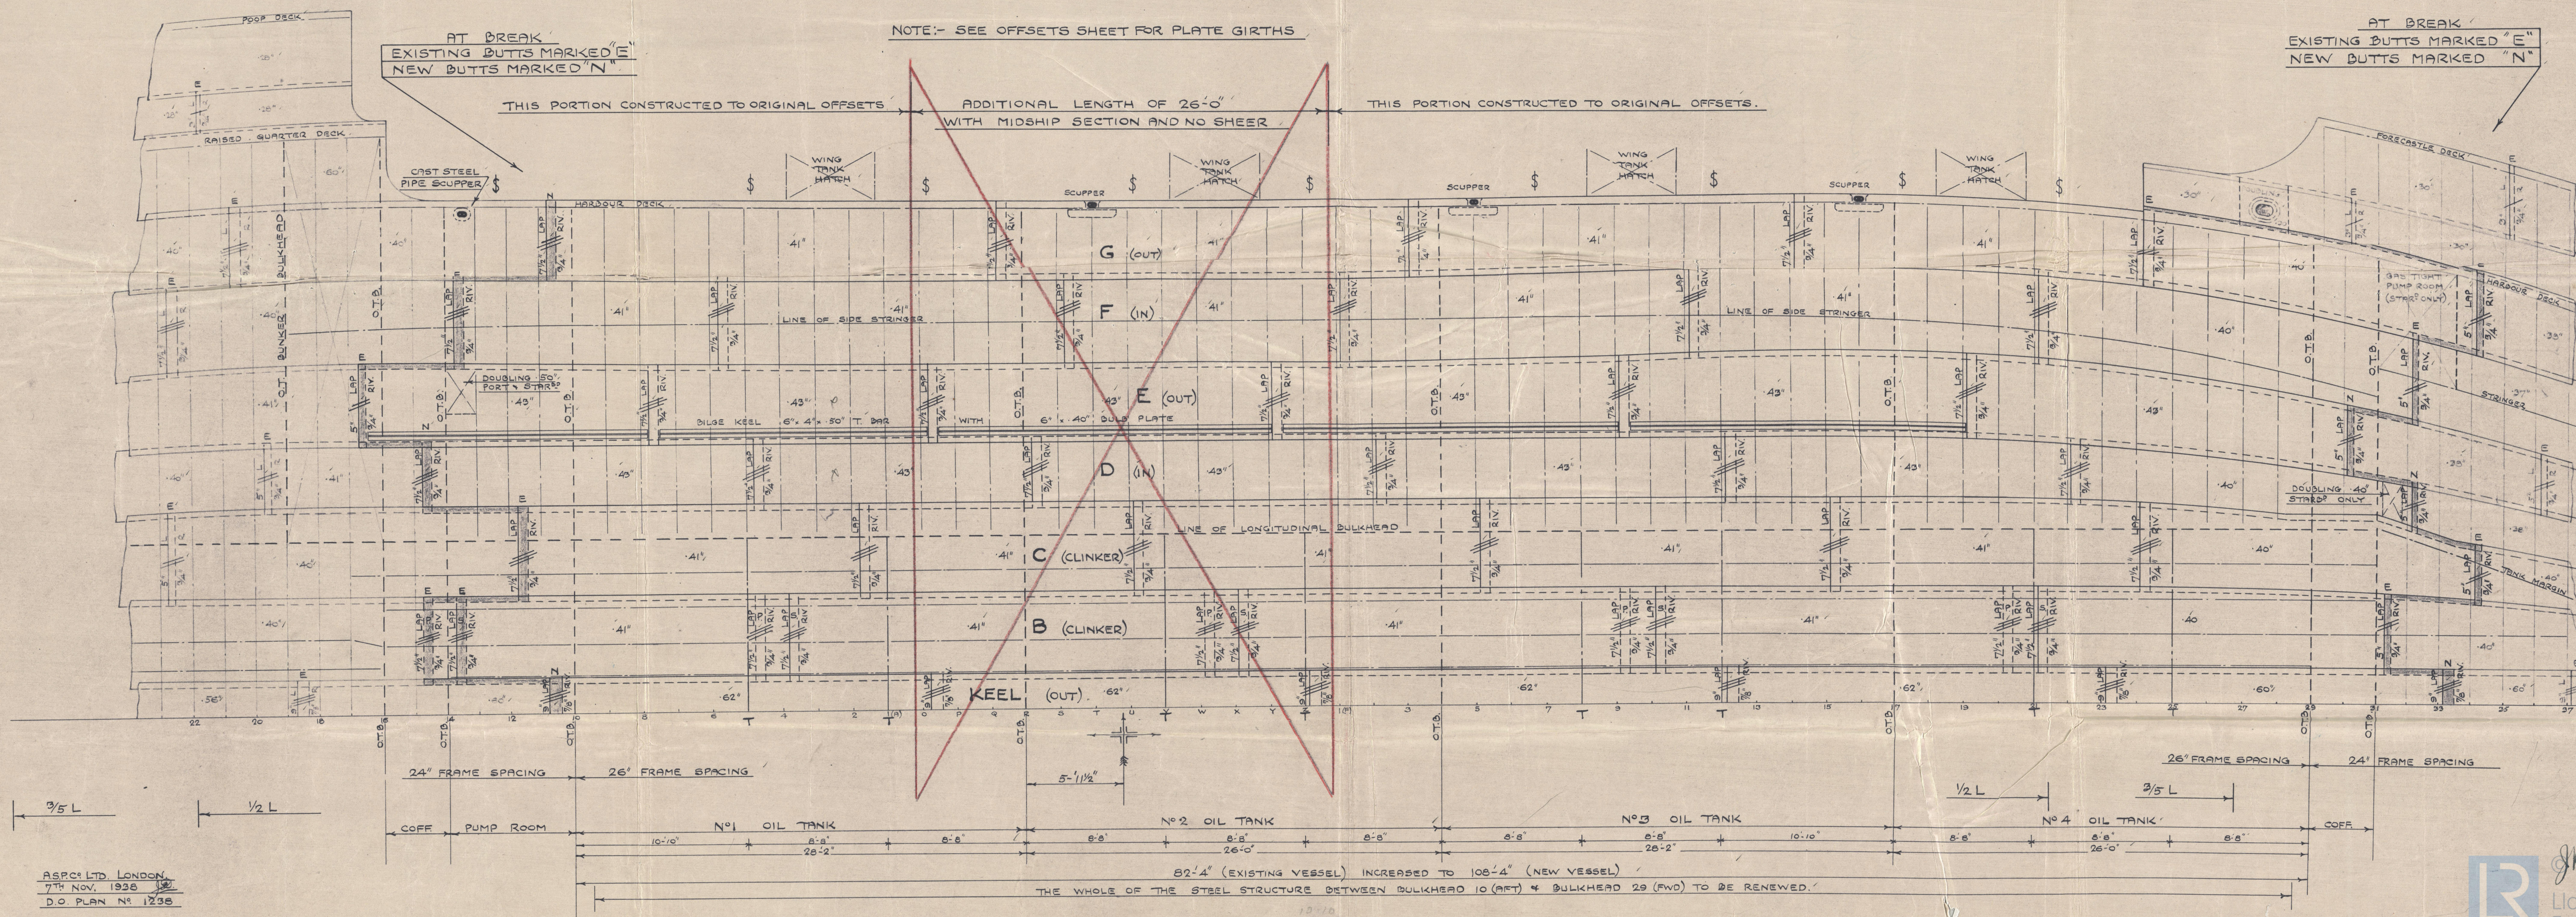

A.S.P.C^o LTD. LONDON.
7TH NOV. 1938
D.O. PLAN N^o: 1238


 003385-003390-0036
 Lloyd's Register
 Foundation

Approved plan (Alteration)

M. J. Pama: H. K. R. M. No
8373

Shell Expansion.

269
104
165



© 2020

Lloyd's Register
Foundation

003385-003390-0036