


Lloyd's Register of Shipping.

5 FEB 1949

Ship's Name "LARGS BAY"

Official No. 137225

Memorandum of alterations reported since ship was surveyed for assignment of Load Lines
in _____

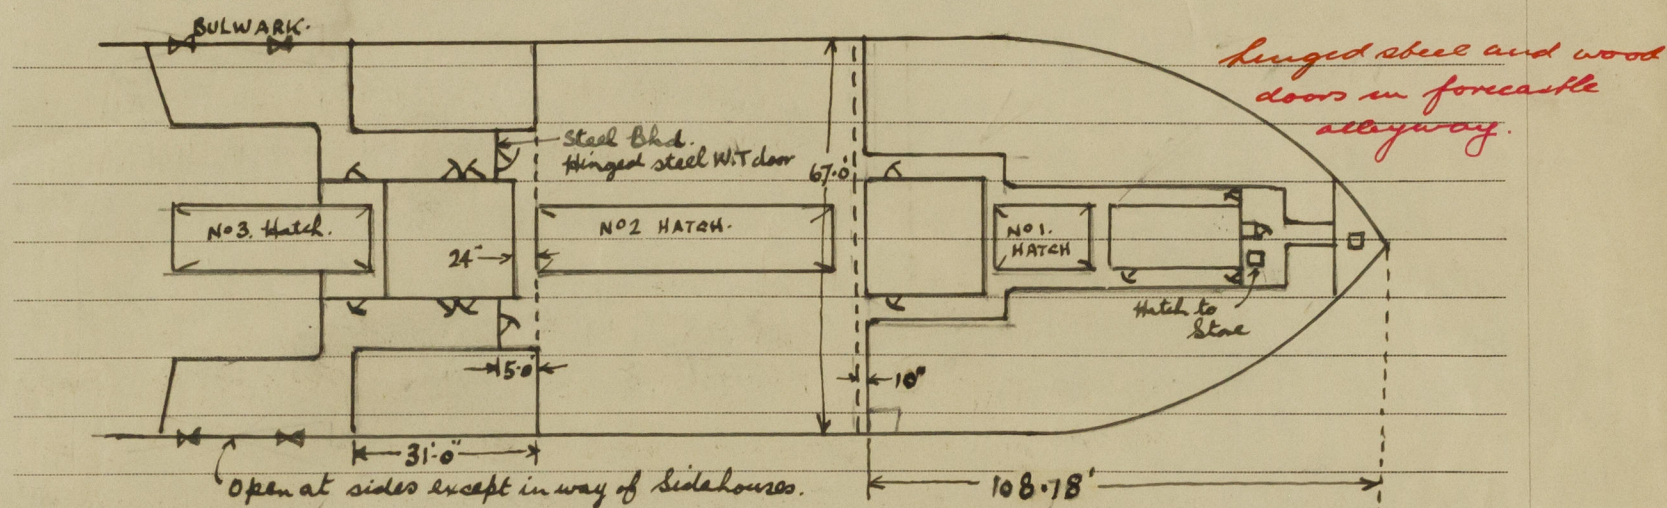

Forecastle

Additional sidehouses have been built abreast original centre deckhouse (P+S) ✓

The fore-castle deck has been extended and is now as shown on sketch above.

An additional small hatchway has been formed on the Upper Deck in the Forecastle (S.S.) for access to Store Room - Opening 2'-6" x 2'-6" - Laming 15" high x 3/8" steel closed by wood covers 2 1/2" thick, 2 tarpaulins, cleats spaced 24" apart, with battens and locking bar. ✓ Forecastle bds plating 30" stiffeners 4" x 3" x 52" L³ welded fore on

Bridge Front

Sidehouses (P. + S) have been extended as shown on sketch above. ✓

Ventilators :- a number of ventilators have been removed & openings efficiently blanked.

Forecastle Deck. Undernoted are particulars of ventilators as now fitted.

1-12" diam. Coaming 36" x 34" to C Deck. /
6-24" " " 36" x 36" to Holdrs. /
2-20" " " 36" x 34" Fresh Top ex from accomm. /
1-15" " " 36" x 34" " " " " " " /

Bridge Deck
5 - 24" dia. Beamings 36" x 36" to holds
1 - 6" " " 36" x 34 to C Deck
4 - 7" dia " 28" x 34 to C Deck
French top.
2 - 14" x 3" " 10" x 36" Fan ex.
from account.

Freeboard Deck

4 - 24" dia. Boaming 36" x .36 to holds.

2 - 15" diam. Cosmings 30" x .36 French Top mech Exhaust from accompn.

Efficient closing appliances are provided for all ventilators.

Ship's Side Doors.

The following doors have been removed & the openings in the shell plating efficiently blanked.

4. W.T. Doors (P+S) - 5'-7" x 3'-3" between freeboard + "C" decks.

1. W.T. Door (P+S) - 6'-2" x 5'-0" D° D° D°

2. Coal Doors (S) + 1 Coal Door (P.) 2'-11" x 2'-8" between freeboard + "C" Decks. /

Hatch Covers.

One section of grating covers is now fitted at Nos. 3, 4 & 5 hatches.

Side Scuttles

Portable plug deadlights are now fitted in Nos 3 & 4 Passenger sections below freeboard deck.

These sitters have been fitted thus for about 28 years.

James E. Brown

5m, 7, 42. T.

003385-003390-0211