

Lloyd's Register of Shipping.

SURVEYS FOR FREEBOARD.


(CONDITIONS OF ASSIGNMENT.)

Index No. _____
(For London Office only.)

Dundee Report No. 9904.


Ship's Name EDDYREEF Port of Survey DUNDEE
Official Number _____ Surveyor's Signature J. Miller
Nationality and Port of Registry BRITISH - LONDON Date of Survey DURING CONSTRUCTION

Disposition and dimensions of superstructures, trunks, deckhouses and machinery casings to be inserted in the diagrams and tabular statement:—

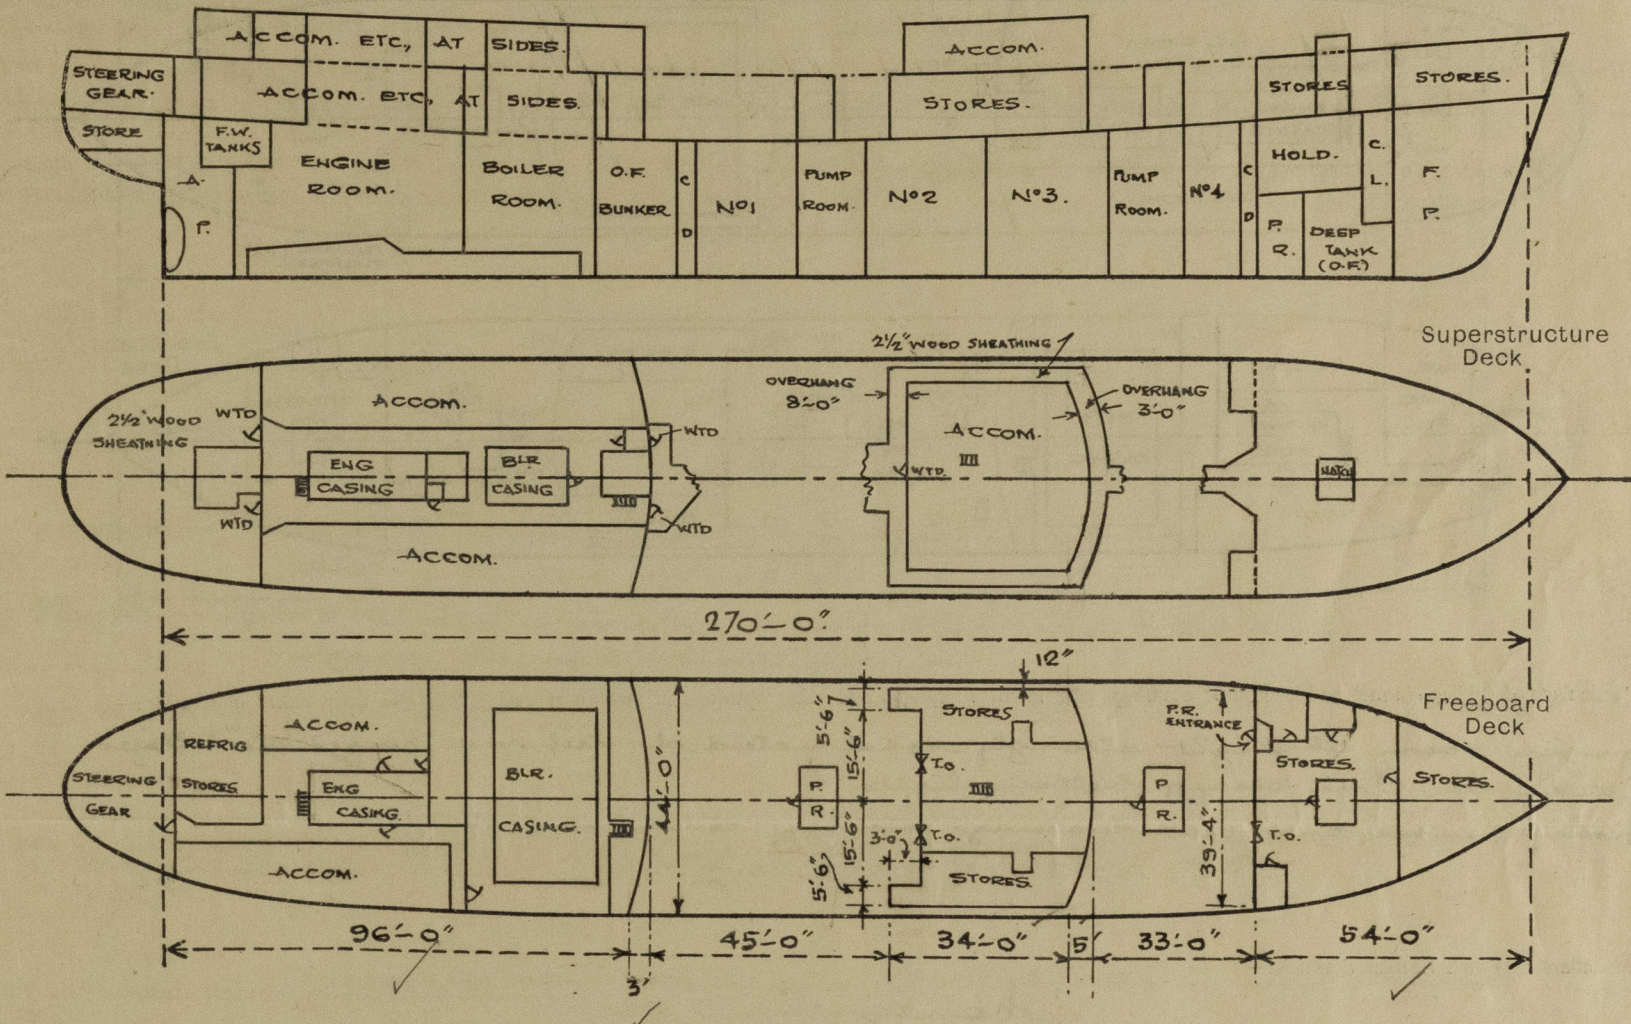

Particulars of Superstructures, Trunks, Casings, Deckhouses.								
	Coaming	Plating	Stiffeners	Spacing	End Attachments of Stiffeners	Size of Openings	Height of Sills	Height of Casings
Poop Bulkhead ...	36" ✓	36" ✓	7" 3" x 38" BA ✓	26 1/2" - 28 1/2" ✓	NONE ✓	NONE ✓	✓	7'-9" ✓
Raised Quarter Deck Bulkhead ...	✓							
Bridge, After Bulkhead ...	25" ✓	25" ✓	4" 3" x 28" OA ✓	30" - 36" ✓	NONE ✓	2 AT 4'-0 1/2" x 3'-0 1/2" ✓	22" ✓	7'-9" ✓
Bridge, Forward Bulkhead ...	35" ✓	35" ✓	6" 3" x 56" BA ✓	22" - 26 1/2" ✓	LUGGED T. & B. ✓	NONE ✓	✓	7'-9" ✓
Forecastle Bulkhead ...	30" ✓	30" ✓	4" 3" x 40" OA ✓	26" - 33" ✓	NONE ✓	1-5'-0" x 4'-0" 1-3'-0" x 2'-0" ✓	18" 24" ✓	7'-0" ✓
Trunk, Aft ...	✓							
Trunk, Forward ...	✓							
Exposed Machinery Casings on Freeboard or Raised Quarter Decks ...	25" ✓	25" ✓	3" 3" x 30" OA ✓	26" - 36" ✓	NONE ✓	1-4'-0" x 2'-0" EACH CASING ✓	24" ✓	7'-9" AFT 7'-6" FWD ✓
Exposed Machinery Casings on Superstructure Decks ...	✓							
Machinery Casings within Superstructures not fitted with Class I Closing Appliances ABOVE POOP DECK ...	20" ✓	20" ✓	3" x 2 1/2" x 26" ✓	29" - 32" ✓	NONE ✓	2 AT 5'-3" x 2'-2" ✓	15" & 12" ✓	7'-6" ✓
Deckhouses on Flush Deck Ships ...	✓							
Particulars of Closing Appliances (state if capable of being manipulated from both sides).								
Poop Bulkhead ...	NO OPENINGS. ✓							
Raised Quarter Deck Bulkhead ...	✓							
Bridge, After Bulkhead ...	PORTABLE STEEL PLATES WITH HOOK BOLTS & STEEL HINGED W.T. DOOR 3'-0" x 2'-0" FITTED IN PLATES & OPERATED BOTH SIDES. ✓							
Bridge, Forward Bulkhead ...	NO OPENINGS. ✓							
Forecastle Bulkhead ...	PORTABLE STEEL PLATE WITH HOOK BOLTS & STEEL HINGED W.T. DOOR 4'-0" x 2'-0" FITTED IN PLATE & OPERATED BOTH SIDES. 1-STEEL HINGED W.T. DOOR, OPERATED BOTH SIDES. ✓							
Exposed Machinery Casings on Freeboard or Raised Quarter Decks ...	1-STEEL HINGED W.T. DOOR TO EACH CASING, OPERATED BOTH SIDES. ✓							
Exposed Machinery Casings on Superstructure Decks ...	✓							
Machinery Casings within Superstructures not fitted with Class I Closing Appliances ABOVE POOP DECK ...	STEEL HINGED W.T. DOORS, OPERATED BOTH SIDES. ✓							
Deckhouses on Flush Deck Ships ...	✓							

PARTICULARS OF PROTECTION TO OPENINGS, ETC.

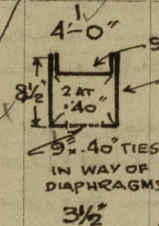HATCHWAYS ON FREEBOARD AND SUPERSTRUCTURE DECKS.												
			← F&D DECK	apt	→ F. DECK					POOP D.K.	POOP D.K.	
Description of Hatchway			CARGO HATCHES O.T. 14 OFF	F. & A. COFFERDAMS 1 OFF BA.	O.F. BUNKERS 3 OFF	HATCH TO ENG'RS STORE	HATCH TO CHAIN LOCKER	CARGO HATCH.	HATCH TO FOGLE STORE.	HATCH TO BALLAST PUMP ROOM	HATCH TO MAGAZINE	HATCH TO STORE.
Dimensions of Hatchway			36" DIA.	21'x15"	21'x15"	2'-0"x1'-9"	2'-0"x2'-0"	8'-0"x8'-0"	24" DIA.	18" DIA.	2'-0"x2'-6"	3'-0"x2'-6"
COAMINGS	{	Height above Deck	30"✓	9"x3"x50"	9"x3"x50"	3"	12"✓	30"✓	30"✓	7"✓	18"✓	18"✓
		Thickness { Sides40"	WELDED	WELDED	3"✓	.30"✓	.44"✓	.40"	.40"✓	.30"✓	.30"✓
		Stiffeners	✓	TOE	TOE	3"✓	.30"✓	.44"✓	✓	✓	✓	✓
		Brackets, Stays	✓	ON.	ON.	.30"✓	✓	7"x3"x40" BA.	✓	✓	✓	✓
HATCH BEAMS	{	Number	/	/	/	/	/		/	/	/	/
		Spacing	/	/	/	/	/		/	/	/	/
		Scantling and Sketch	/	/	/	/	/		/	/	/	/
FORE AND AFTERS	{	Bearing Surface	/	/	/	/	/	/	/	/	/	/
		Number	/	/	/	/	/	/	/	/	/	/
		Spacing	/	/	/	/	/	/	/	/	/	/
HATCH COVERS	{	Unsupported Lengths	/	/	/	/	/	/	/	/	/	/
		Scantling* and Sketch	/	/	/	/	/	/	/	/	/	/
		Bearing Surface	/	/	/	/	/	/	/	/	/	/
HATCH COVERS	{	Material	STEEL	STEEL	STEEL	W.P.	STEEL	STEEL	STEEL	STEEL	STEEL	STEEL
		Thickness50"	.50"	.50"	2 1/2"	.25"	.50"	QUICK	QUICK	.30"	.30"
		How fitted	HINGED	BOLTED	BOLTED	F. & A.	HINGED	HINGED	CLOSING	CLOSING	HINGED	HINGED
		Bearing Surface	O.T.	W.T.	O.T.	2 1/2"	W.T.	W.T.	W.T.	W.T.	W.T.	W.T.
Spacing of Cleats			2 HINGES & 7 TOGGLES	3 1/4" BOLTS ABOUT	3 1/4" BOLTS ABOUT	✓	2 HINGES & 6 TOGGLES	TOGGLES 19 1/2" x 21 3/4" APART.	✓	✓	TOGGLES 18" APART.	TOGGLES 24" APART.
Number of Tarpaulins... ..			✓	3" APART	3" APART.	✓	✓	✓	✓	✓	✓	✓
*Are wood fore and afters steel shod at all bearing surfaces? ✓												
Are battens and wedges efficient and in good condition? ✓												
Are tarpaulins in good condition and in accordance with rule requirements? ✓												
Are lashings provided in accordance with rule requirements? ✓												

Particulars of any special features:—

an escape scuttle 21" dia., is fitted in shell on starboard side aft, constructed of mild steel with 3/8" mild steel cover, having strongback, operated by handwheel in compartment. *with notice plate stating:—"not to be opened except in an emergency."*

Scuttle is fitted 5'-3" above freeboard deck.

